P.P.N 04-00-011-103-008,-010,-028

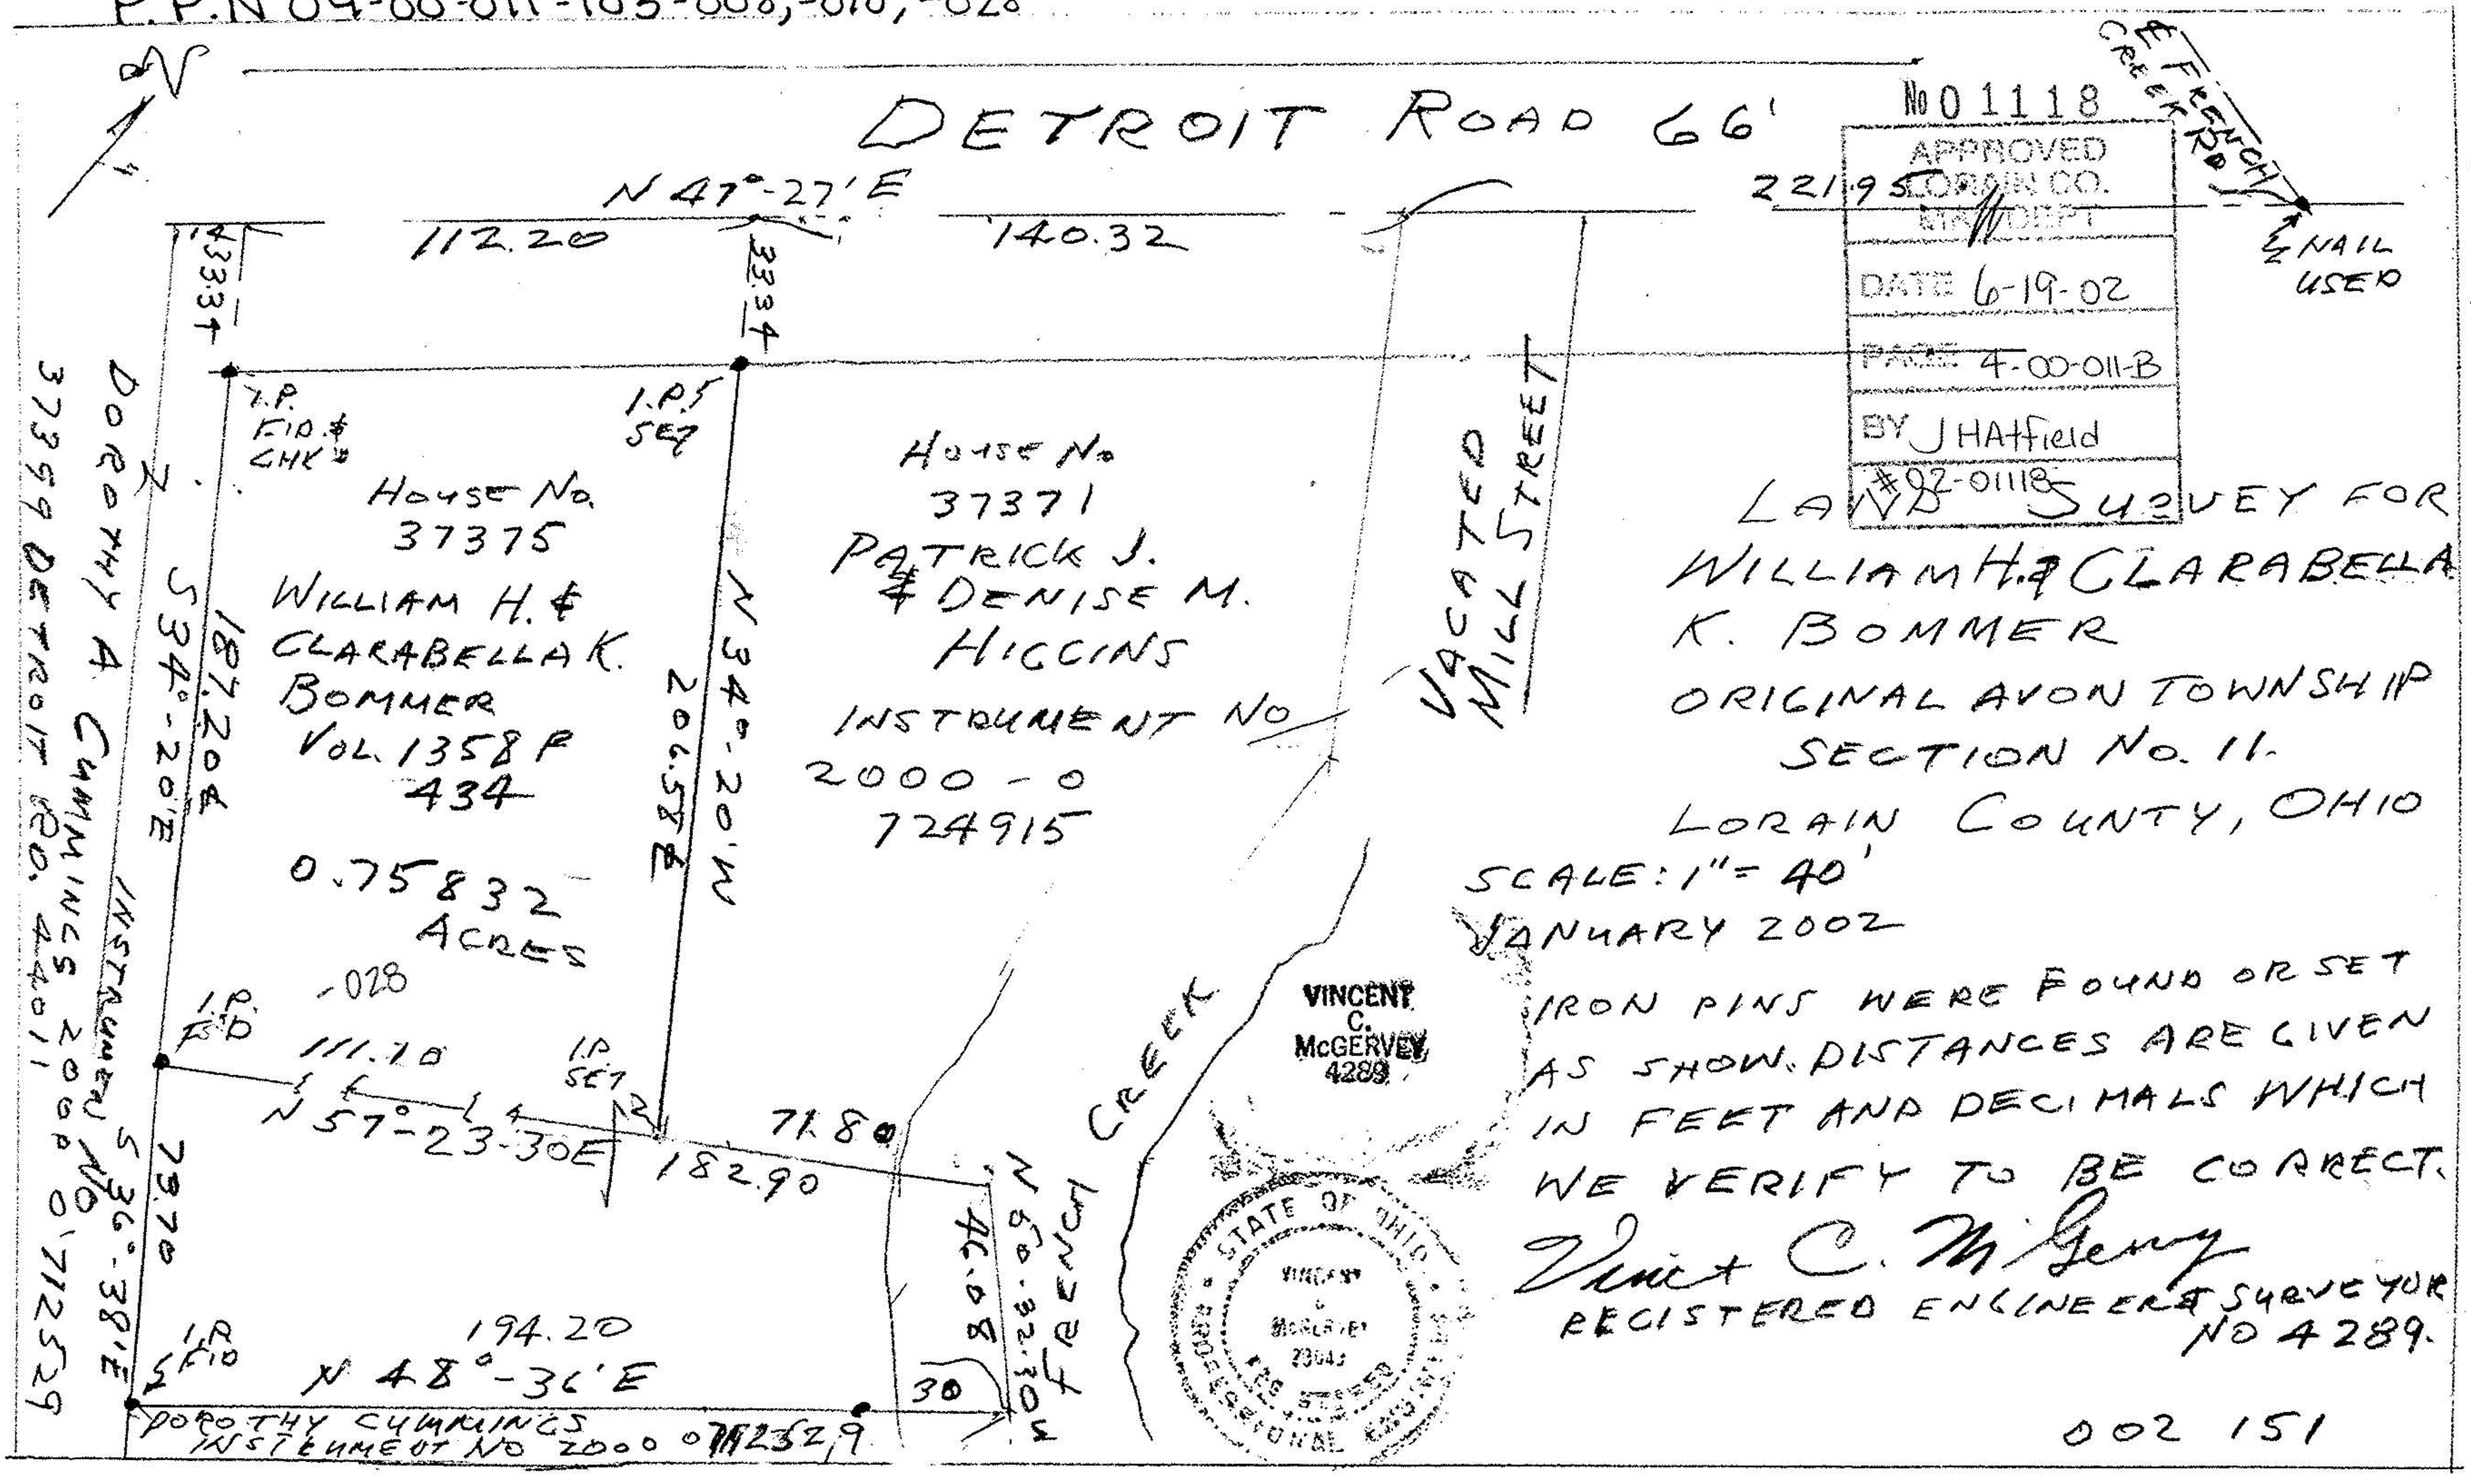

No 01118
APPROVED
LORAIN CO.
MAP DEPT
DATE 6-19-02
PAGE 4-00-011-B
BY J HAtfield
#02-01118

LAND SURVEY FOR
WILLIAM H. & CLARABELLA K. BOMMER
ORIGINAL AVON TOWNSHIP
SECTION No. 11.
LORAIN COUNTY, OHIO

SCALE: 1" = 40'
JANUARY 2002

IRON PINS WERE FOUND OR SET AS SHOW. DISTANCES ARE GIVEN IN FEET AND DECIMALS WHICH WE VERIFY TO BE CORRECT.

Vincent C. McGervey
REGISTERED ENGINEER & SURVEYOR
NO 4289.

VINCENT C. McGERVEY 4289

STATE OF OHIO
VINCENT C. McGERVEY
23043
REGISTERED PROFESSIONAL ENGINEER

002 151