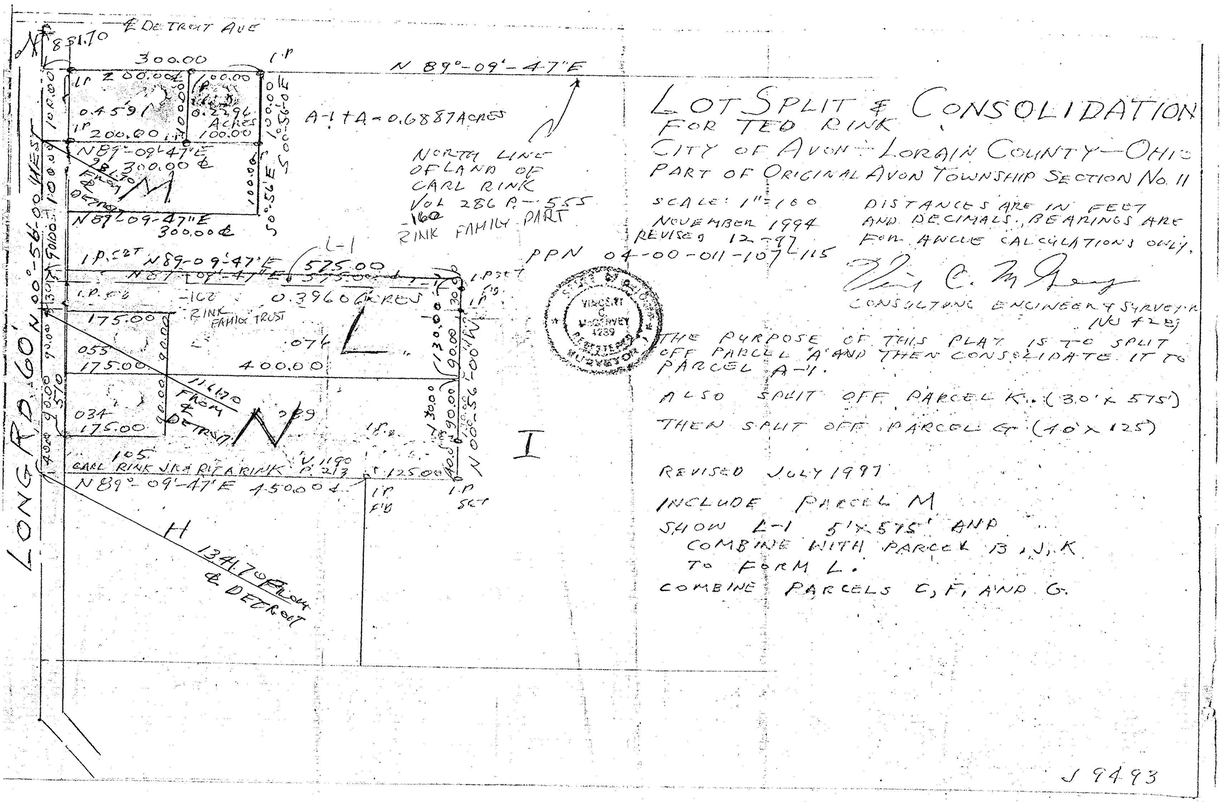

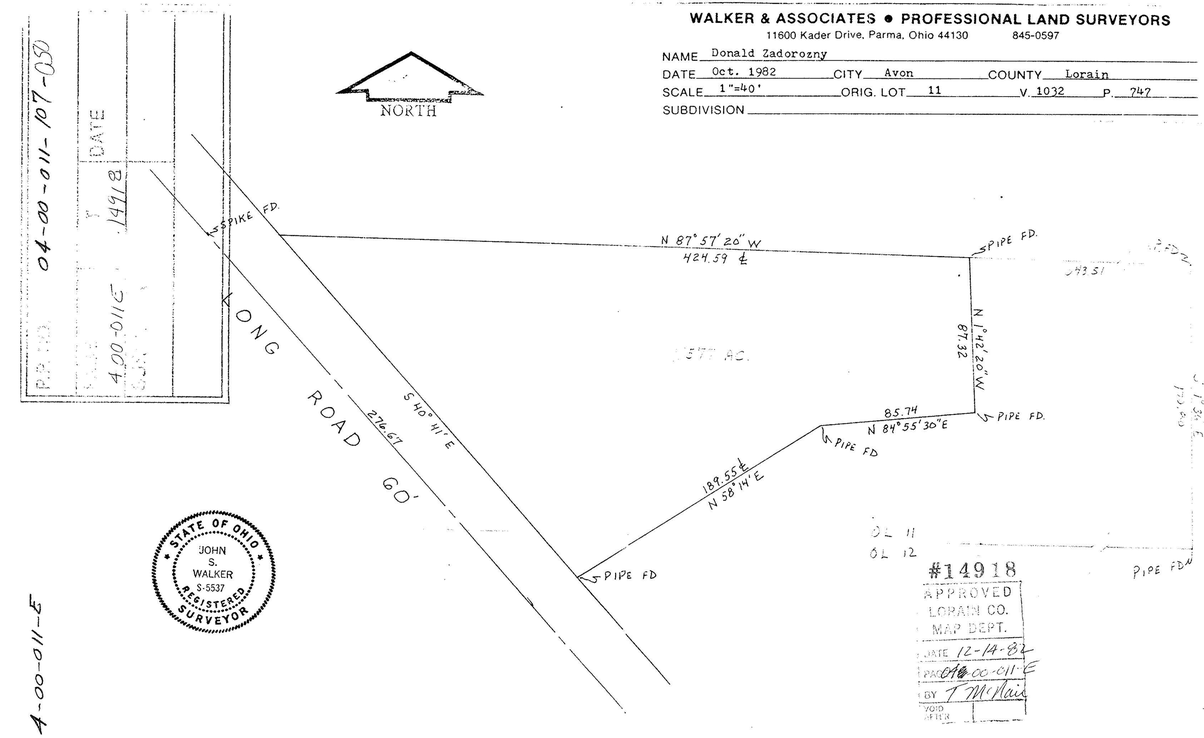

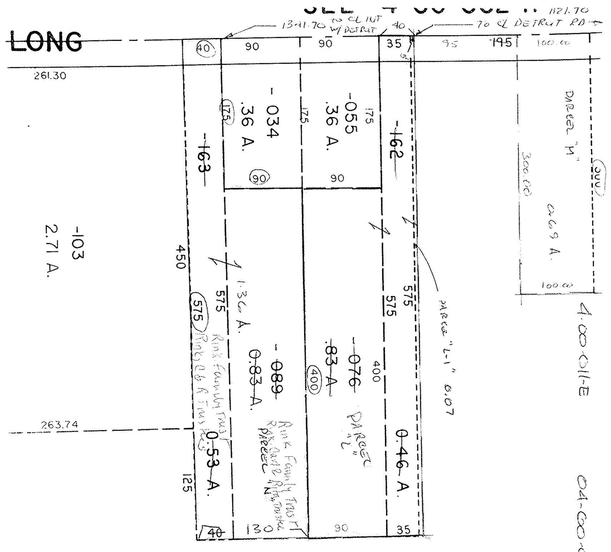

COMBINATION

APPROVED
LORAIN CO.
MAP DEPT.
DATE 4-00-011-E
BY T McPlain
VOID AFTER 22365

#22365