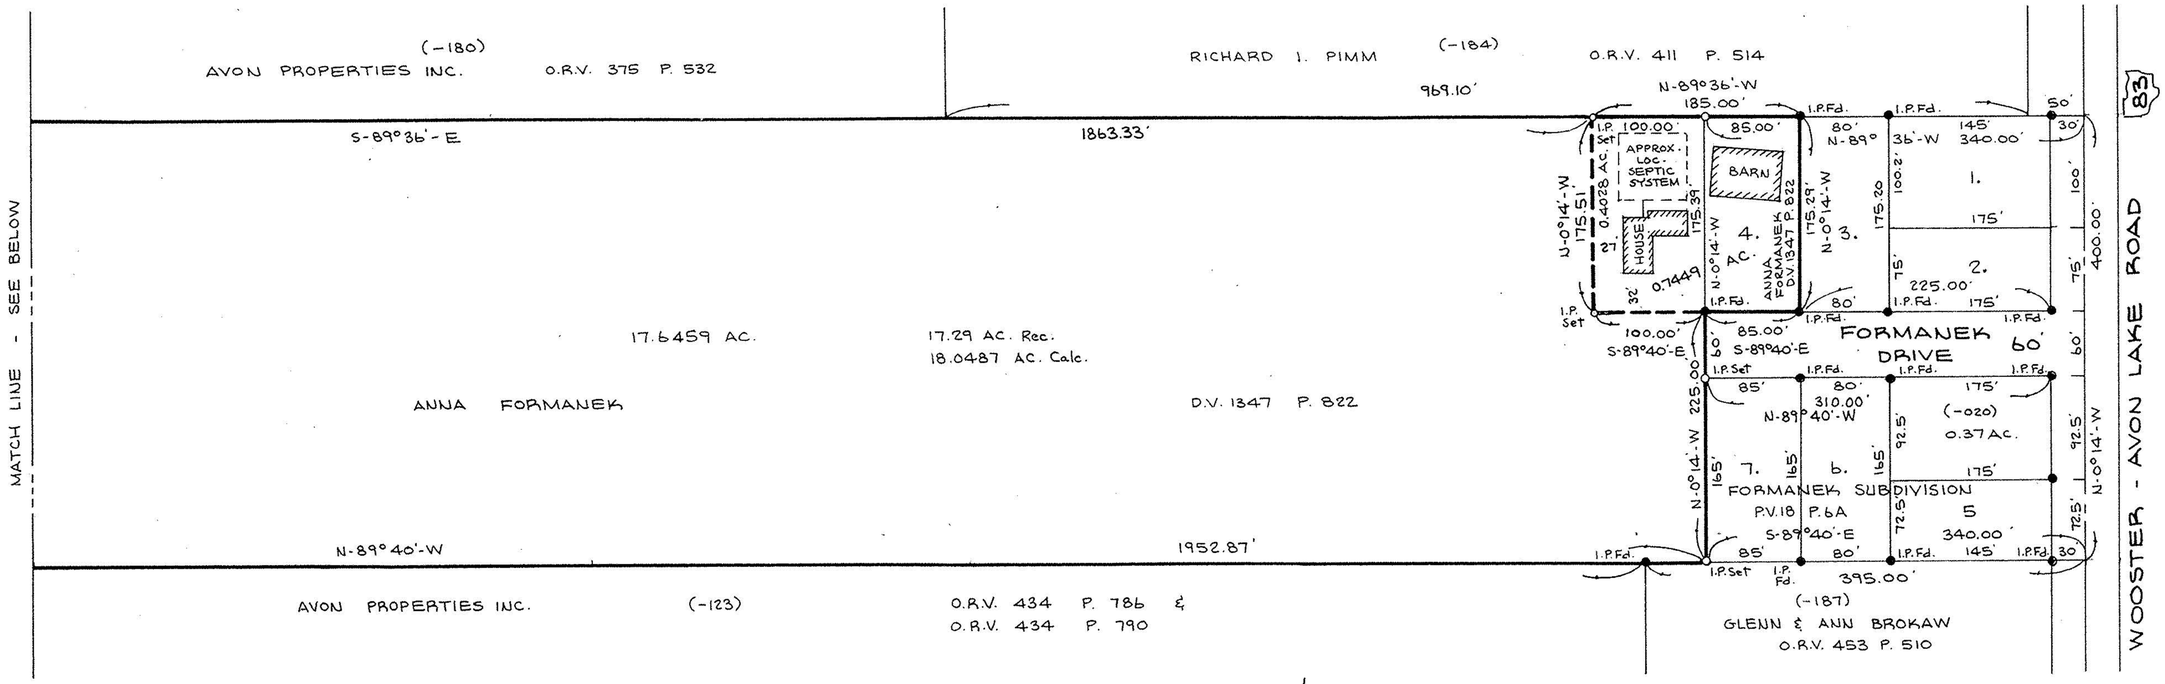

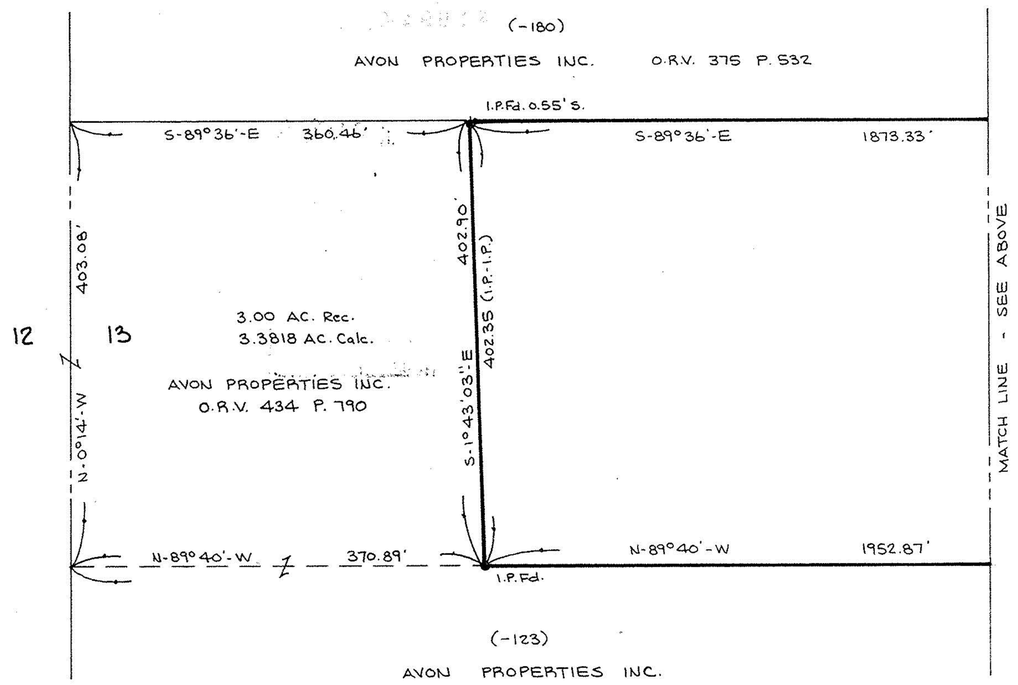

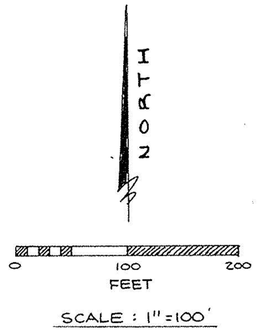

19920

APPROVED
LORAIN CO.
MAP DEPT.
DATE 5-22-92
PAGE 400-013-A&B
BY CAROLYN FRANCIS
VOID AFTER # 19920

04 - 00 - 013 - 000 -

BOUNDARY SURVEY

PART OF AVON TOWNSHIP SECTION 13

CITY OF AVON COUNTY OF LORAIN STATE OF OHIO

PREPARED BY

KS ASSOCIATES INC.
ENGINEERS SURVEYORS

David L. Elwell

DAVID L. ELWELL REG. SURV. NO. 6333
MARCH 31, 1992

92-078