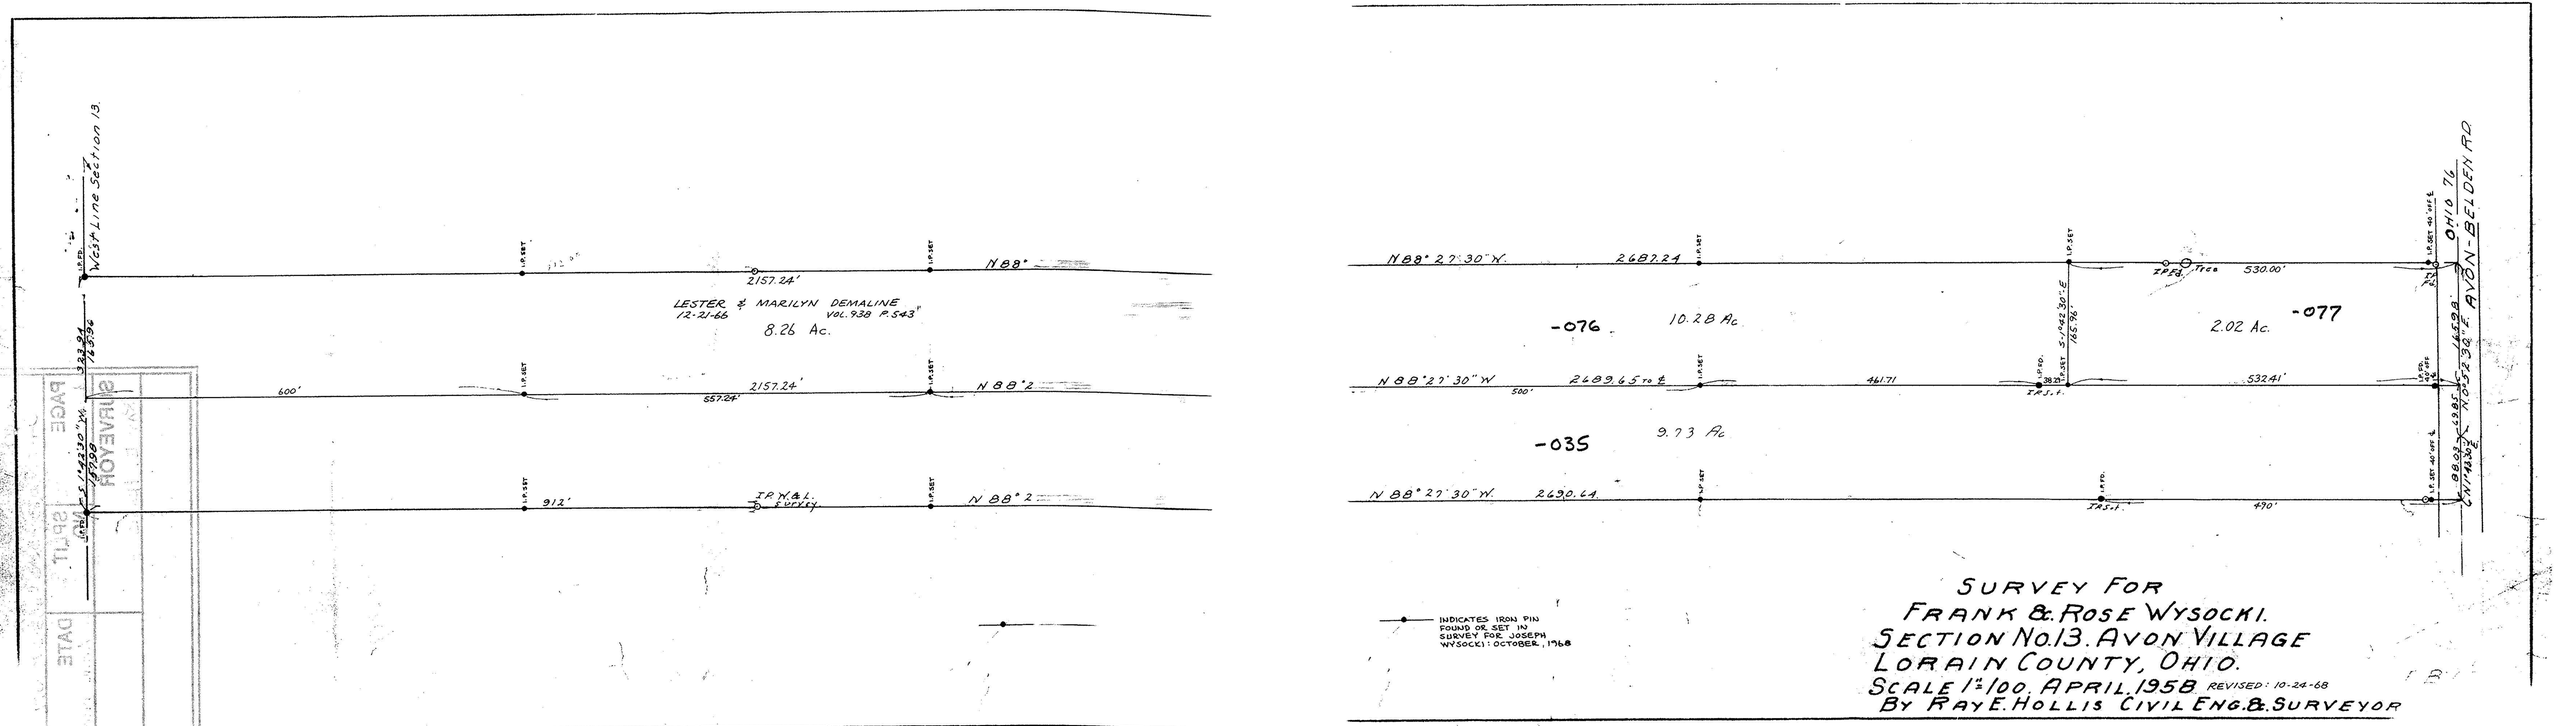
West Line Section 13
N88°
2157.24'
LESTER & MARILYN DEMALINE
12-21-66
VOL. 938 P. 543
8.26 Ac.
600'
557.24'
2157.24'
N88°2
912'
I.P. W.&L. Survey
N88°2
N88°27'30"W.
2687.24
530.00'
-076
10.28 Ac.
2.02 Ac.
-077
N88°27'30"W
2689.65 to ℄
461.71
532.41'
500'
-035
9.73 Ac.
N88°27'30"W.
2690.64
490'
OHIO 76
AVON-BELDEN RD
INDICATES IRON PIN FOUND OR SET IN SURVEY FOR JOSEPH WYSOCKI: OCTOBER, 1968
SURVEY FOR
FRANK & ROSE WYSOCKI.
SECTION No. 13. AVON VILLAGE
LORAIN COUNTY, OHIO.
SCALE 1"=100. APRIL, 1958 REVISED: 10-24-68
BY RAY E. HOLLIS CIVIL ENG. & SURVEYOR