


03-00-100-113-015
OAKWOOD ACRES SUBDIVISION

PEARL AVENUE 80'

EAST 42ND STREET 80'

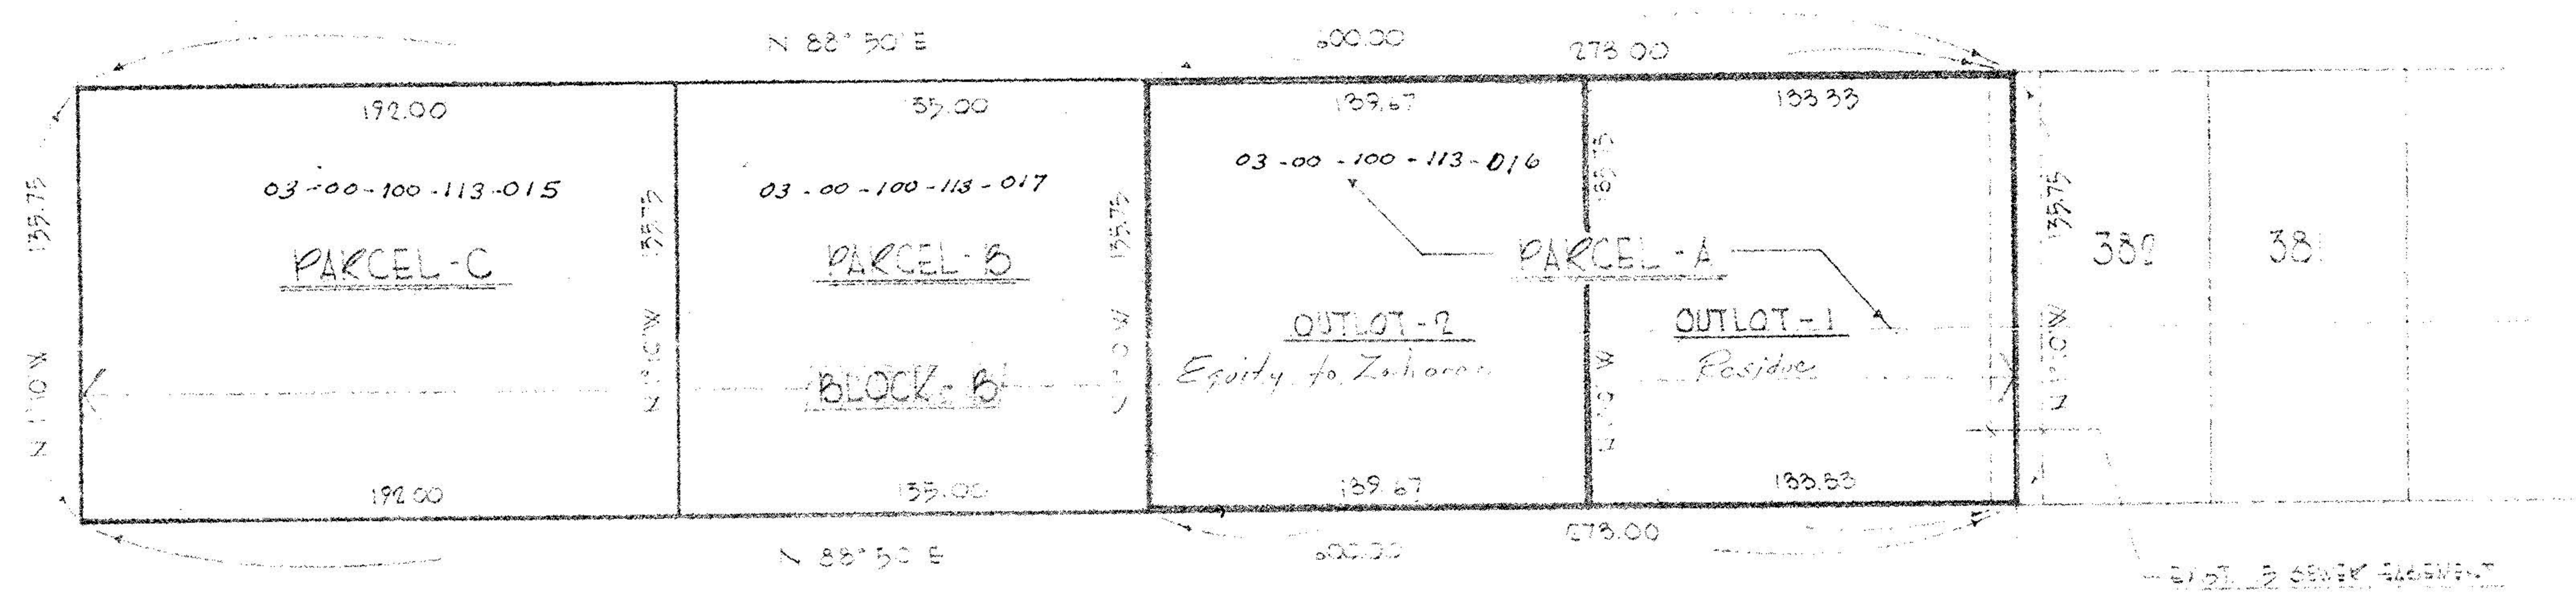

APPROVED
as to description only

F. M. Han

APPROVED BY THE LORAIN CITY PLANNING
COMMISSION NO PLAT REQUIRED
F. M. Han
SECRETARY LORAIN CITY PLANNING COMMISSION

APPROVED	
LORAIN CO.	
MAP DEPT.	
DATE	9-25-78
PAGE	3 of 100 - A
BY	F. M. Han
VOID	
AFTER	

PARCEL SPLIT OF BLOCK-B OF
THE OAKWOOD ACRES SUBDIVISION
NO 5 AS RECORDED IN MAP VOL 24
PG 87 LORAIN COUNTY, OHIO

REVISED SEPT 10, 1978 - PARCEL-A SPLIT

prepared by: norman r. hura
registered surveyor

developer: equity builders
lorain, ohio

February 16, 1978

SCALE: 1"=50'