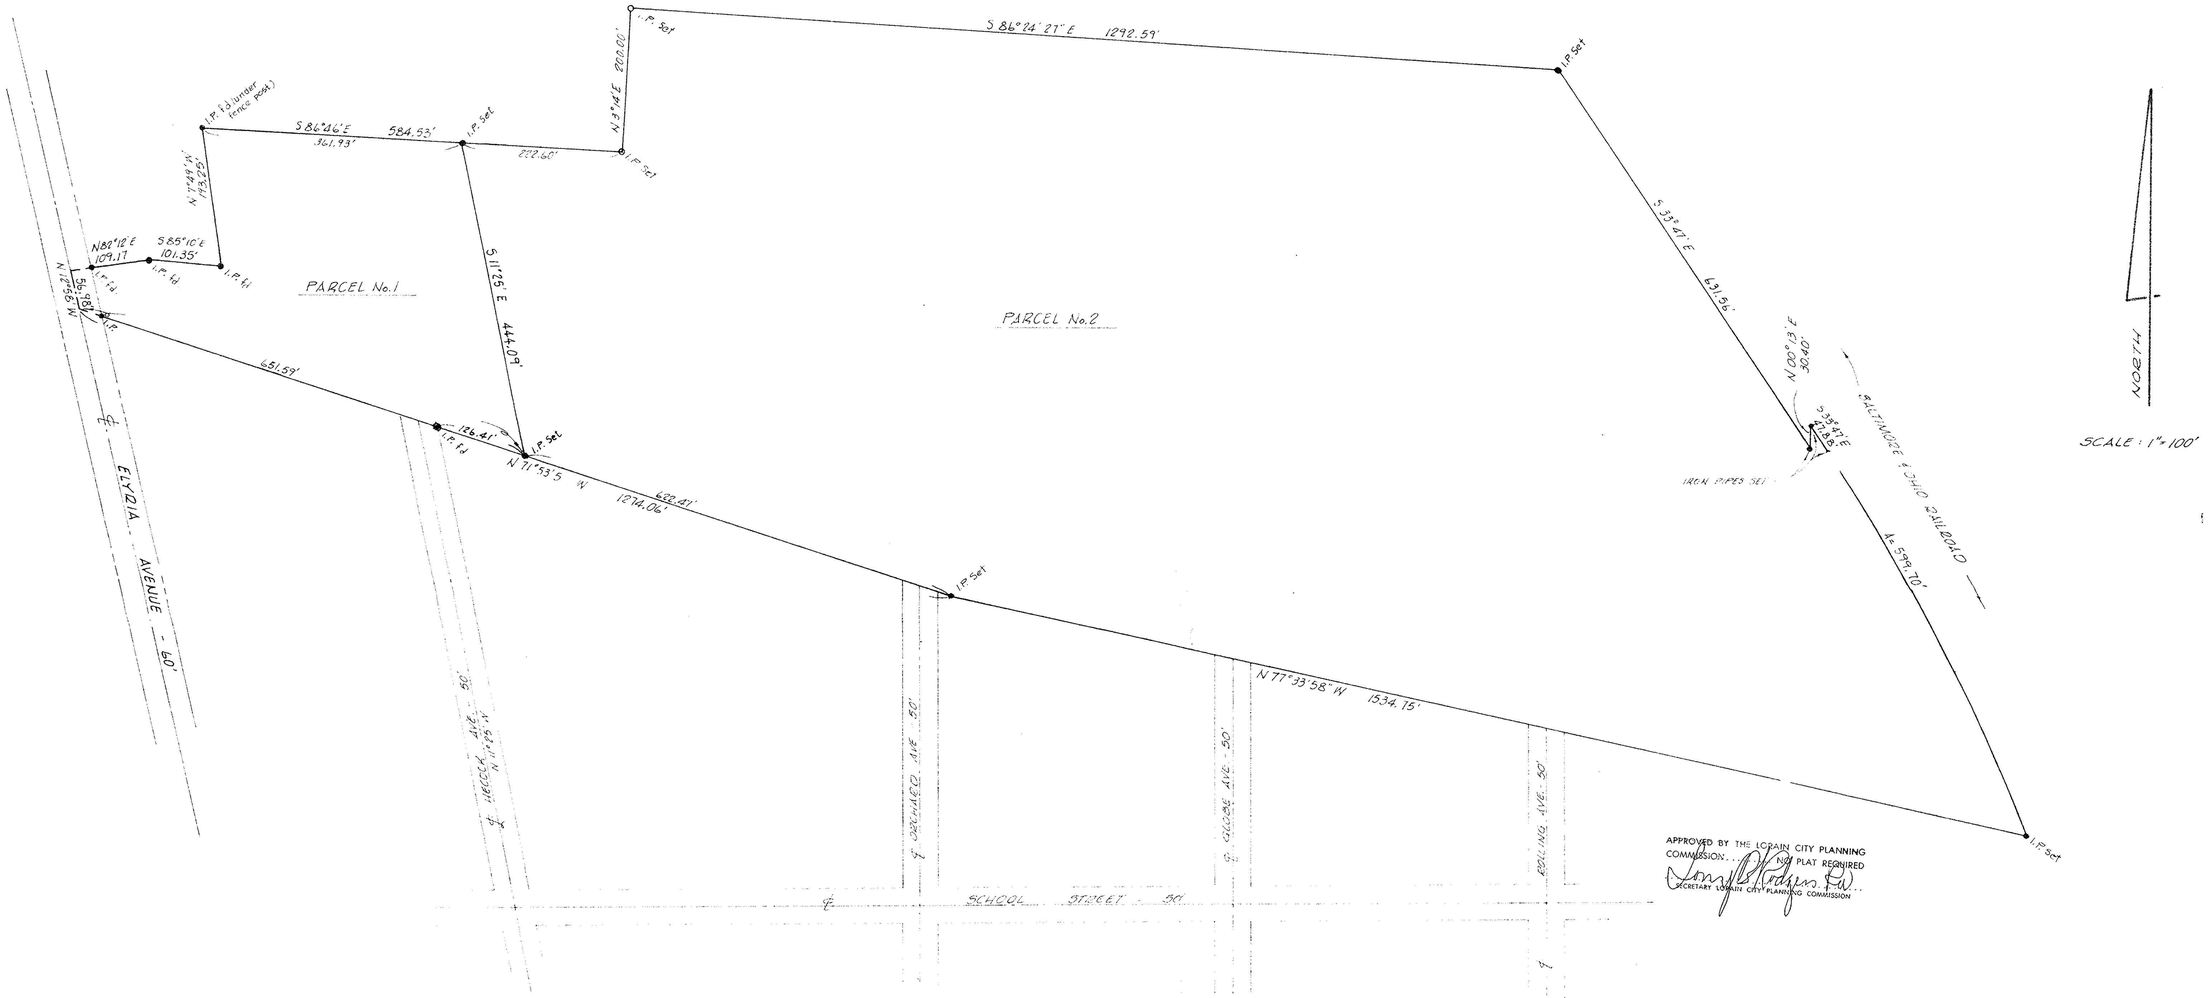

APPROVED BY THE LORAIN CITY PLANNING COMMISSION
NO PLAT REQUIRED
SECRETARY LORAIN CITY PLANNING COMMISSION

MAP of SURVEY
for
ANNA WOSKOBNICK
PART of ORIGINAL LOTS 105, 106, 107, 108 & 109
SHEFFIELD TOWNSHIP, LORAIN COUNTY OHIO

APPROVED
Lowell O'Neill, Engr. Dept.

McGUINCHY and ASSOCIATES
REGISTERED ENGINEERS and SURVEYORS
ELYRIA OHIO
JUNE 30, 1977
REV 7-21-77
JOB # 77203