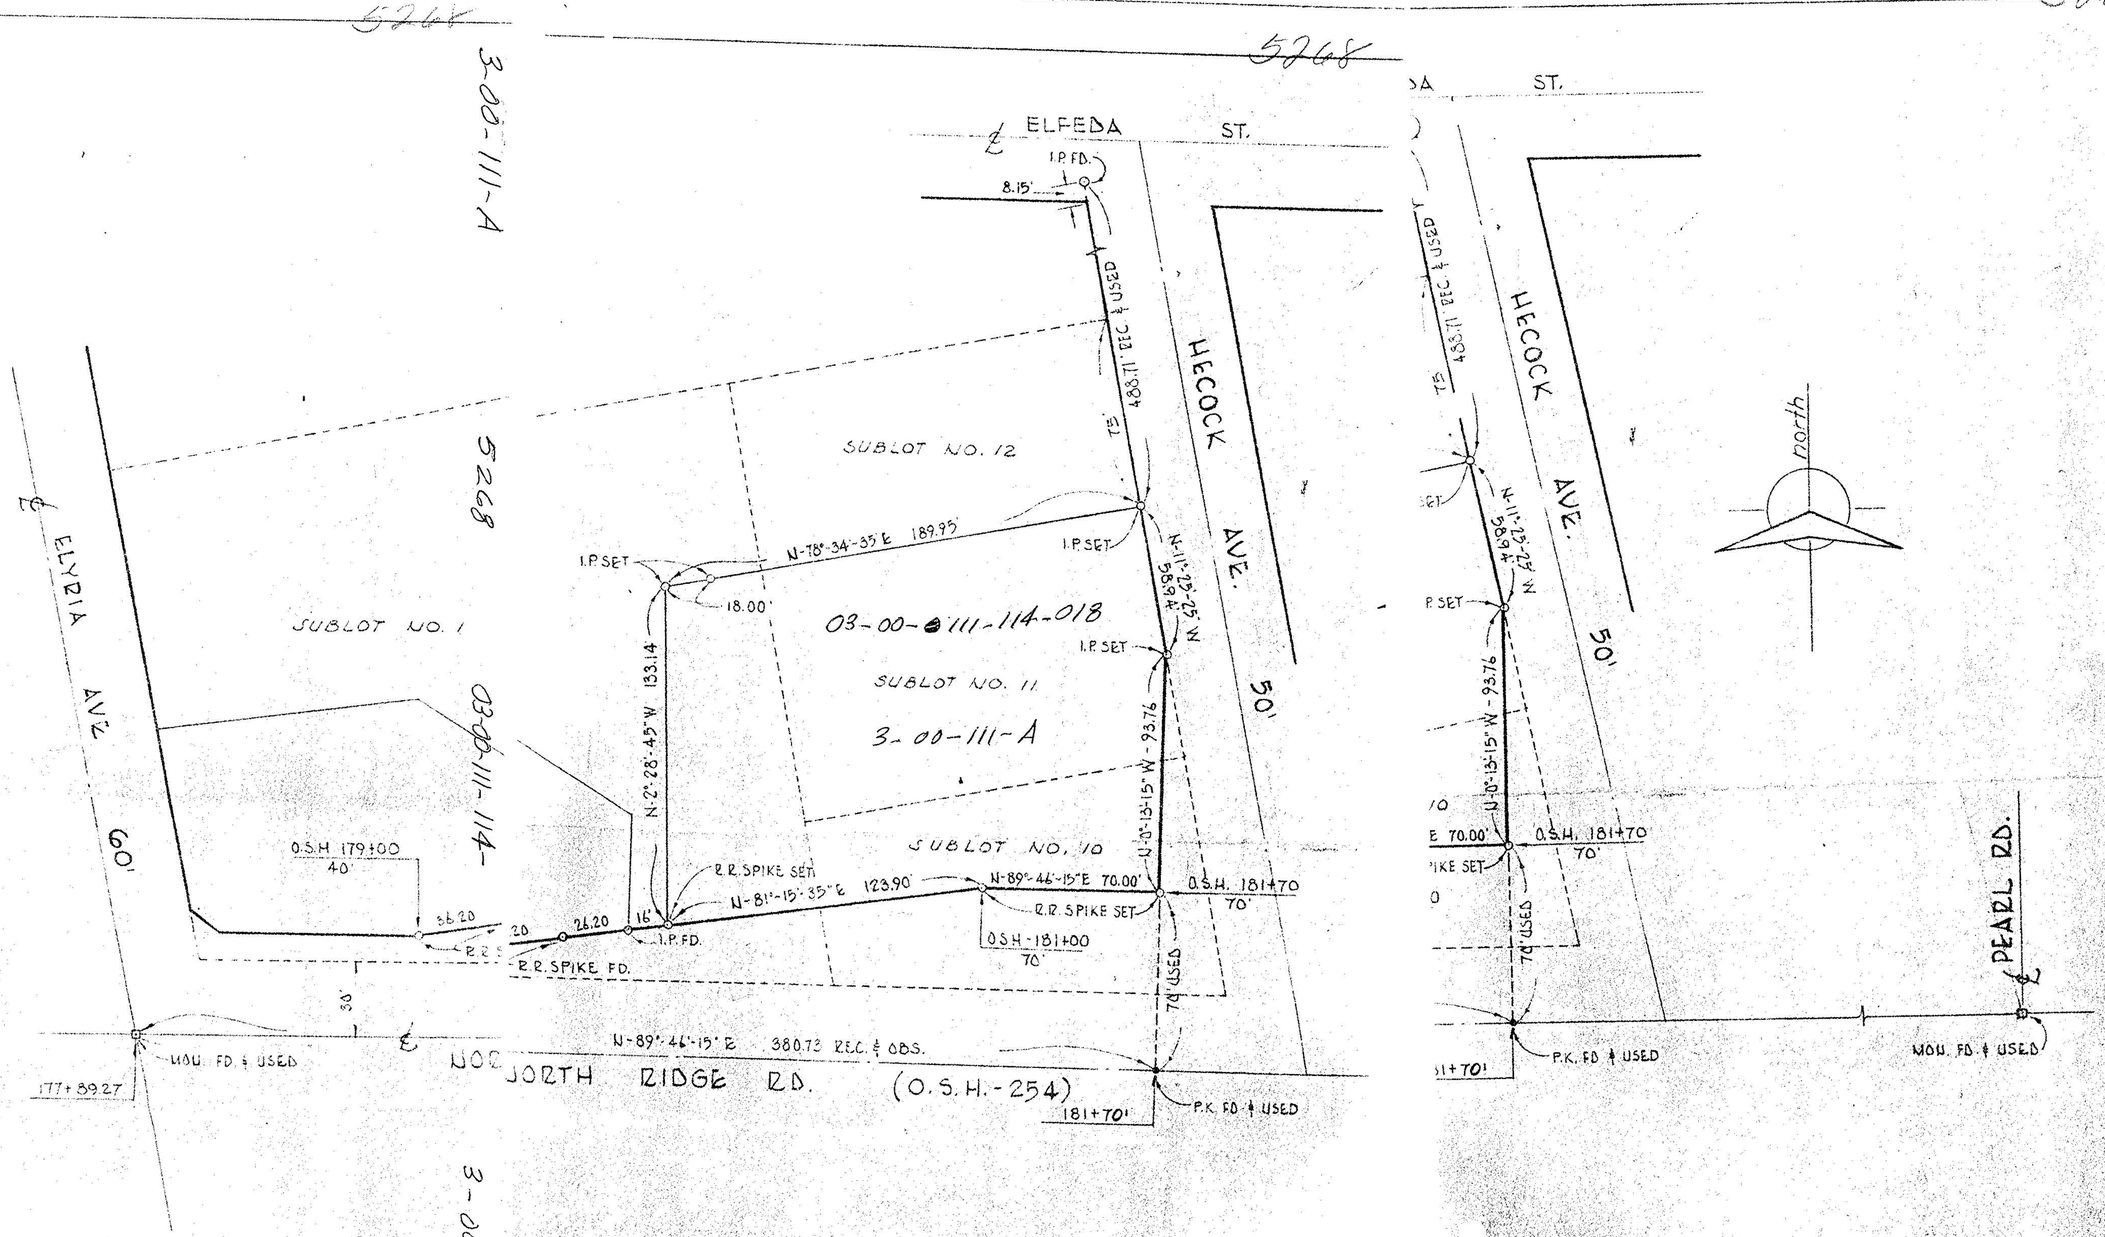

PLAT OF SURVEY OF THE

ORIGINAL LOT 111 DATE 4-30-57

SHEFFIELD