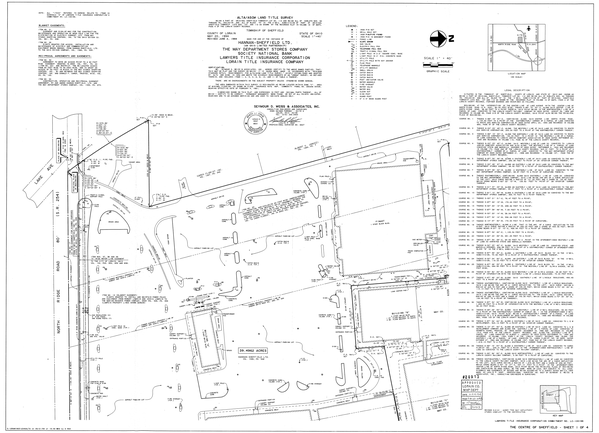
ALTA/ACSM LAND TITLE SURVEY
COUNTY OF LORAIN
TOWNSHIP OF SHEFFIELD
SOCIETY NATIONAL BANK
LORAIN TITLE INSURANCE COMPANY
SCALE 1" = 80'
GRAPHIC SCALE
THE CENTRE OF SHEFFIELD - SHEET 1 OF 4
FILE NO. PR4C0-2245.DWF

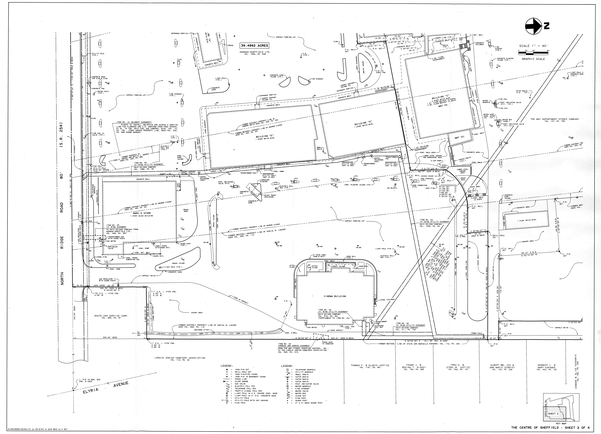
SCALE 1" = 80'
GRAPHIC SCALE
THE CENTRE OF SHEFFIELD - SHEET 2 OF 4
FILE NO. PR4C0-2245.DWF

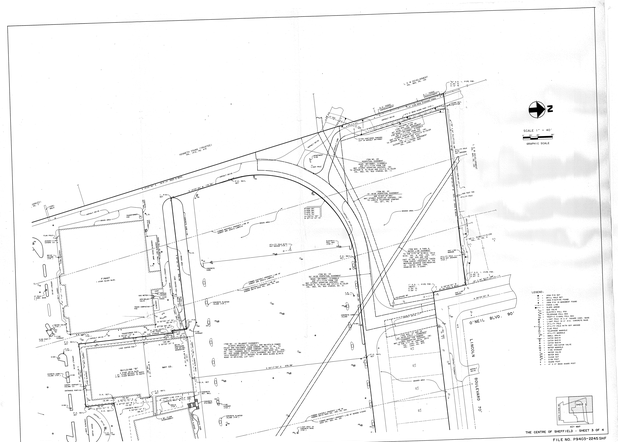
SCALE 1" = 80'
GRAPHIC SCALE
THE CENTRE OF SHEFFIELD - SHEET 3 OF 4
FILE NO. PR4C0-2245.DWF

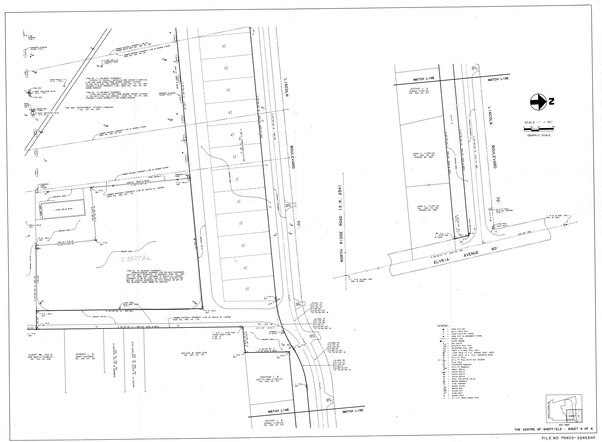
SCALE 1" = 80'
GRAPHIC SCALE
THE CENTRE OF SHEFFIELD - SHEET 4 OF 4
FILE NO. PR4C0-2245.DWF