PLAT V 9/22

22

THE. BROADWAY. GARDENS. ALLOTMENT.

Original Twp Lots. 103-108-113. Sheffield T.W.P.

Lorain. Co. Ohio

Scale 1 inch

June. 8. 1918

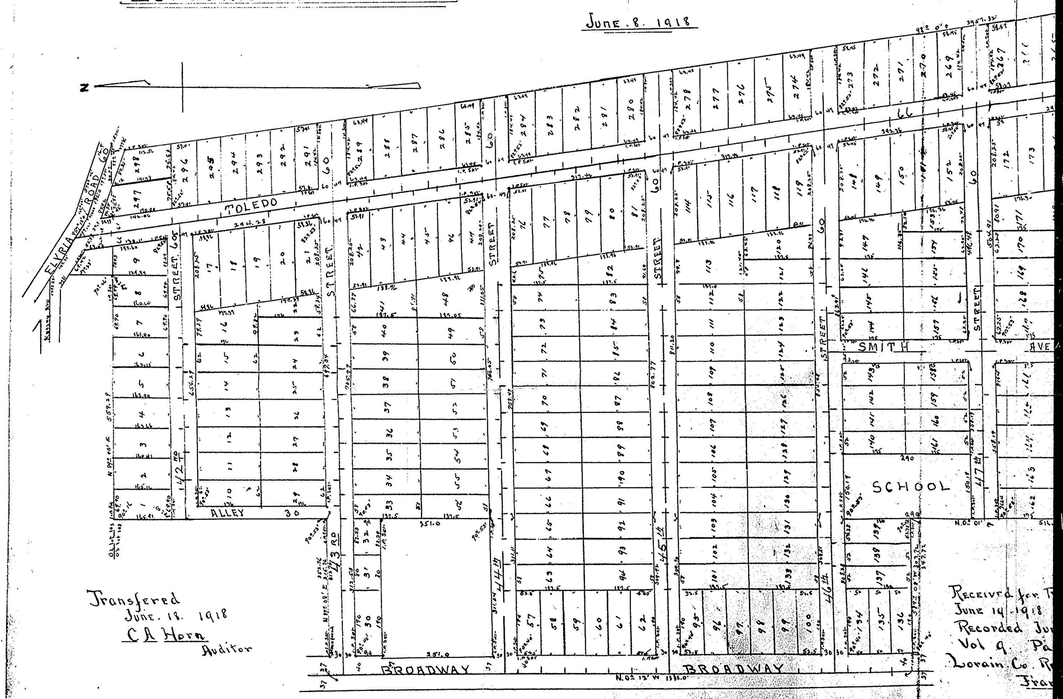

Transfered
June. 19. 1918
C A Horn
Auditor

Received for T
June 19. 1918
Recorded Ju
Vol 9. Pa
Lorain Co. R
Fran

Vacation for extension of 44th St. Ord Vol 903 Pg 85.

95119

COPY

COPY

22

P.V. 9, Pg. 22

PLAT VOL 9

22

ALLOTMENT.

T.W.P.

95119

Warden & Lawndon Engineers

Scale 1 inch 100 feet

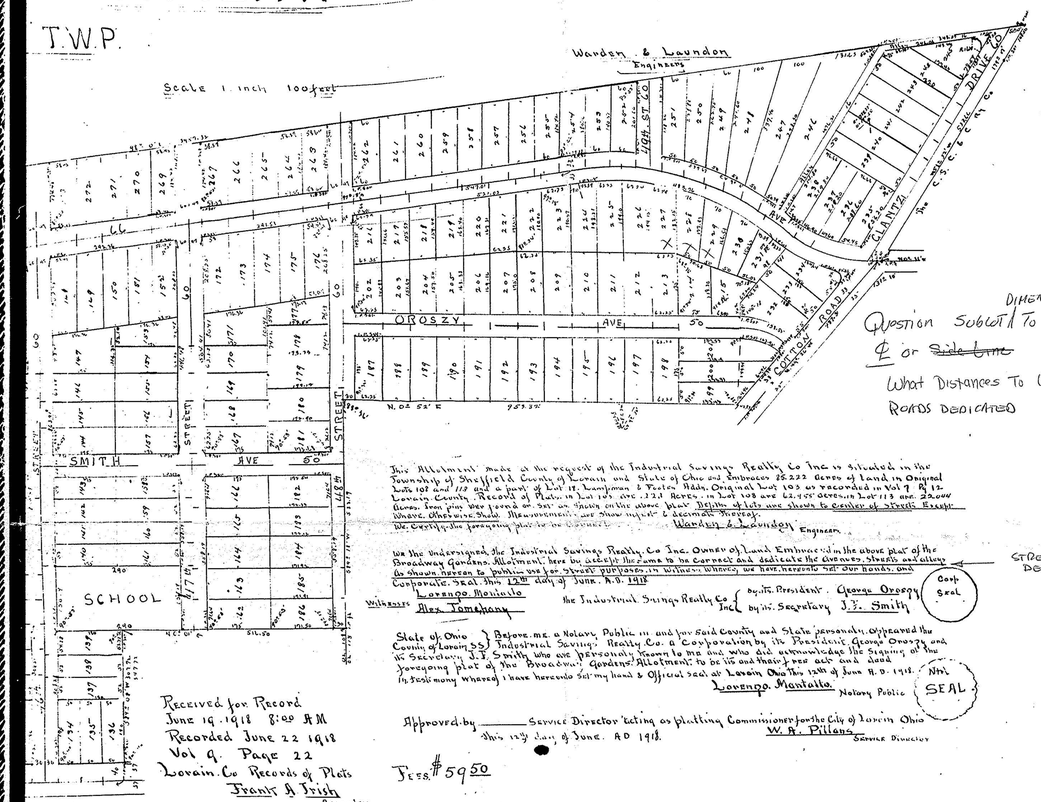

Question Subject To DIMENSIONED ℄ or ~~Side line~~

What Distances To USE ROADS DEDICATED

This Allotment made at the request of the Industrial Savings Realty Co Inc is situated in the Township of Sheffield County of Lorain and State of Ohio and Embraces 25.222 Acres of Land in Original Lots 107 and 112 and a part of Lot 18 Lamsjons & Yates Addn. Original Lot 103 as recorded in Vol 9 R 15 Lorain County Record of Plats. in Lot 107 are .222 Acres. in Lot 108 are 22.905 Acres. in Lot 113 are 2.000 Acres. Iron pins are found or set on Points on the above plat. Depths of lots are shown to Center of Streets Except where otherwise Noted. Measurements are shown in feet & decimals thereof.

Warden & Lawndon Engineers

We Certify the foregoing plat to be correct.

We the Undersigned, the Industrial Savings Realty Co Inc. Owner of Land Embraced in the above plat of the Broadway Gardens Allotment, here by certify the same to be correct and dedicate the streets and alleys as shown hereon to public use for street purposes. In Witness Whereof, we have hereunto set our hands and Corporate Seal this 12th day of June. A.D. 1918

STREET DEDICATION

Witnesses: Lorenzo Montello, Alex Tomahony

the Industrial Savings Realty Co Inc { by its President. George Orosy; by its Secretary J.J. Smith

Corp Seal

State of Ohio } Before me a Notary Public in and for said County and State personally appeared the
County of Lorain } ss Industrial Savings Realty Co. a Corporation by its President George Orosy and its Secretary J.J. Smith who are personally known to me and who did acknowledge the signing of the foregoing plat of the Broadway Gardens Allotment to be its and their free act and deed.
In Testimony whereof I have hereunto set my hand & Official seal at Lorain Ohio This 12th of June A.D. 1918.

Lorenzo Montello
Notary Public

Notl SEAL

Received for Record
June 19. 1918 8:00 A.M.
Recorded June 22 1918
Vol 9. Page 22
Lorain Co Records of Plats
Frank A Trigh
Recorder

Approved by _____ Service Director acting as platting Commissioner for the City of Lorain Ohio
this 12th day of June. AD 1918.
W. A. Pillons
Service Director

Fees #59.50

COPY

COPY

035

23