#22751

APPROVED
LORAIN CO.
MAP DEPT.
DATE 1-29-99
PAGE 3-00-113-A
BY T. Spik
VOID AFTER 22751

o iron pipes fd
o iron pins set
□ monument box
Sta 13+47.50
So Broadway R/W
Plans

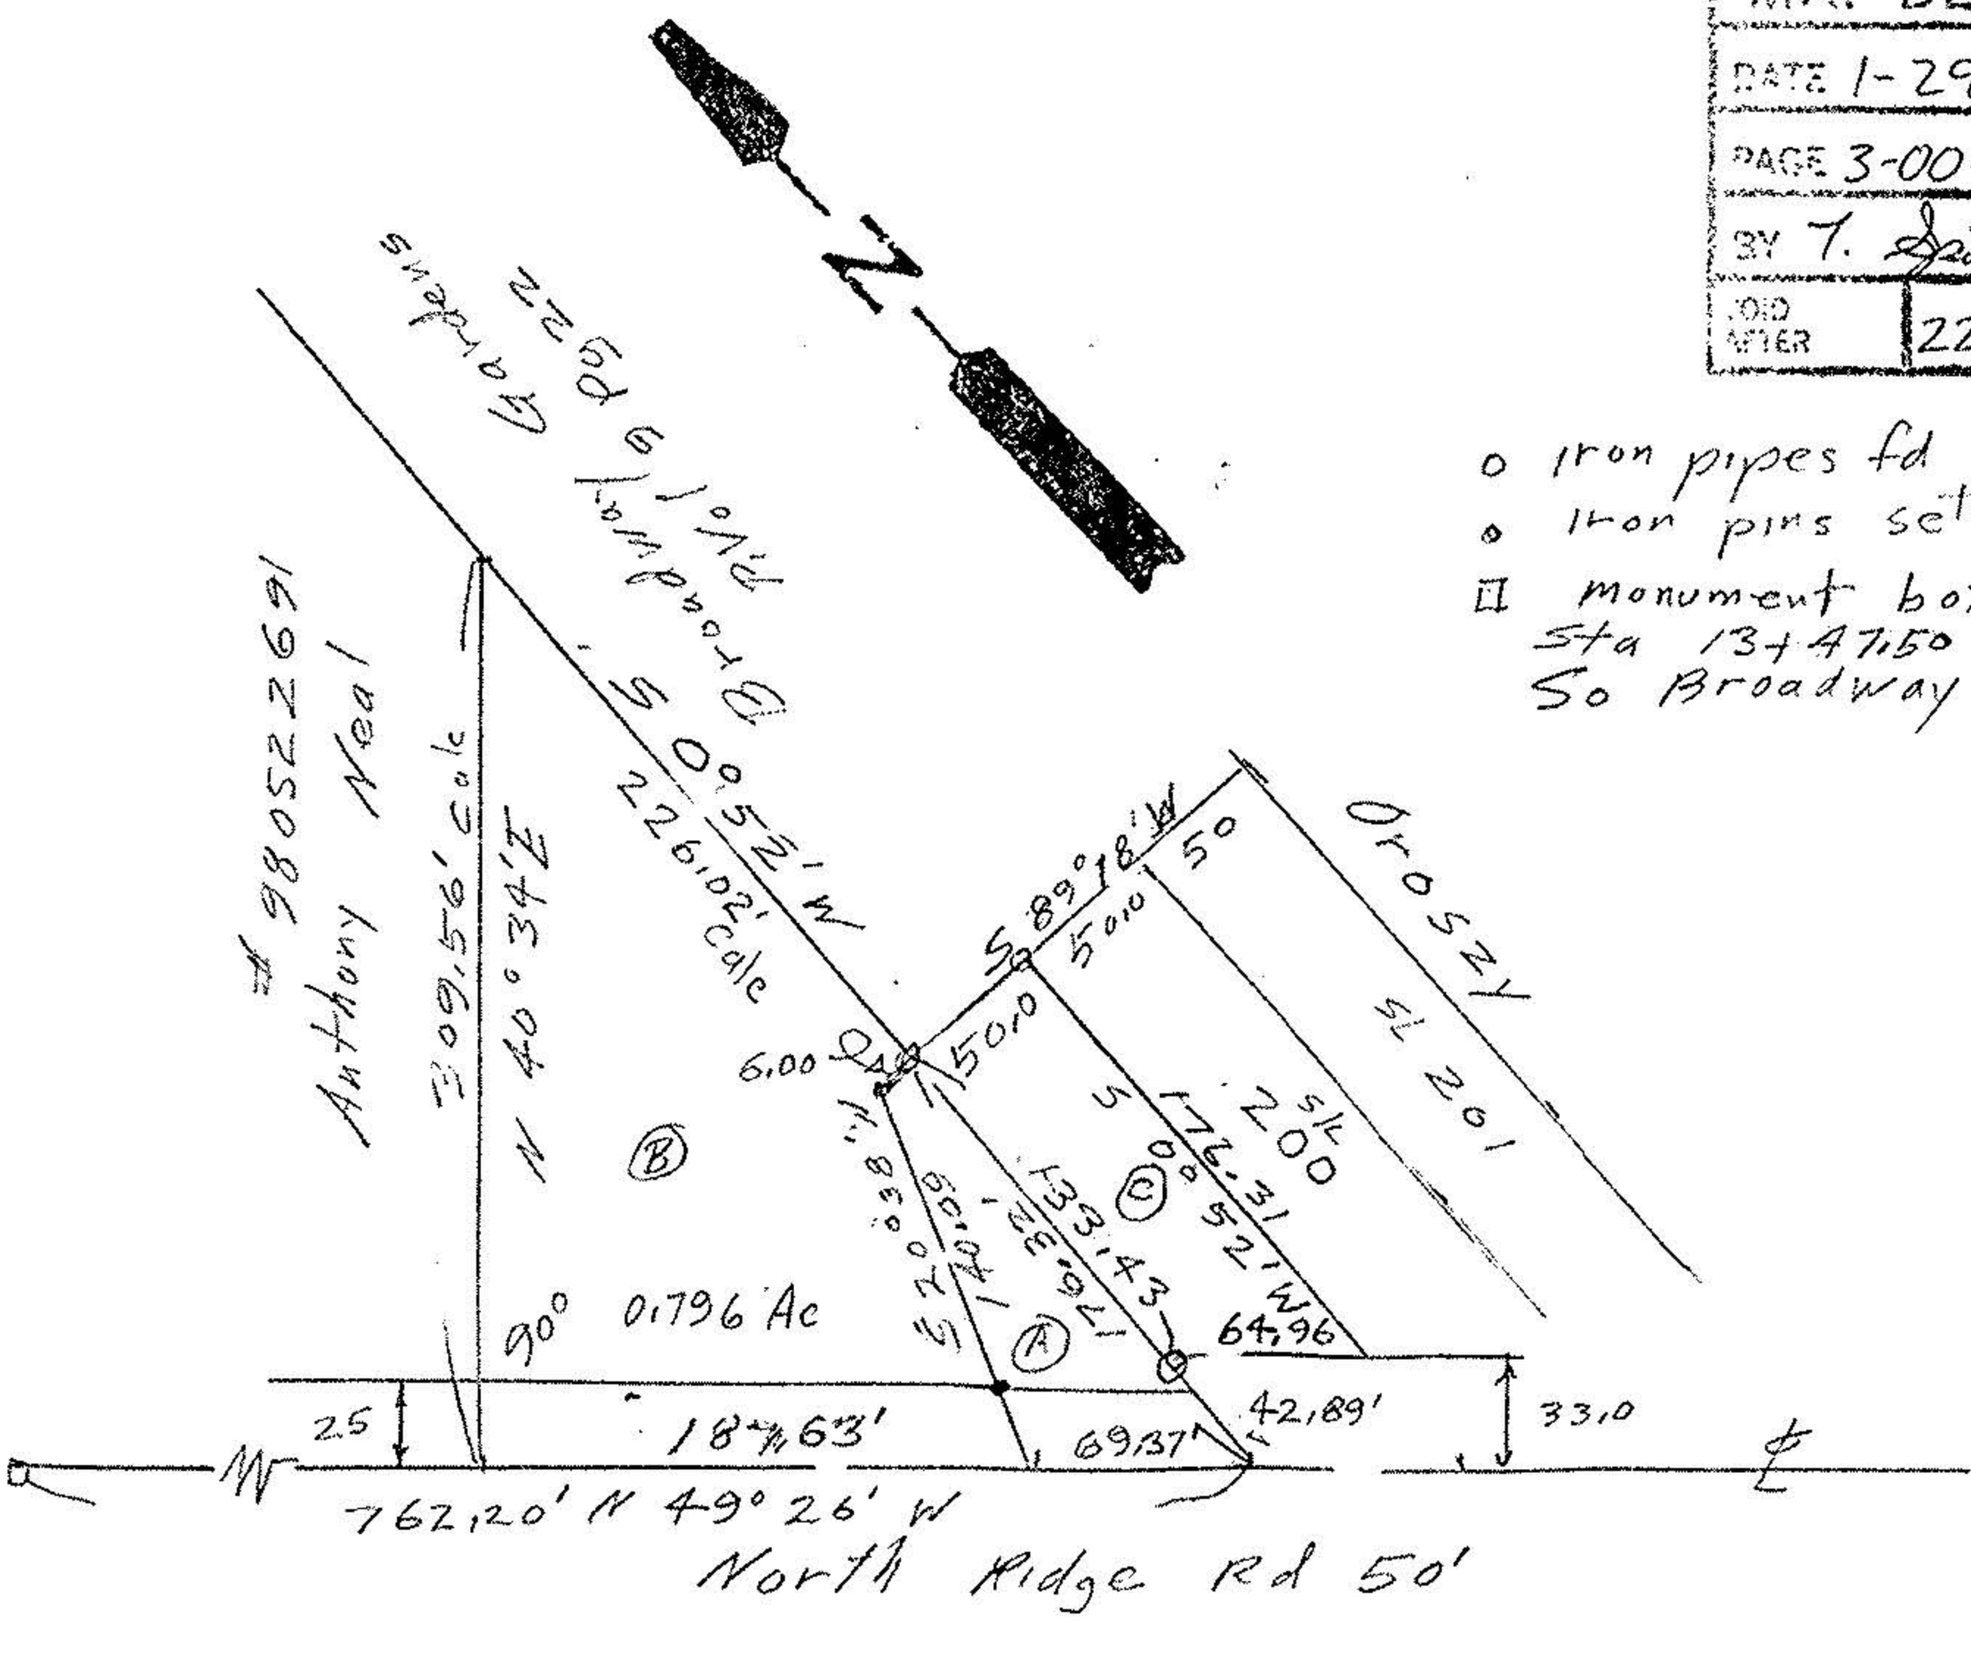

(A) 0.117 Acre
(B) Annette Cline & Edwards
Celestino OR 1260 Pg 709

(C) Robert E Toothman
172 Pg 833
199

STATE OF OHIO
JOHN POZYWAK
5292
REGISTERED
SURVEYOR

Survey of Parcel Split
Orginal Lot 113
Sheffield Township
Lorain County OHIO
Scale 1"=100' oct 1998
John Pozywak

03-00-113