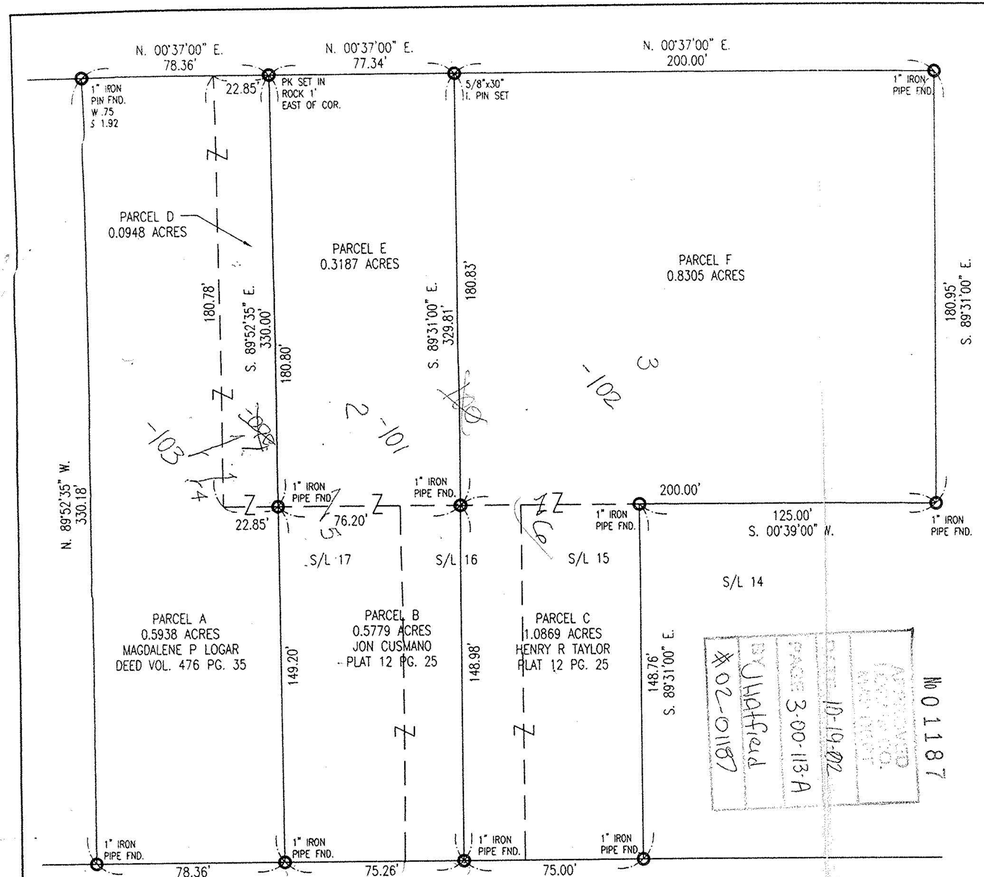

REVISIONS:

⚠ 04-01-02 ADD PARCELS D,E & F

STATE OF OHIO
JOHN CLOUD SKONIECZNY
S-6356
REGISTERED SURVEYOR

I CERTIFY THAT THIS PLAN WAS PREPARED BY ME AND IS CORRECT TO THE BEST OF MY KNOWLEDGE AND BELIEF

John L. Skonieczny
REG. SURVEYOR #6356

JOHN C. SKONIECZNY
7739 VIEWMOUNT DR.
PAINESVILLE, OHIO 44077
PH. 352-7742

GRAPHIC SCALE

40 0 20 40 80 160

1 inch = 40 ft.

LOT SPLIT FOR:
MAGDALENE LOGAR

SCALE: 1"= 40'	APPROVED:	DRAWN BY: SWC
DATE: JAN. 02		REVISED:

BEING PART OF SUBLOT 15, 16 & 17 IN THE WOLVERTON SUBDIVISION AS RECORDED IN PLAT VOLUME 12 PAGE 25 OF LORAIN COUNTY RECORDS TOWNSHIP OF SHEFFIELD - COUNTY OF LORAIN - STATE OF OHIO

JOB# 02-3358 | DRAWING NUMBER 02-2147

THOMAS SIMON & ASSOCIATES, INC.
PROFESSIONAL LAND SURVEYORS

CORBLESTONE CORNER PROFESSIONAL CENTER
39049 CENTER RIDGE ROAD
NORTH RIDGEVILLE, OHIO 44039
(440) 327-2025
FAX 327-2964

SURVEY FOR: JOHN KNIPPER & JOHN GREGORY

SPLIT AND COMBINATION

ORIG. LOT 58	CITY OF	DATE 6-02 SCALE 1"=200'
ORIG. SEC.	VILLAGE OF	DWN. BY TAS
TRACT	COUNTY OF LORAIN	JOB NO. 2002-038
TOWNSHIP OF NEW RUSSIA	STATE OF OHIO	

DIMENSIONS SHOWN ON THIS PLAT ARE EXPRESSED IN FEET AND DECIMAL PARTS THEREOF. ALL BEARINGS ARE TO AN ASSUMED MERIDIAN AND ARE USED TO DESCRIBE ANGLES ONLY. PERMANENT MONUMENTS WERE FOUND OR SET AS INDICATED, ALL OF WHICH I CERTIFY TO BE CORRE

STATE OF OHIO
THOMAS A. SIMON
S-7775
REGISTERED SURVEYOR
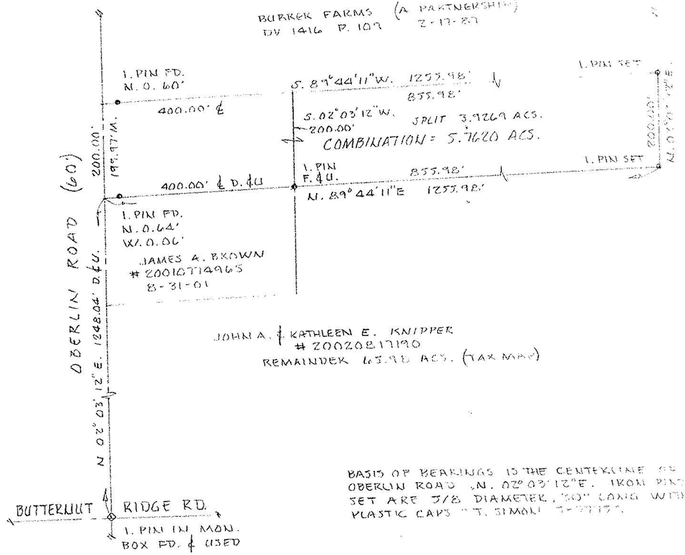
THOMAS A. SIMON
REGISTERED PROFESSIONAL
SURVEYOR NO. S-7775