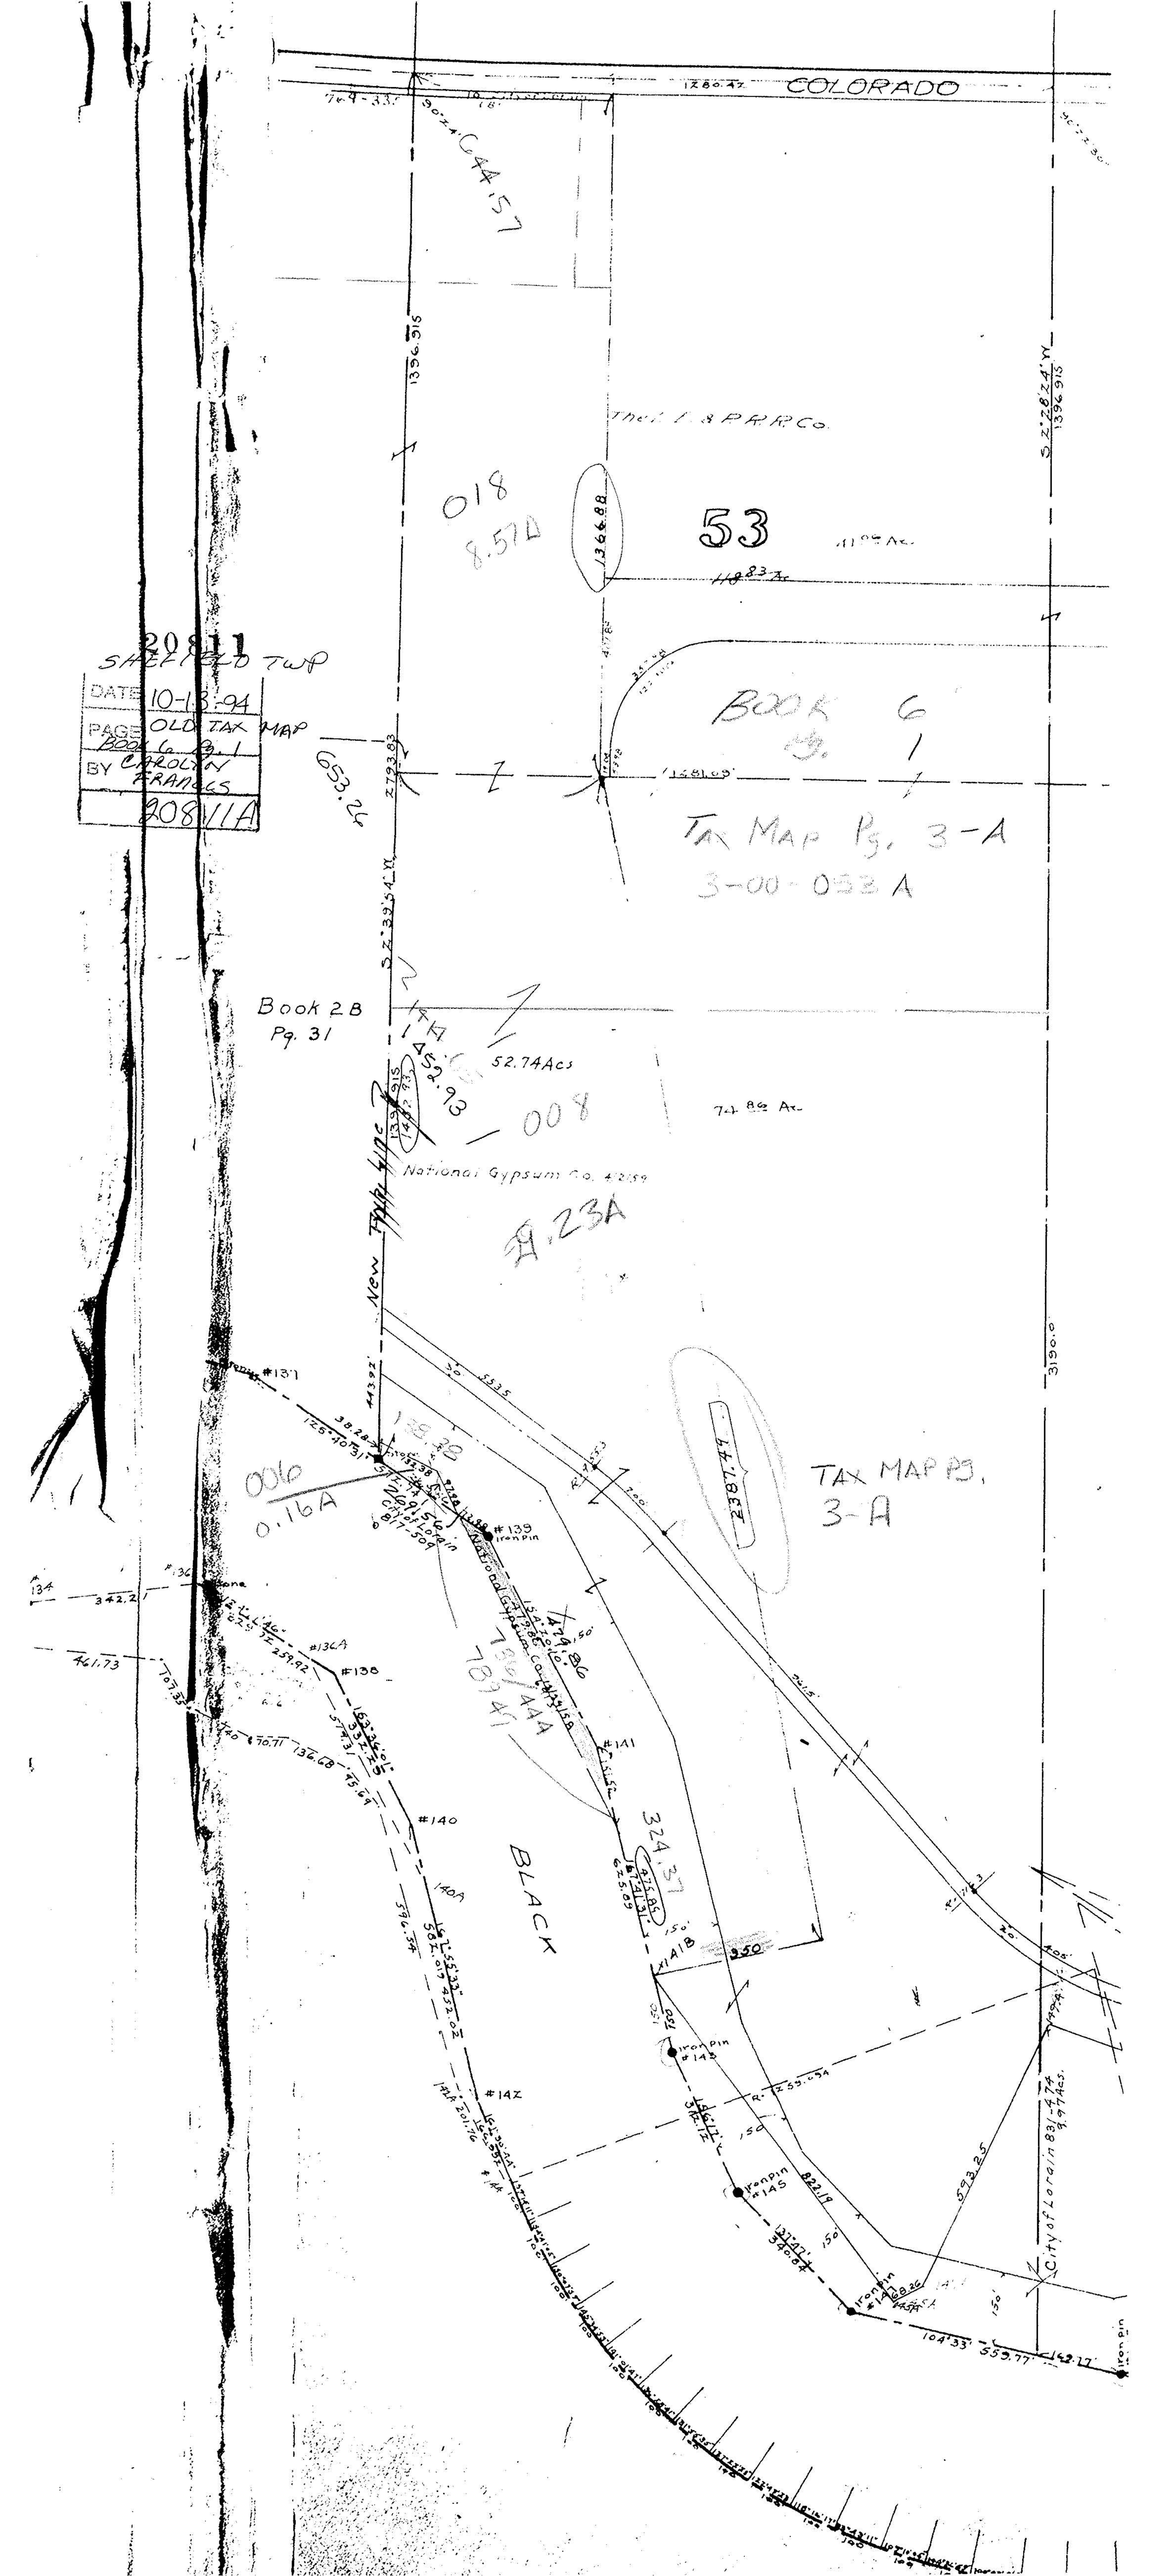
COLORADO
1280.47
C44.57
1396.915
INCL. I. & P.R.R.Co.
018
8.57A
53
1396.88
11.09 Ac.
11.83 Ac.
20811
SHEFFIELD TWP
DATE 10-13-94
PAGE OLD TAX MAP
Book 6 Pg. 1
BY CAROLYN FRANCIS
20811A
653.26
1793.83
BOOK 6
Pg. 1
TAX MAP Pg. 3-A
3-00-053A
Book 28
Pg. 31
52.74Acs
008
7.1 86 Ac.
National Gypsum Co. 42159
New Type 4 Line
9.23A
#137
#138
#139
Iron Pin
#140
#141
