TOPOGRAPHICAL SURVEY FOR

DRUG MART

BEING PART OF ORIGINAL SHEFFIELD TOWNSHIP LOT N° 53 & 54
IN THE CITY OF LORAIN, COUNTY OF LORAIN, STATE OF OHIO.

SCALE: 1" = 30'

MAY, 1981

PREPARED BY:

ELENSKI & ASSOCIATES, INC.

PETER J. KUKIS ~ REGISTERED SURVEYOR N° 5078

~ BENCH MARK ~

CROSS ON NW CORNER OF SUNOCO SIGN = 41.32

ACREAGE

6.000 Ac.
0.615 Ac. (INCL. ROAD)
6.615 Ac. TOTAL

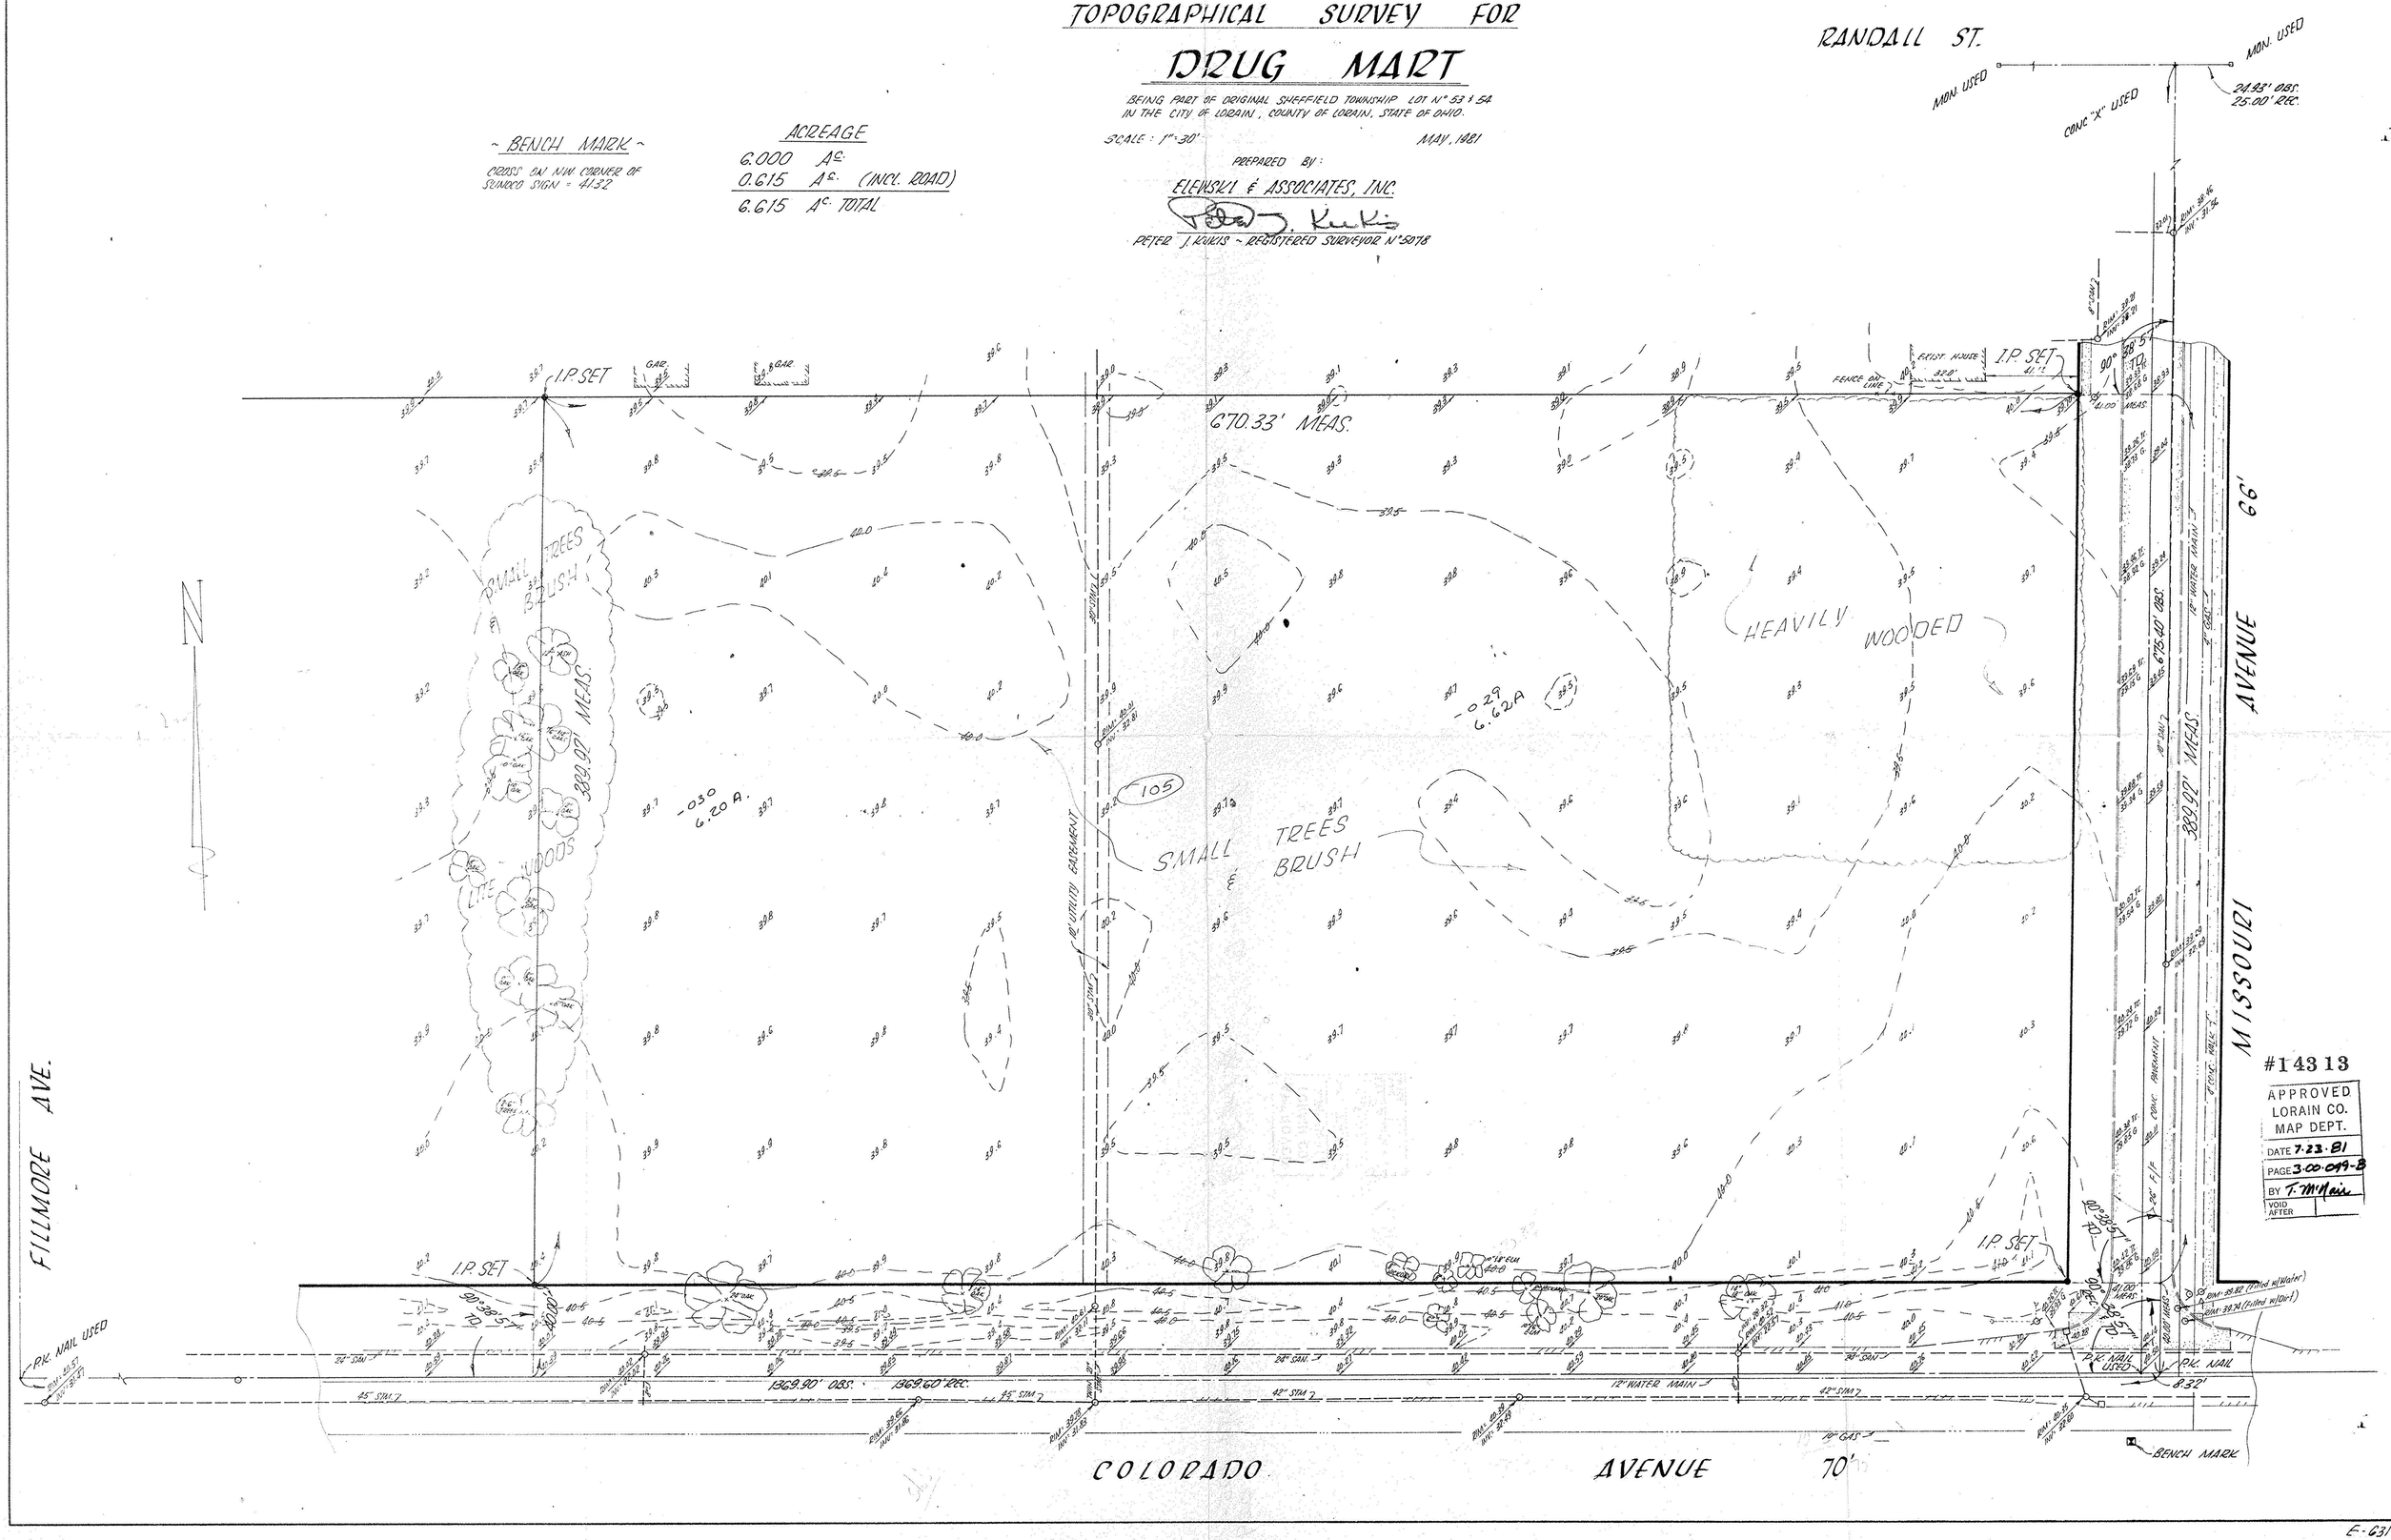

#14313

APPROVED
LORAIN CO.
MAP DEPT.
DATE 7-23-81
PAGE 3-00-049-B
BY T. McMain
VOID AFTER

E-631