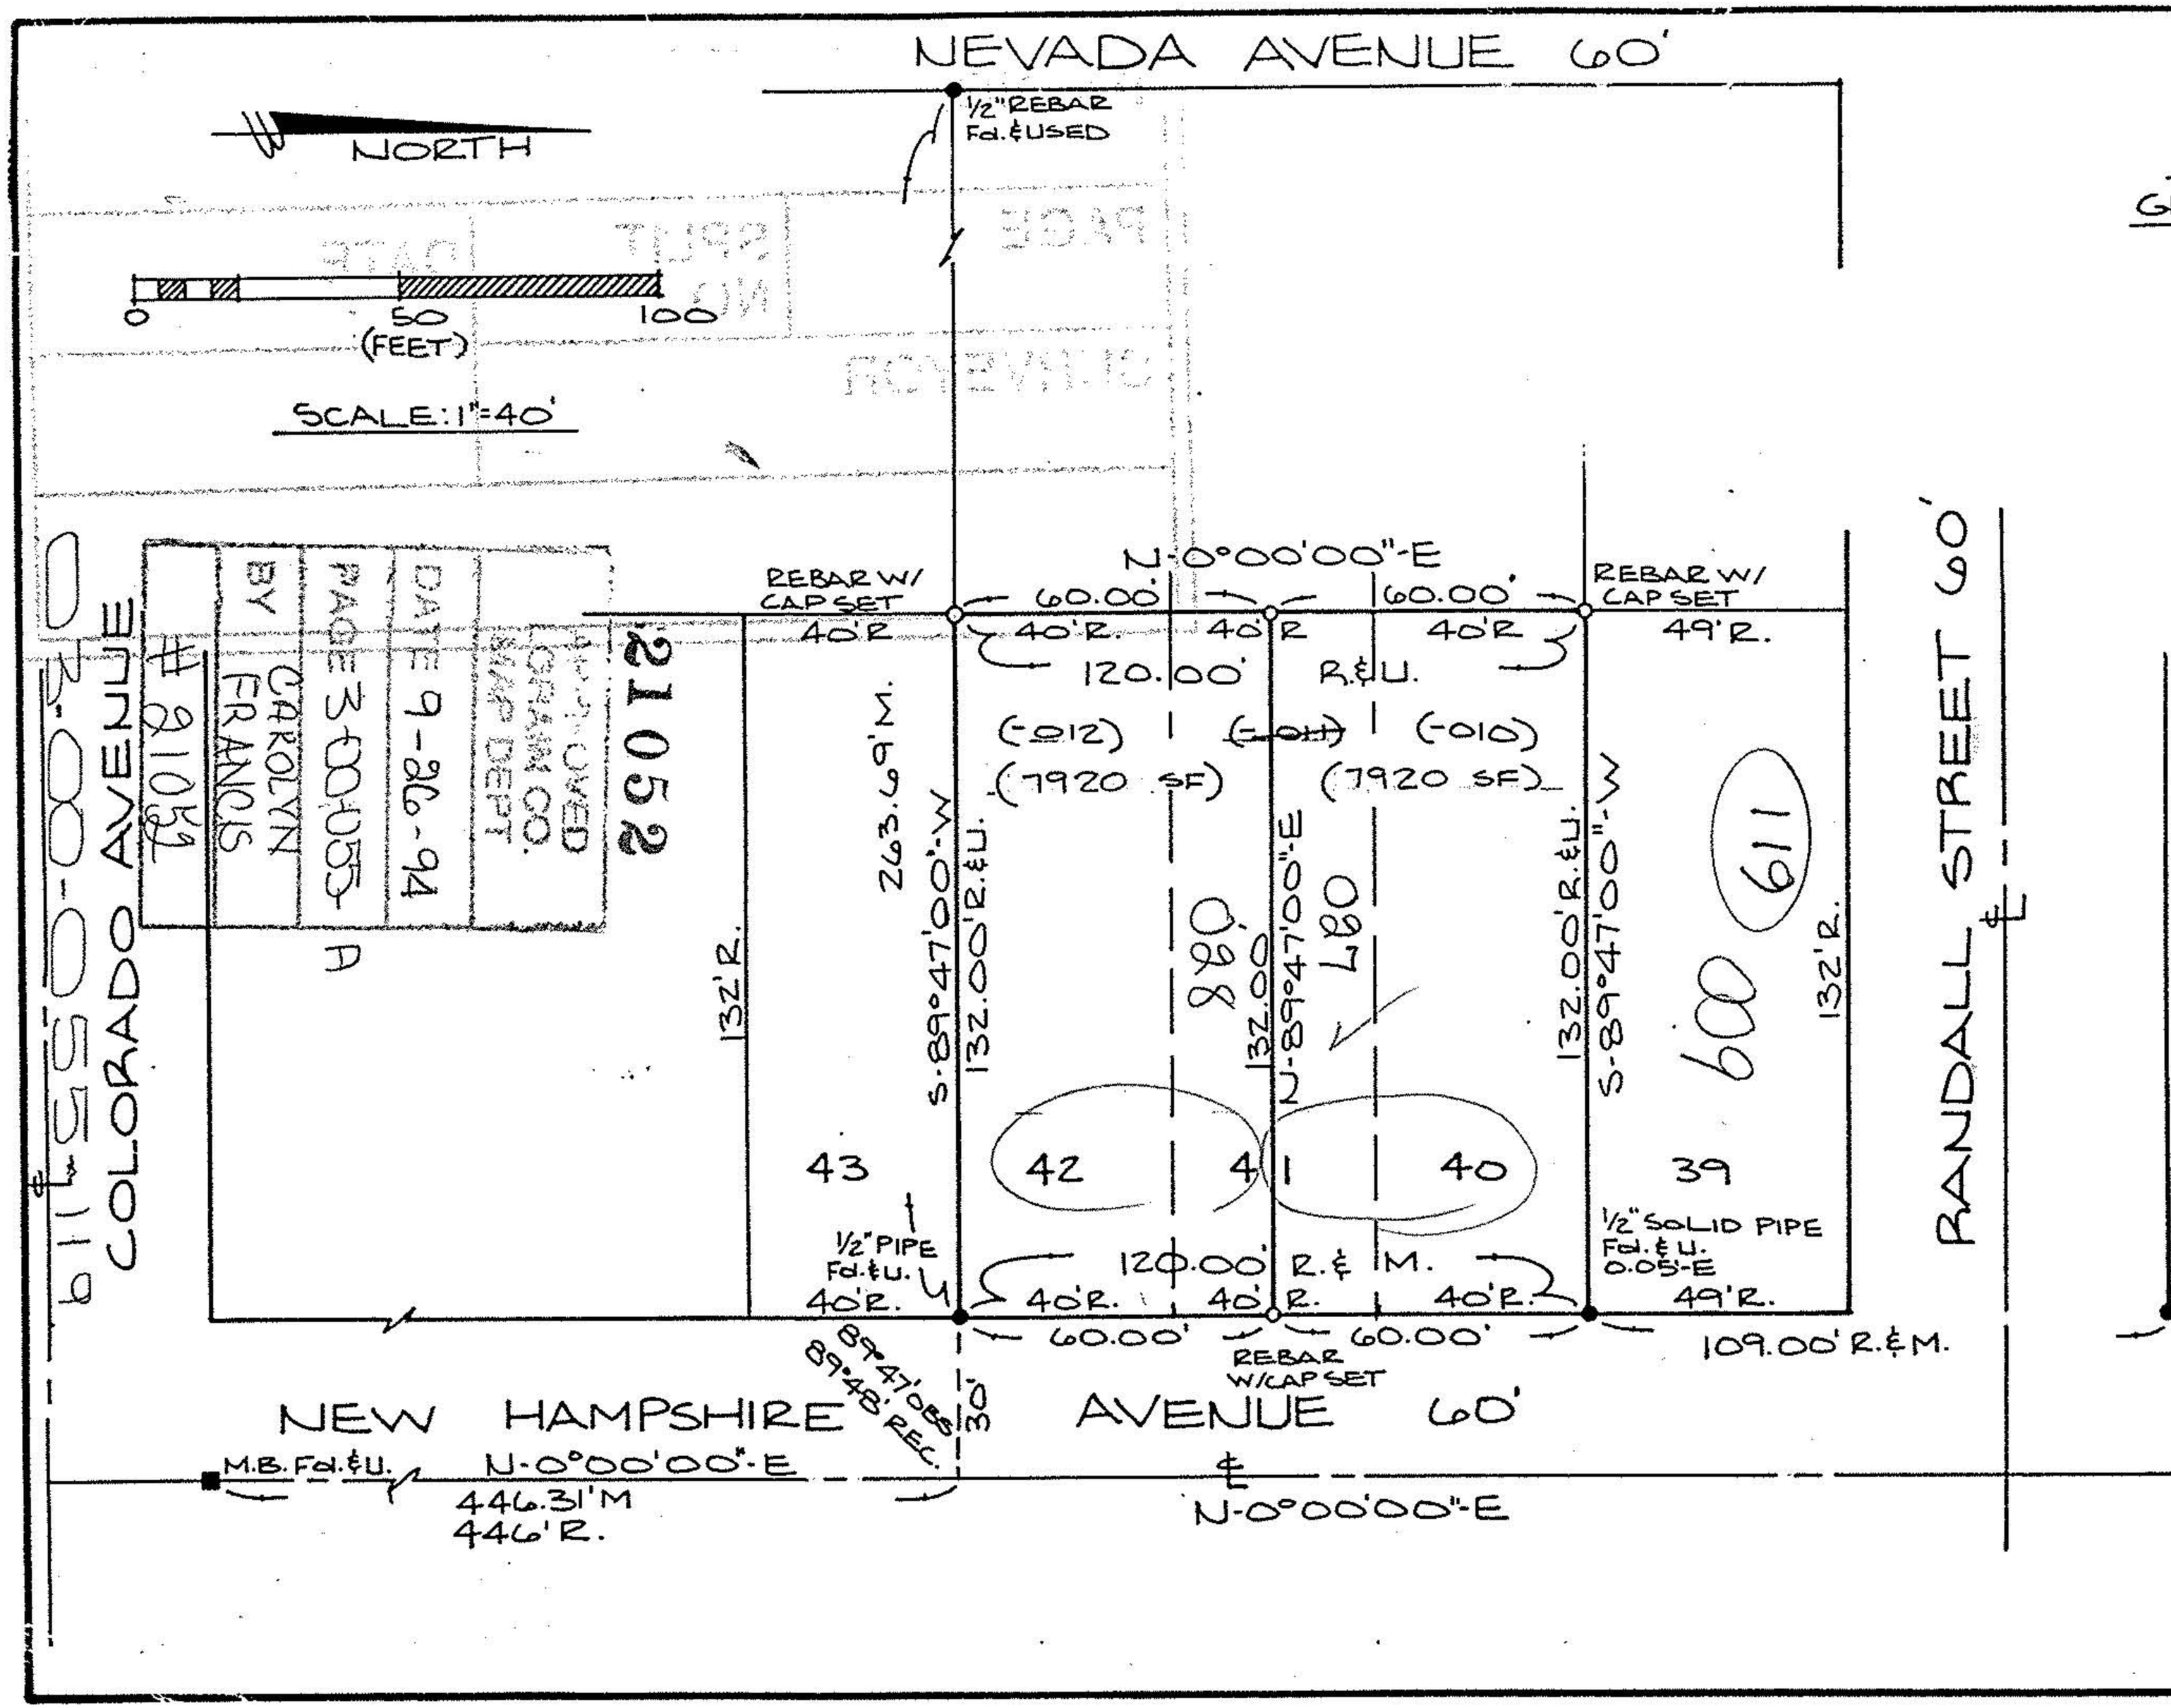
NEVADA AVENUE 60'
NORTH
0 50 100
(FEET)
SCALE: 1"=40'
1/2" REBAR Fd. & USED
N-0°00'00"-E
REBAR W/ CAP SET
60.00'
40'R.
40'R
40'R
60.00'
40'R
REBAR W/ CAP SET
49'R.
120.00' R.&U.
(-012)
(-011)
(-010)
(7920 SF)
(7920 SF)
263.69'M.
S-89°47'00"-W
132.00'R.&U.
132'R.
N-89°47'00"-E
132.00'
132.00'R.&U.
S-89°47'00"-W
132'R.
43
42
41
40
39
1/2" PIPE Fd. & U.
40'R.
120.00' R.& M.
40'R.
40'R.
40'R.
1/2" SOLID PIPE Fd. & U. 0.05'-E
49'R.
60.00'
60.00'
REBAR W/CAP SET
109.00' R.&M.
89°47'OBS
89°48' REC.
30'
NEW HAMPSHIRE AVENUE 60'
M.B. Fd. & U.
N-0°00'00"-E
446.31'M
446'R.
N-0°00'00"-E
RANDALL STREET 60'
5/8" PIPE Fd.
COLORADO AVENUE
03-00-055-119
21052
APPROVED LORAIN CO. MAP DEPT
DATE 9-26-94
PAGE 3-00-055-A
BY CAROLYN FRANCIS
#21052
SPLIT NO.
PAGE
SURVEYOR
DATE
SURVEY MAP
SUBLOT NOS. 40, 41 & 42 IN
GEORGE RANDALL'S SUBD'N.
P.V. 8 P.60
CITY OF LORAIN
COUNTY OF LORAIN
STATE OF OHIO
AUGUST 8, 1994
PREPARED BY:
KS ASSOCIATES INC.
ENGINEERS SURVEYORS
David L. Elwell
DAVID L. ELWELL
REG. SURVEYOR No. 6333
STATE OF OHIO
DAVID L. ELWELL
6333
REGISTERED
SURVEYOR
APPROVED BY THE LORAIN CITY PLANNING COMMISSION ..... NO PLAT REQUIRED
William E. Dobbs 8-31-94
SECRETARY LORAIN CITY PLANNING COMMISSION
APPROVED
AS TO DESCRIPTION ONLY
Date 19-Aug-1994
City of Lorain
Per Patrick A. McGannon
Engineering Dept.
94-172