KLEINOEDER · SCHMIDT and ASSOCIATES

ENGINEERS — SURVEYORS — CONSULTANTS in LAND PLANNING

ELYRIA · OHIO

SURVEY 10-31-86

PARCEL MAP

Sublot(s) 141 & PART OF 142

Subd'n NICHOL'S SUBDIVISION VOL. 9, P. 8 OF MAPS

Township SHEFFIELD Tract

Orig. Lot(s) 55 Sec.

County of LORAIN State of Ohio

Corporation CITY OF LORAIN

03-00-055-111

03-00-055-A #17117

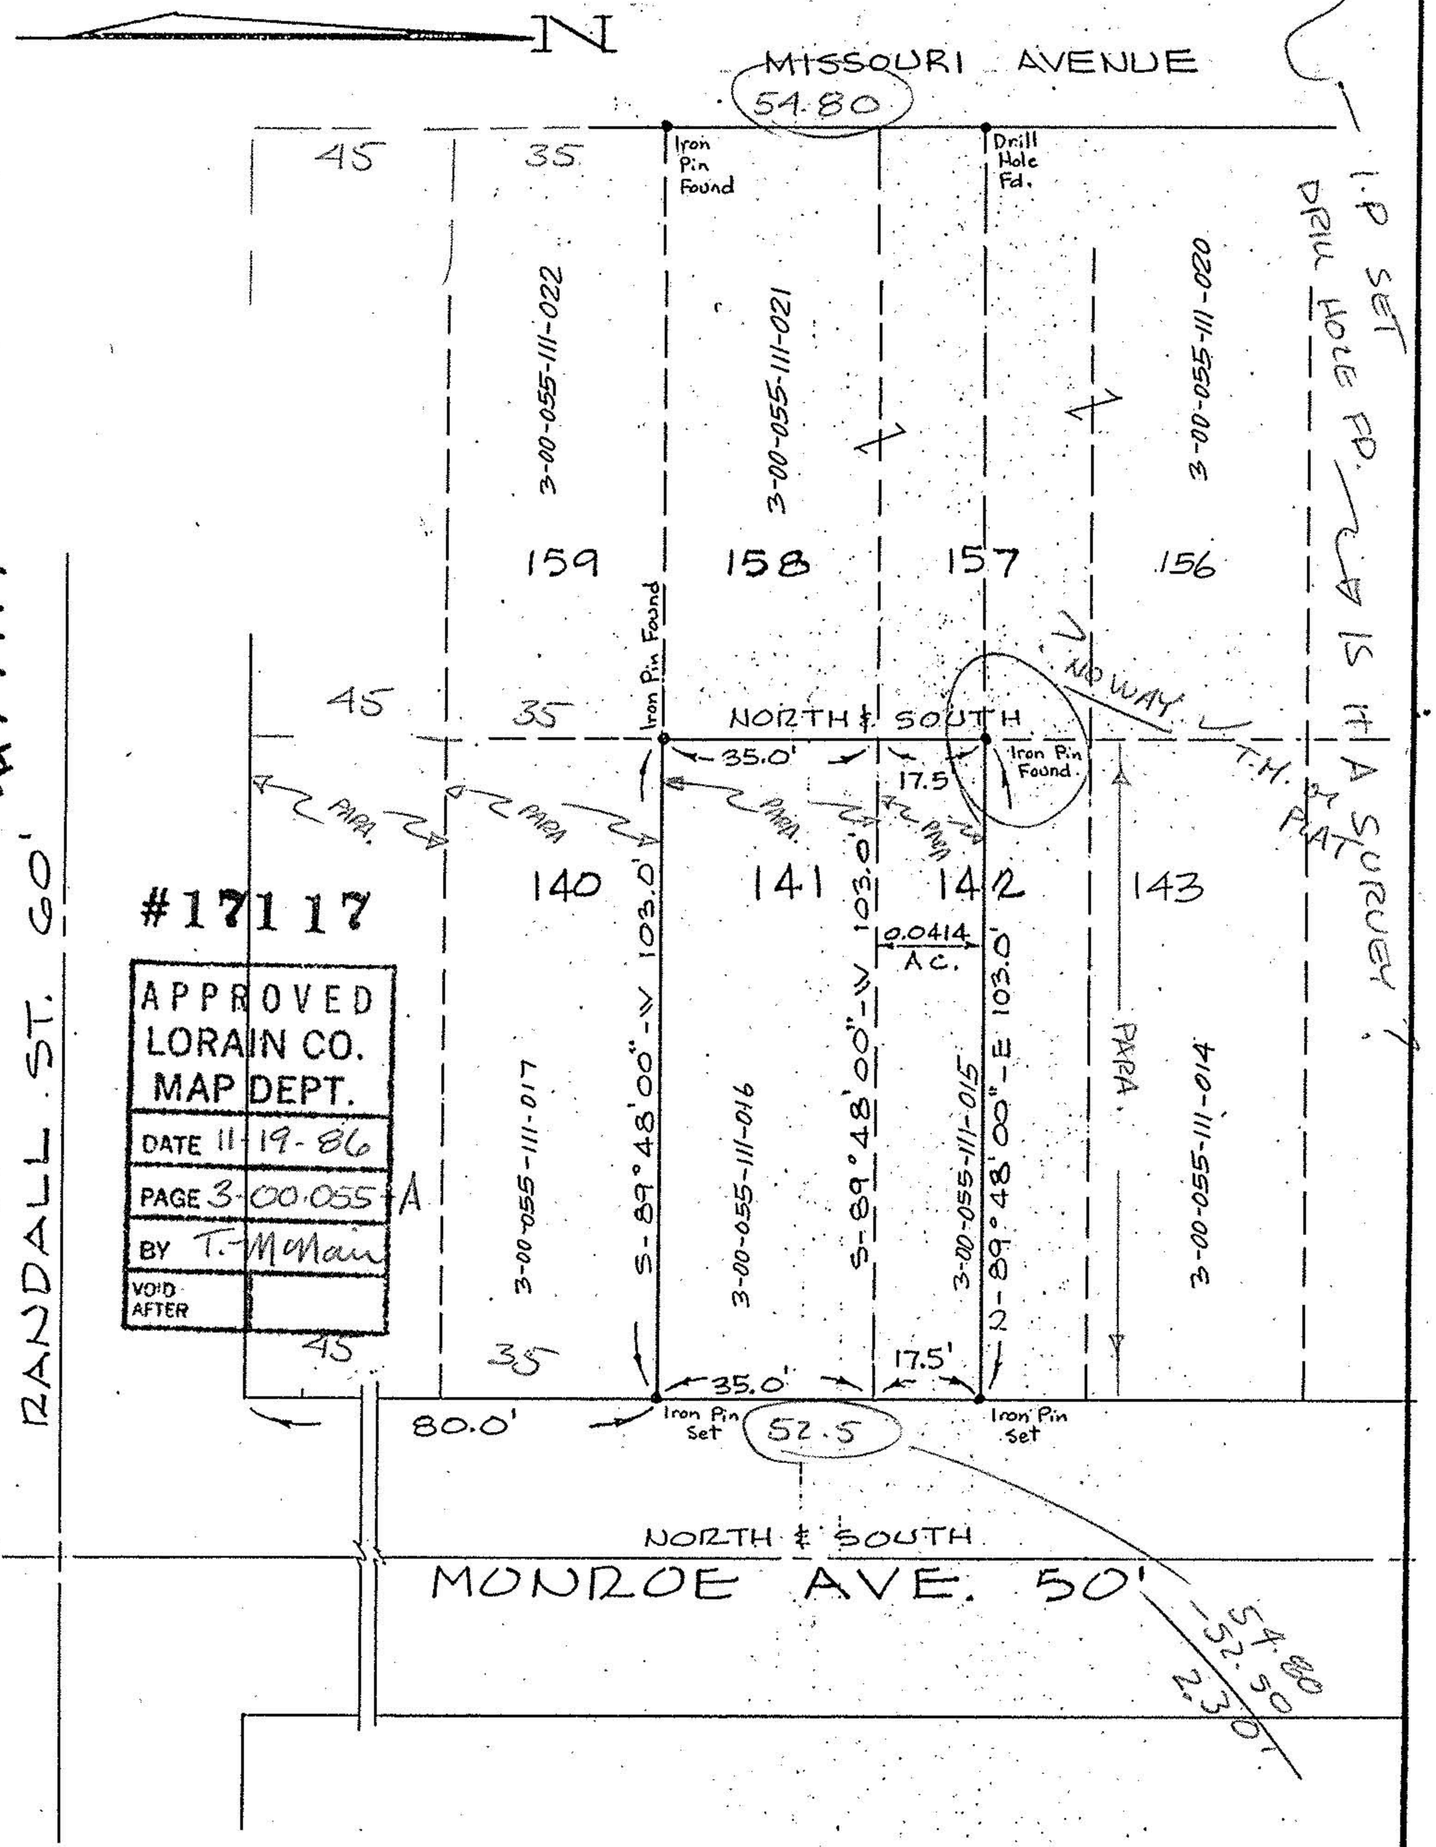

Prepared for:

REV. 11-3-86

Scale: 1" = 30'	Date: OCT. 23, 1986	Dr. by: A.B.	Job No 86-272