SURVEY AND TOPOGRAPHIC MAP

OF PERMANENT PARCEL NO. 03-00-057-112-001

FOR ABE PICKUS

SITUATED IN THE CITY OF LORAIN, COUNTY OF LORAIN, STATE OF OHIO, AND KNOWN AS BEING PART OF ORIGINAL SHEFFIELD TOWNSHIP LOT NO. 57, PART OF PARCEL NO. 1 AS RECORDED IN VOL. 542 PG. 9 LORAIN COUNTY DEED RECORDS.

SCALE: 1" = 50'

AUGUST, 1971

PREPARED BY: WILLIAM V. HALISHAK ENGINEERS & ASSOCIATES
7962 BROADVIEW ROAD
PARMA, OHIO 44134

MONUMENTS WERE FOUND AT ALL POINTS INDICATED HEREON AND PERMANENT MONUMENTS WERE SET WHERE INDICATED. DISTANCES ARE SHOWN IN FEET AND DECIMAL PARTS THEREOF. ALL OF WHICH I CERTIFY TO BE CORRECT.
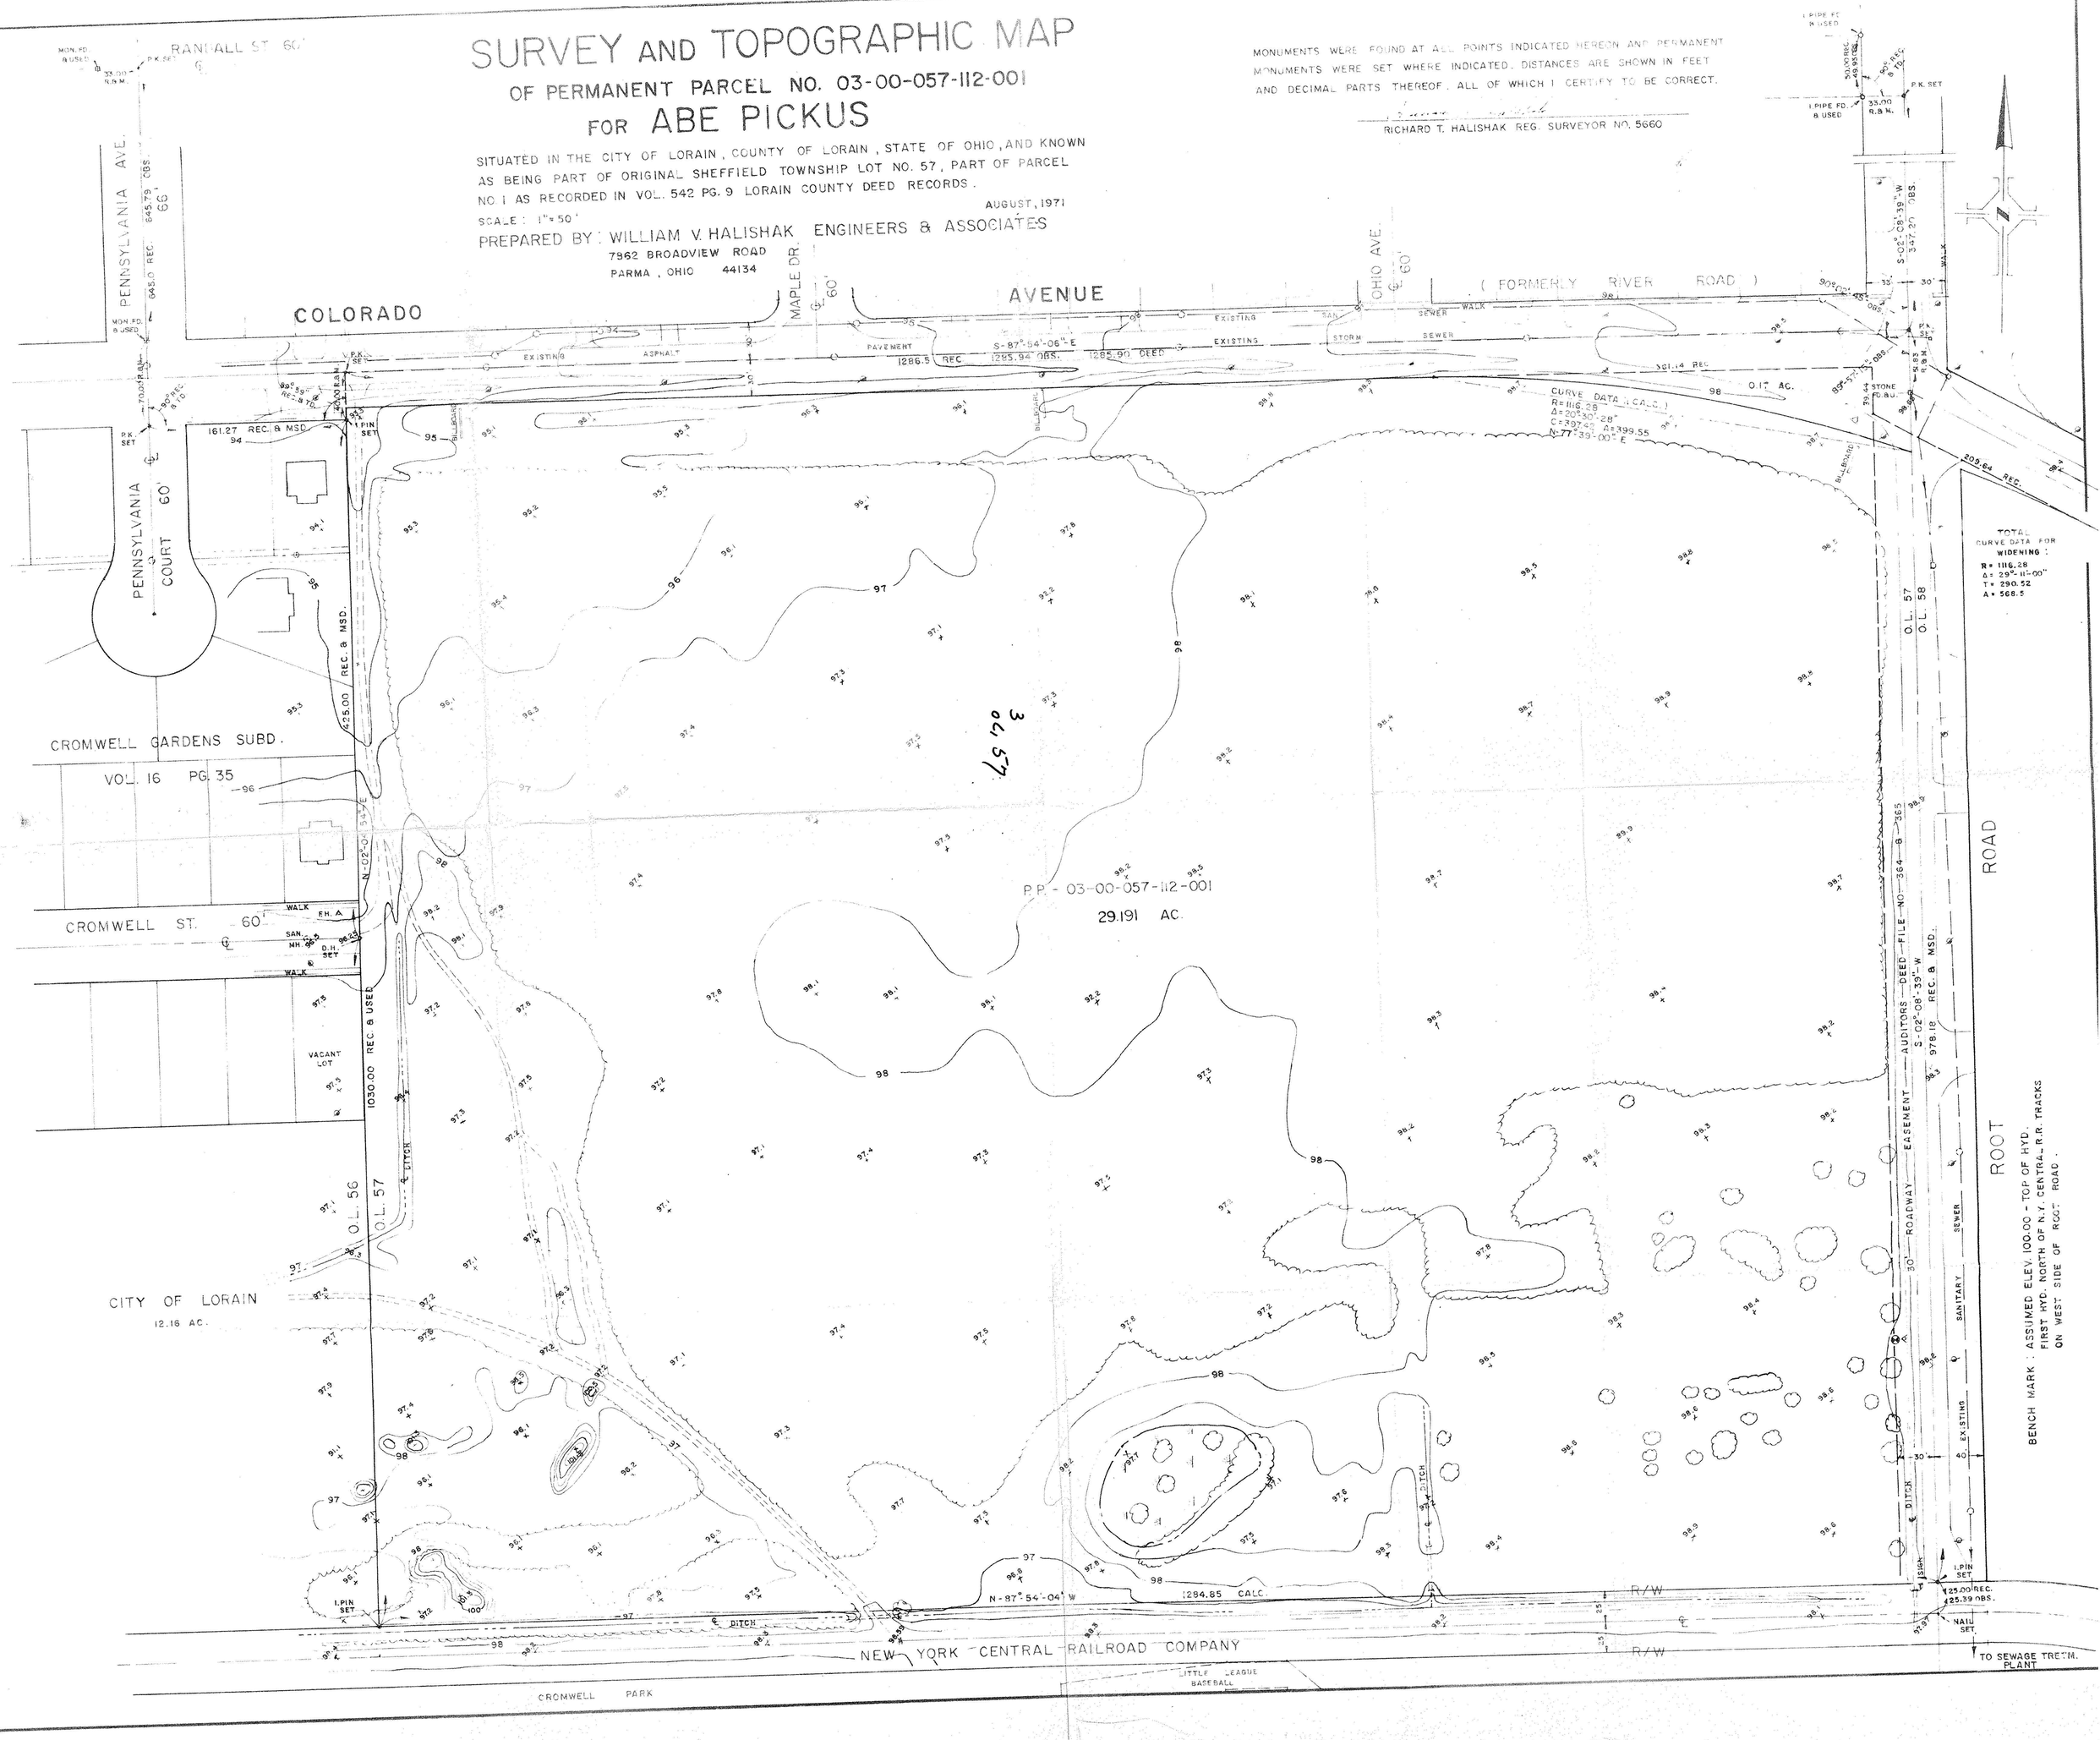
RICHARD T. HALISHAK REG. SURVEYOR NO. 5660