


21644-A 03-00-058-101-012

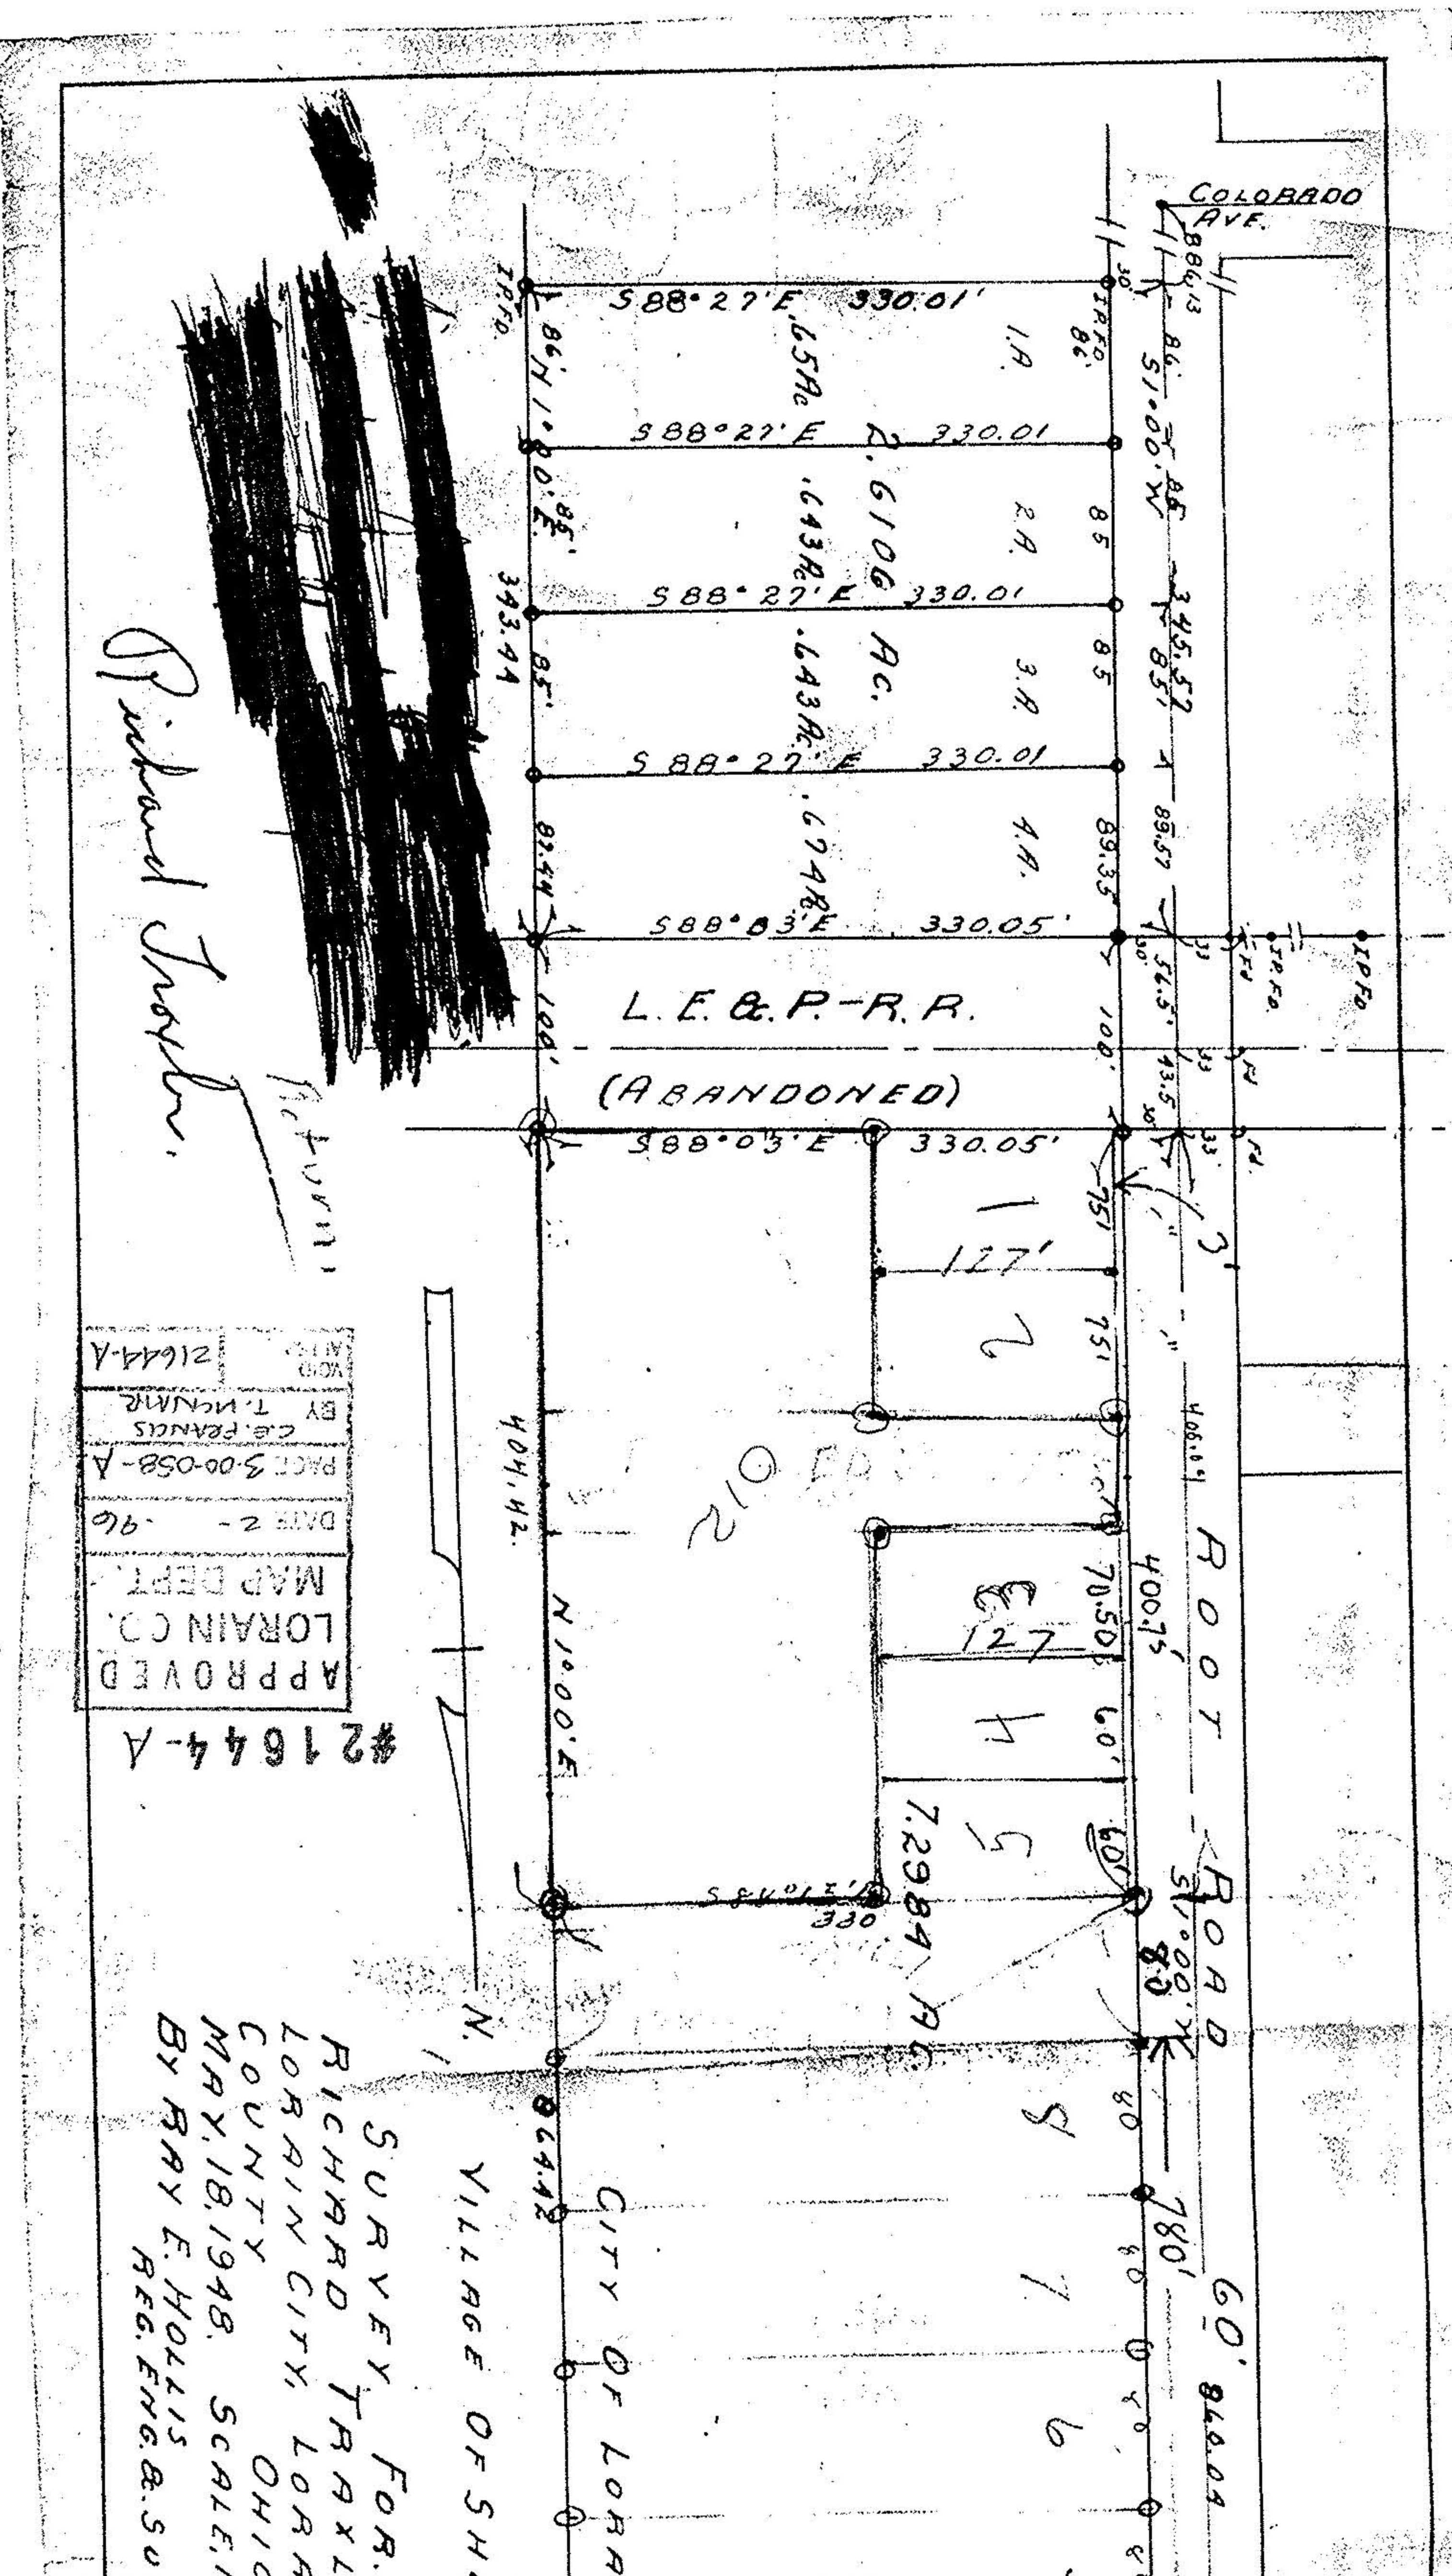

APPROVED	MAP DEPT.	DATE 2-96	FACT 3-00-058-A	BY T. MCNAMEE	21644-A
----------	-----------	-----------	-----------------	---------------	---------

#21644-A

SURVEY FOR.
 RICHARD TRAXLER
 LORAIN CITY, LORAIN
 COUNTY OHIO
 MAY, 18, 1948. SCALE: 1"=100'.
 BY RAY E. HOLLIS
 REG. ENG. & SURVEYOR.

Richard Traxler