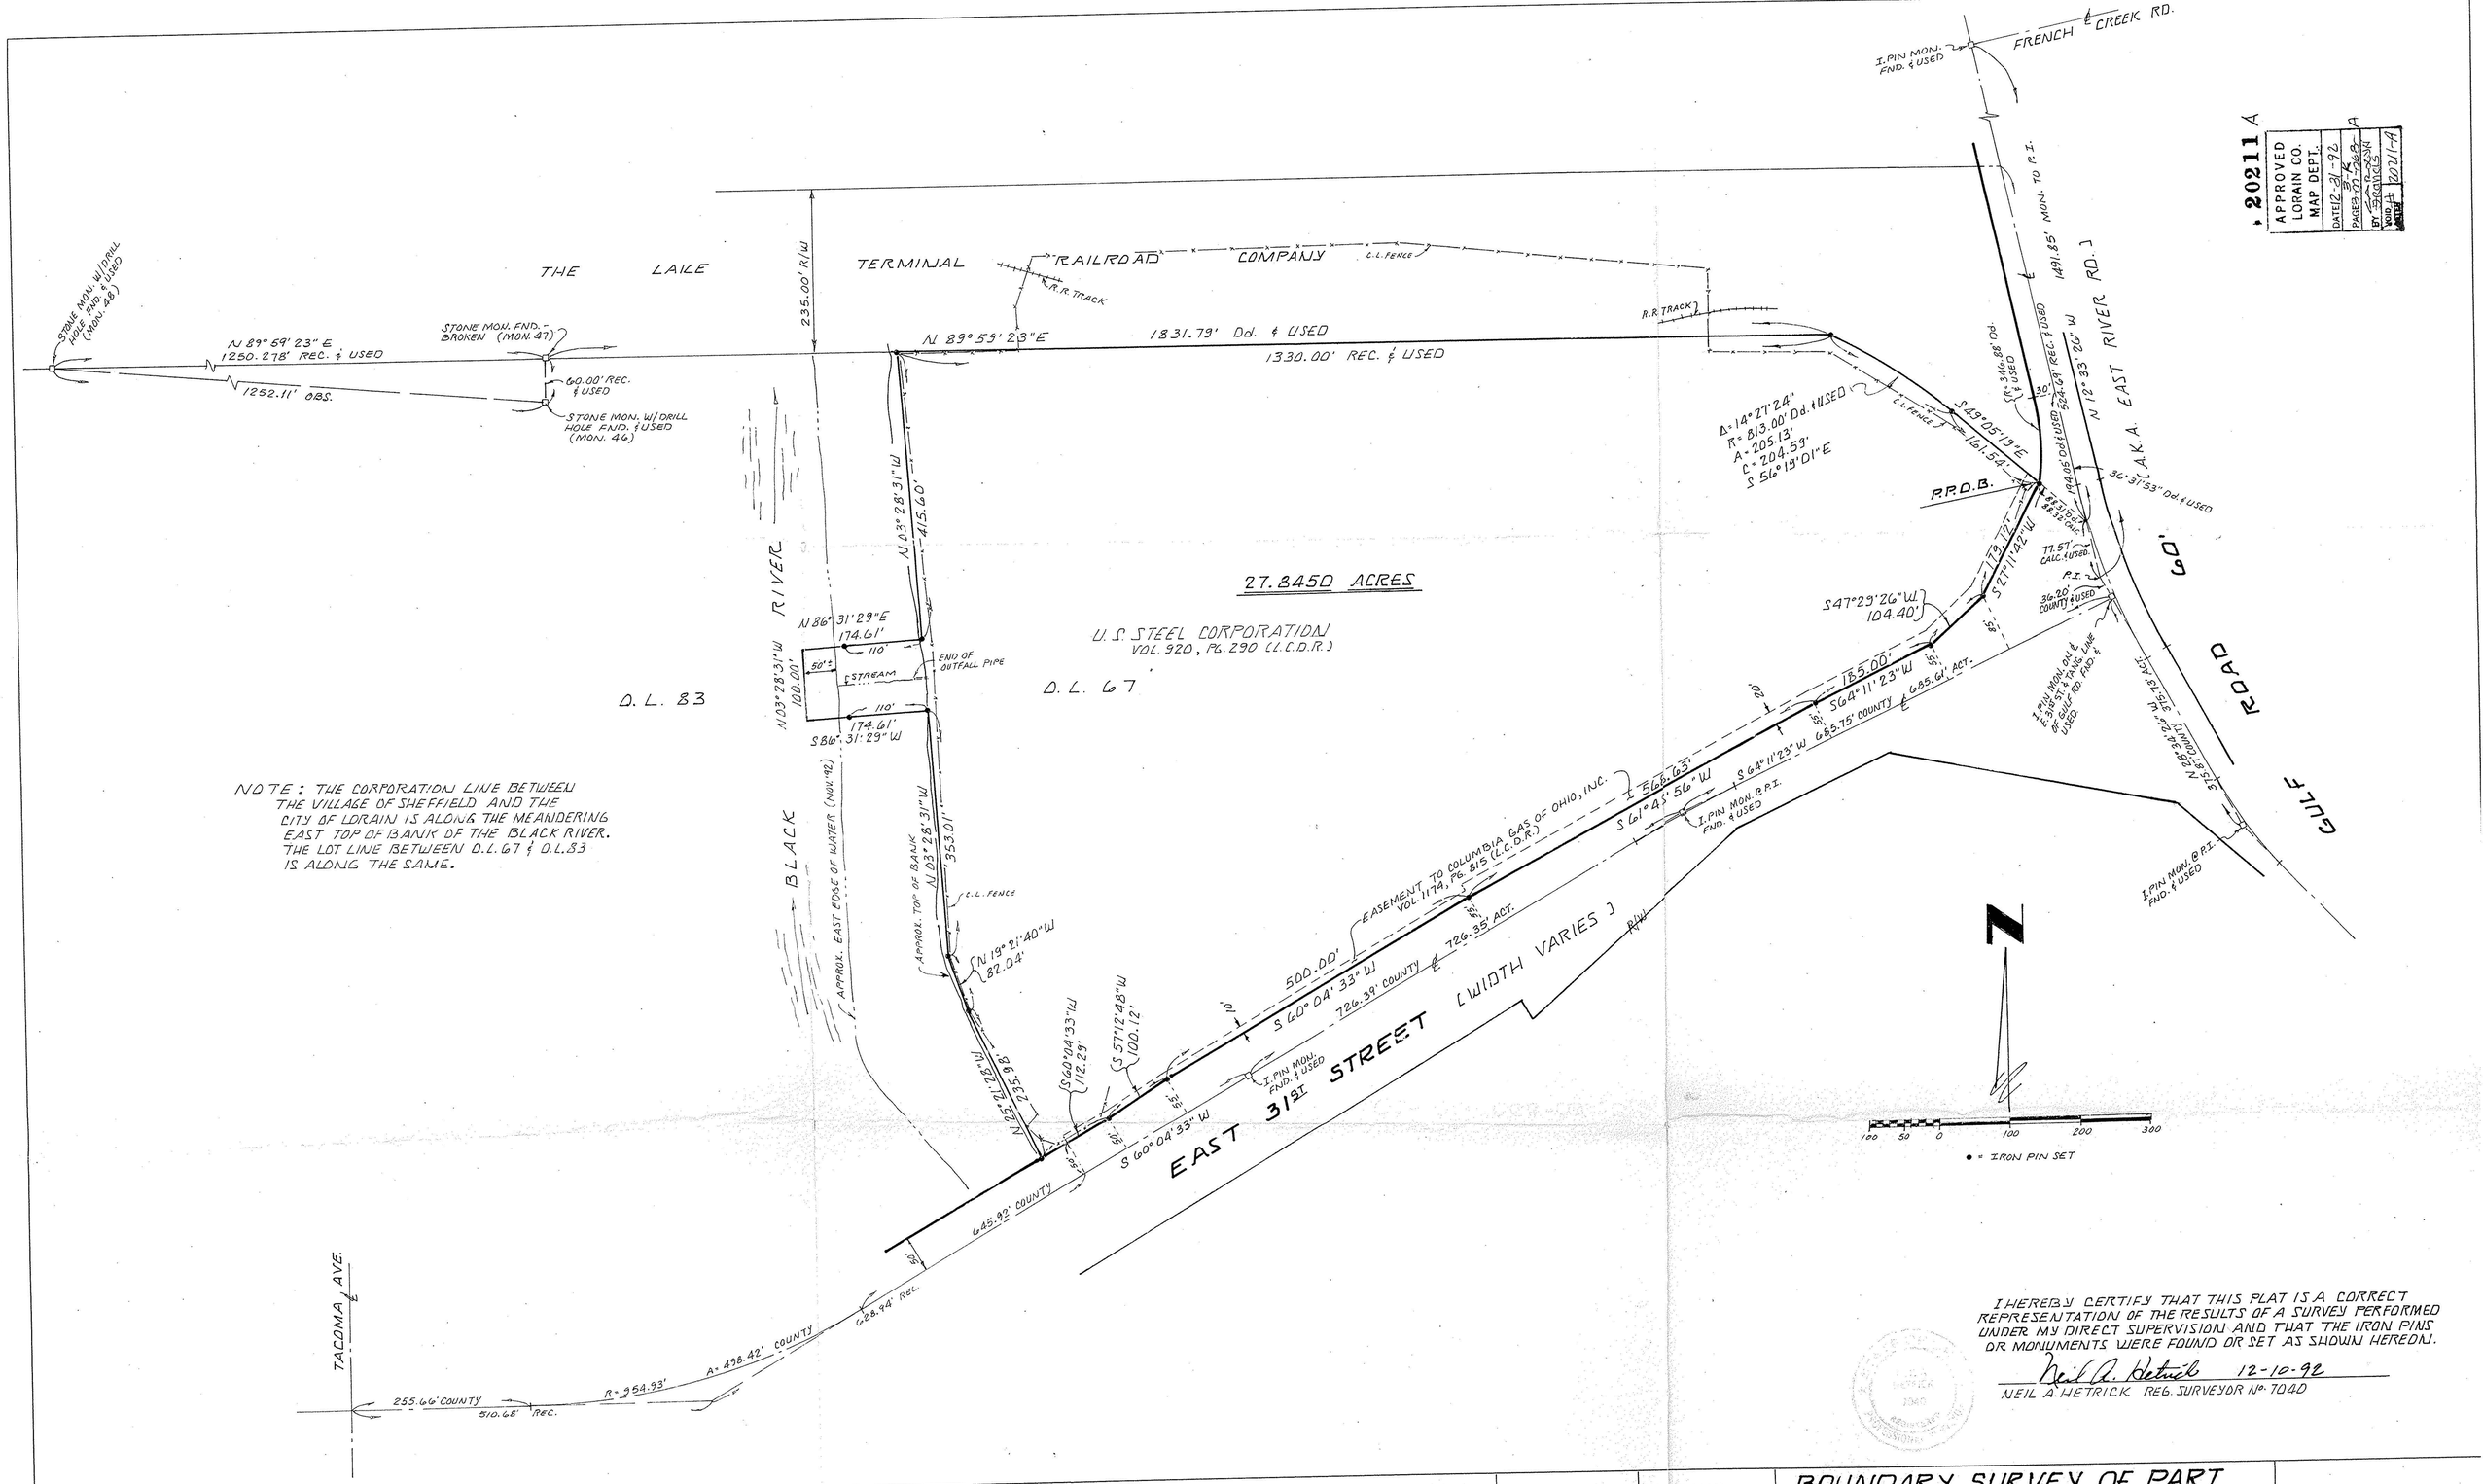

NOTE: THE CORPORATION LINE BETWEEN THE VILLAGE OF SHEFFIELD AND THE CITY OF LORAIN IS ALONG THE MEANDERING EAST TOP OF BANK OF THE BLACK RIVER. THE LOT LINE BETWEEN D.L. 67 & D.L. 83 IS ALONG THE SAME.

APPROVED LORAIN CO. MAP DEPT. DATE 12-31-92 PAGE 20-A BY R.D.S. WORK # 20211-A

20211 A

I HEREBY CERTIFY THAT THIS PLAT IS A CORRECT REPRESENTATION OF THE RESULTS OF A SURVEY PERFORMED UNDER MY DIRECT SUPERVISION AND THAT THE IRON PINS OR MONUMENTS WERE FOUND OR SET AS SHOWN HEREON.

Neil A. Hetrick 12-10-92

NEIL A. HETRICK REG. SURVEYOR No. 7040

NO.	DATE	DESCRIPTION	BY

REVISIONS

Rev. 7/23/73	LAKE TERMINAL R.R. Co. STATION MAP # V-1 / SL-2
6/89	USX PROPERTY SURVEY BY R.E. WARNER & ASSOC. #34488
5/2/75	LORAIN COUNTY - EAST 31ST STREET R/W PLANS

REFERENCE DRAWINGS

R.E. WARNER & ASSOCIATES

GEMINI TOWERS II
2001 CROCKER ROAD
WESTLAKE, OHIO 44145

DR. BY NAH
CHK. BY
APR. BY
DATE DEC. 10, 1992
SCALE 1" = 100'

BOUNDARY SURVEY OF PART OF U.S. STEEL CORPORATION LAND FOR LUKENS INC.

BEING PART OF ORIGINAL SHEFFIELD TWP. LOT Nos. 67 & 83, NOW IN THE VILLAGE OF SHEFFIELD AND THE CITY OF LORAIN, COUNTY OF LORAIN, STATE OF OHIO.

JOB No. 85292