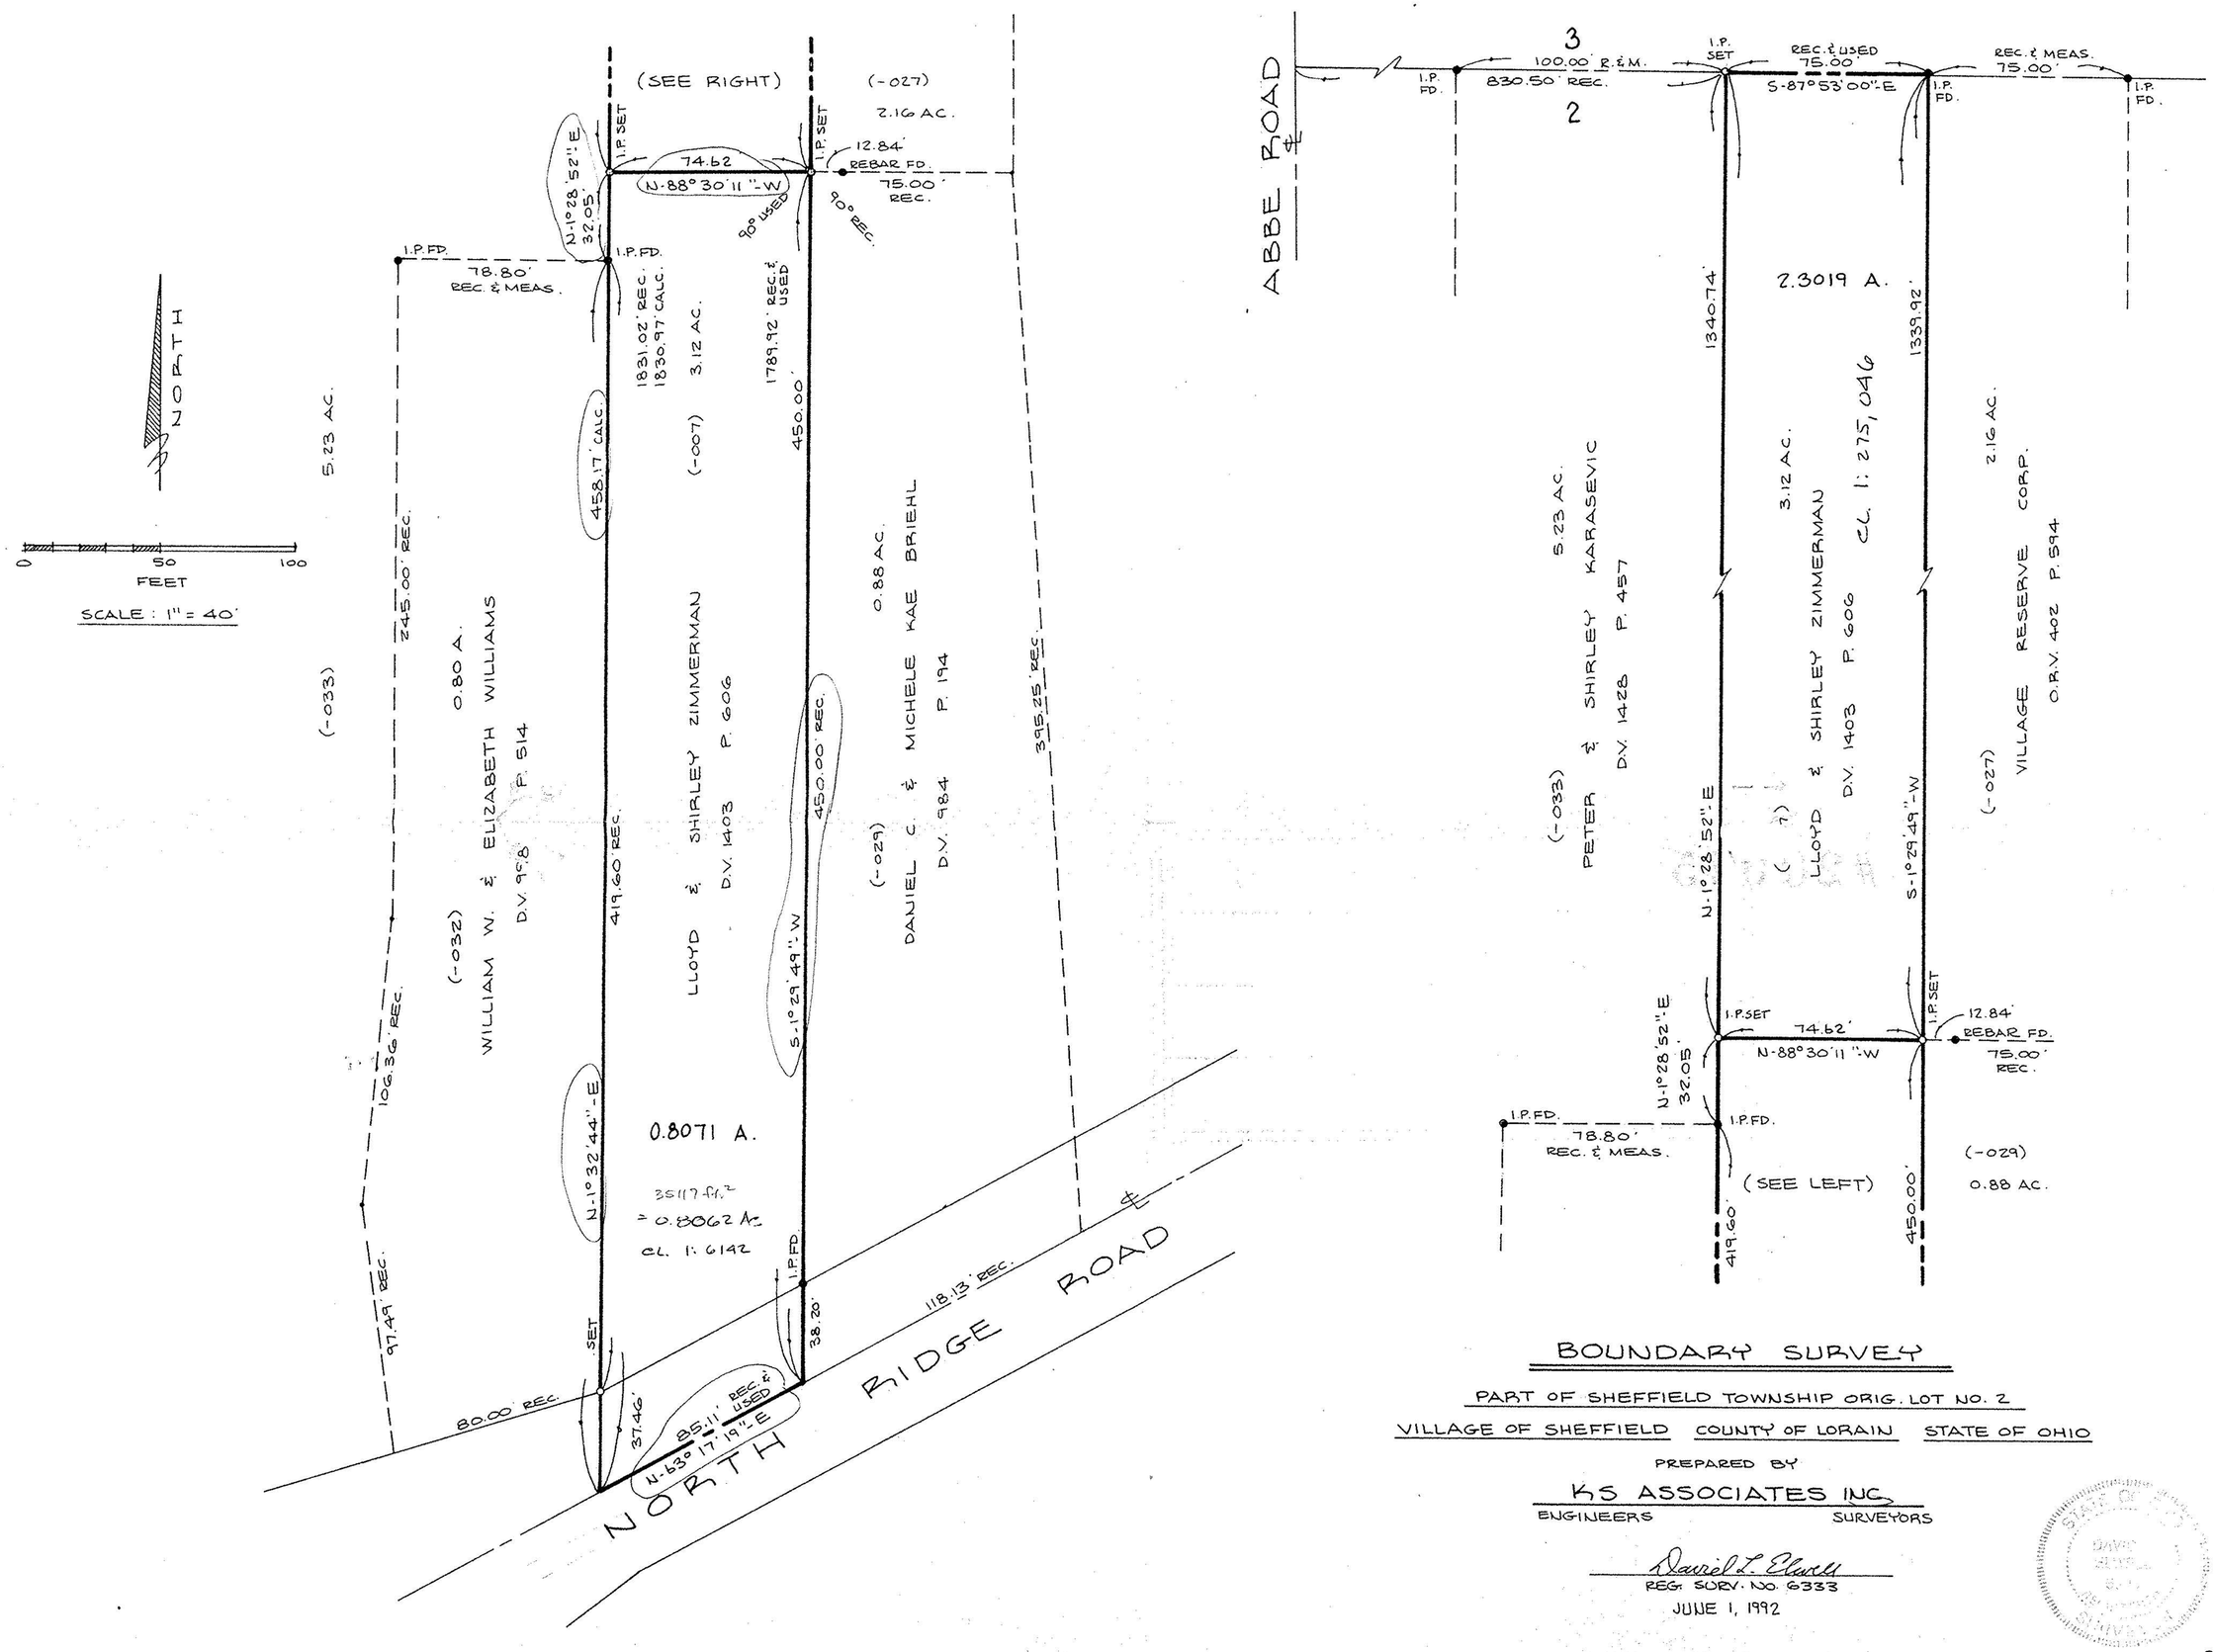

BOUNDARY SURVEY

PART OF SHEFFIELD TOWNSHIP ORIG. LOT NO. 2

VILLAGE OF SHEFFIELD COUNTY OF LORAIN STATE OF OHIO

PREPARED BY

KS ASSOCIATES INC.

ENGINEERS SURVEYORS

Daniel L. Elwell

REG. SURV. NO. 6333

JUNE 1, 1992

STATE OF OHIO DANIEL L. ELWELL 6333 REGISTERED SURVEYOR

92-215

3-00-002-A

03-00-002-101-007 3.12A