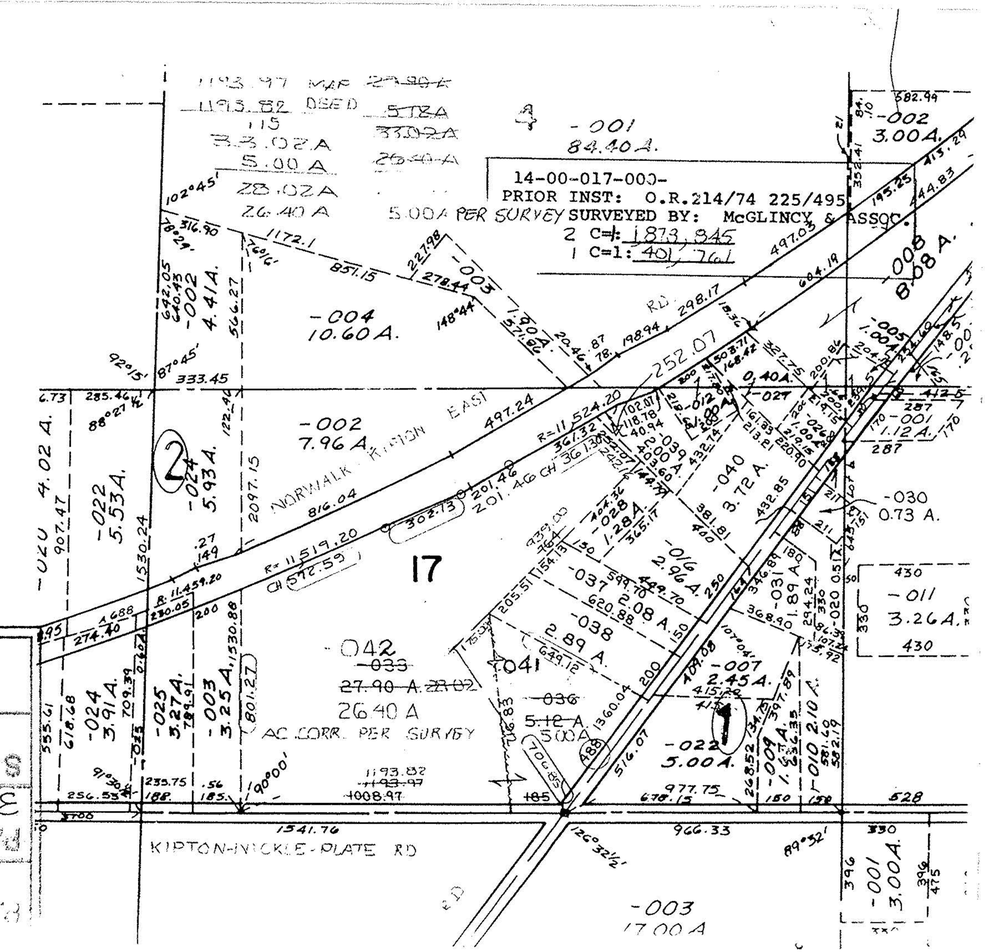
14-00-017-000-
PRIOR INST: O.R.214/74 225/495
SURVEYED BY: McGLINCY & ASSOC.
2 C=1: 1873.845
1 C=1: 401.761
5.00A PER SURVEY
NORWALK-KIPTON EAST
KIPTON-NICKLE-PLATE RD
AC CORR. PER SURVEY
17
-001 84.40A.
-002 3.00A.
-004 10.60A.
-002 7.96A.
-022 5.53A.
-024 5.93A.
-024 3.91A.
-025 3.27A.
-003 3.25A.
-040 3.72A.
-016 2.96A.
-038 2.89A.
-007 2.45A.
-022 5.00A.
-011 3.26A.
-030 0.73A.
-001 1.12A.
-003 17.00A.
-001 3.00A.
-042 26.40A

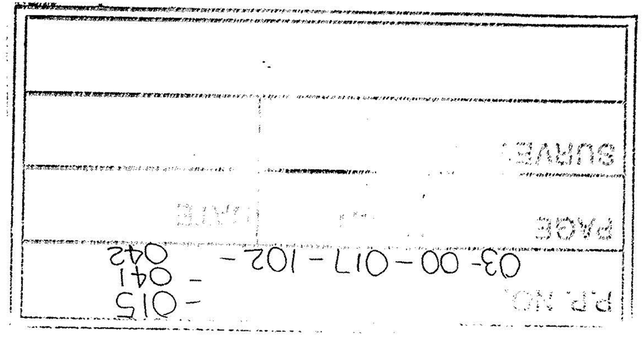
P.P. NO.
03-00-017-102-
-015
-041
-042
PAGE
SURVEY

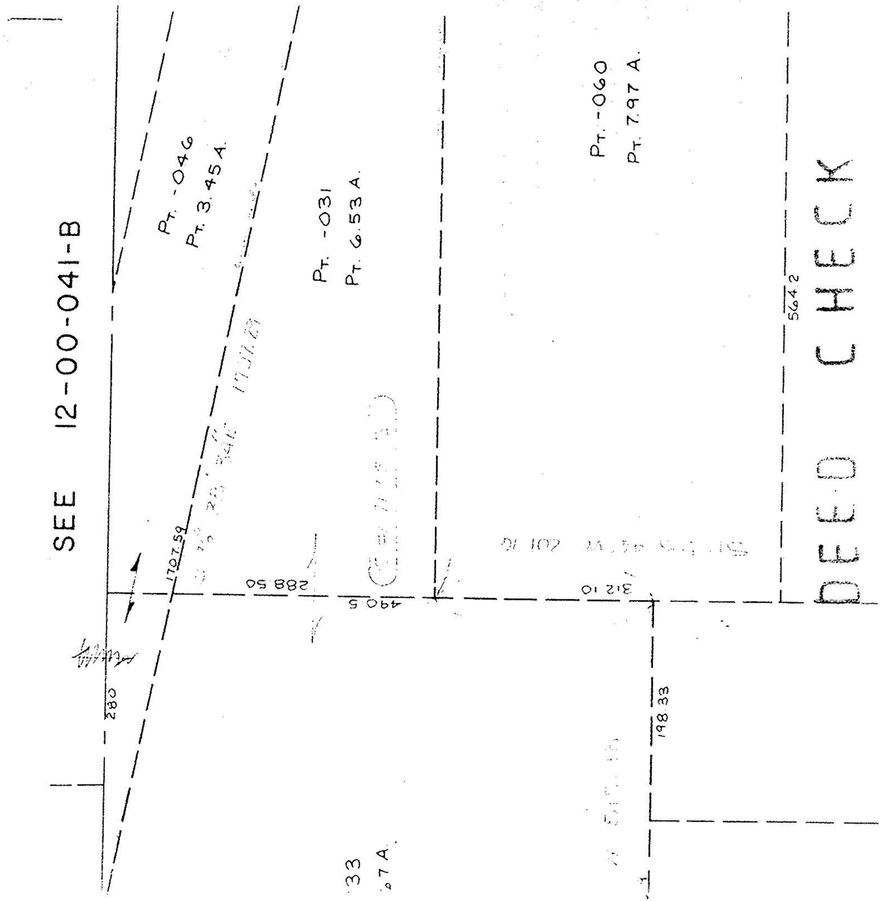
SEE 12-00-041-B
DEED CHECK
Pt. -046
Pt. 3.45A.
Pt. -031
Pt. 6.53A.
Pt. -060
Pt. 7.97A.