MAP OF SURVEY

of lands Owned by VICTOR & ROSELLA GORNALL AND ARTHUR & LEONA BRYDEN
made at the Instance of: **DREXEL SHEFFIELD LTD PARTNERSHIP**

SITUATED IN THE VILLAGE OF SHEFFIELD, COUNTY OF LORAIN AND STATE OF OHIO AND KNOWN AS BEING PART OF ORIGINAL SHEFFIELD TOWNSHIP LOT Nº 11

IRON MONUMENTS WERE FOUND OR SET AS SHOWN HEREON. ALL DIMENSIONS ARE EXPRESSED IN FEET AND DECIMAL PARTS, BEARINGS ARE TO AN ASSUMED MERIDEAN AND USED TO DESCRIBE ANGLES ONLY. THIS IS A TRUE RETURN OF A FIELD SURVEY PERFORMED BY ME, CORRECT TO THE BEST OF MY ABILITY AND BELIEF.

William J. Vondra 4/11/90
WILLIAM J. VONDRA
PROFESSIONAL SURVEYOR Nº 5849 OHIO

STATE OF OHIO — WILLIAM J. VONDRA 5849 — REGISTERED SURVEYOR

Western Reserve Engineering & Surveying Co.
DIVISION OF W.R.E.S. CORPORATION
5500 BROADVIEW ROAD / CLEVELAND, OHIO 44134 / 216/351-9320

NORTH
SCALE - 1" = 40'
REVISION - 7/10/90 - SIGN ESMT AS RECORDED

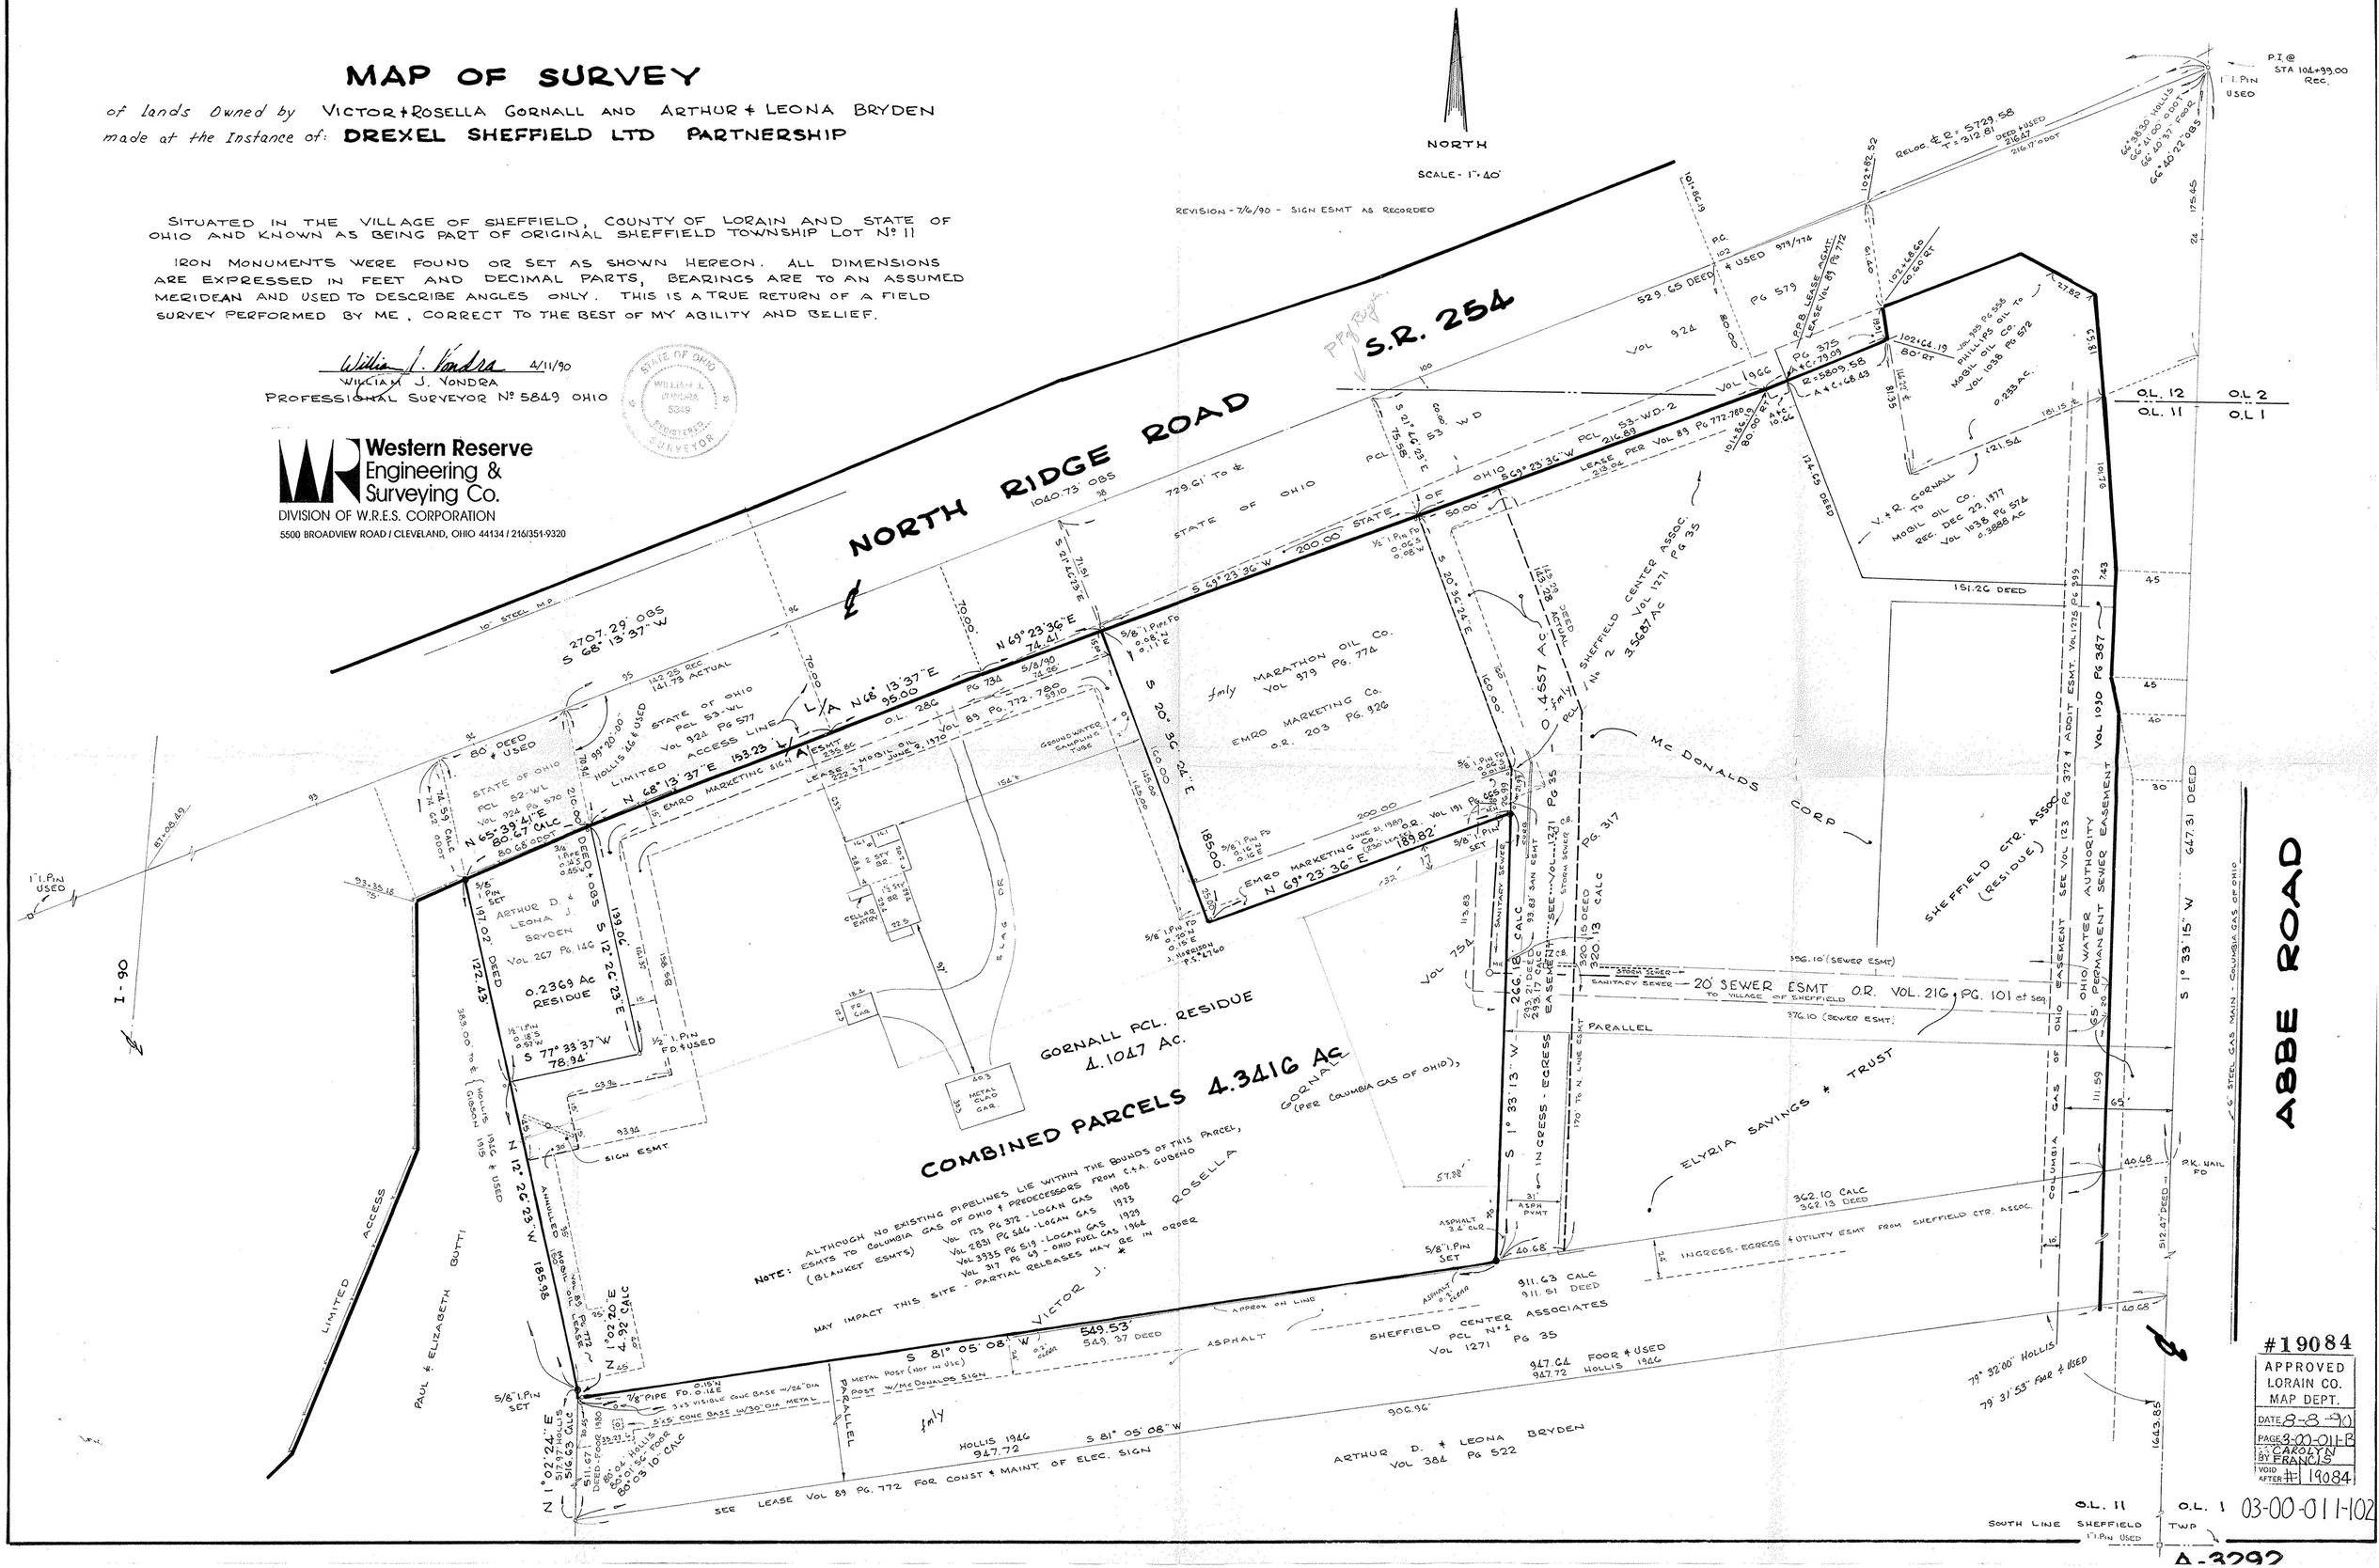

#19084
APPROVED LORAIN CO. MAP DEPT.
DATE 8-8-90
PAGE 3-00-011-B
BY CAROLYN FRANCIS
VOID AFTER # 19084

A-3292