03-00-011

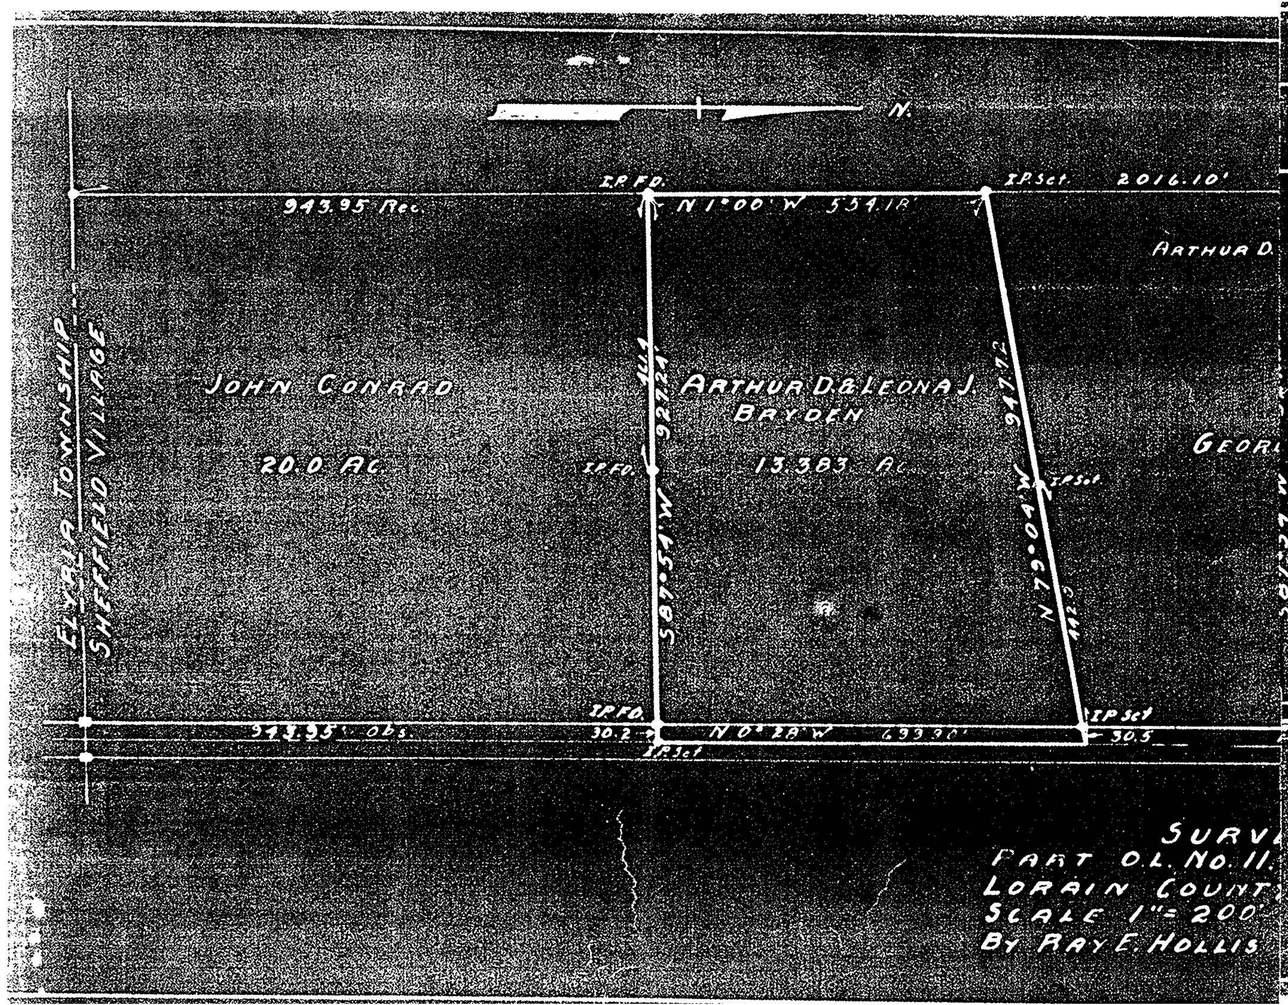
N.
943.95 Rec.
I.P.Fd.
N 1°00' W 554.18'
I.P.Set. 2016.10'
ARTHUR D.
ELYRIA TOWNSHIP
SHEFFIELD VILLAGE
JOHN CONRAD
20.0 AC.
ARTHUR D.& LEONA J. BRYDEN
13.383 AC.
927.24'
S 87°54' W
947.72
N 79°04' W
I.P.Set.
I.P.Fd.
943.95' obs.
30.2
N 0°28' W 699.90'
I.P.Set
30.5
SURV
PART O.L. NO. 11.
LORAIN COUNT
SCALE 1" = 200'
BY RAY E. HOLLIS

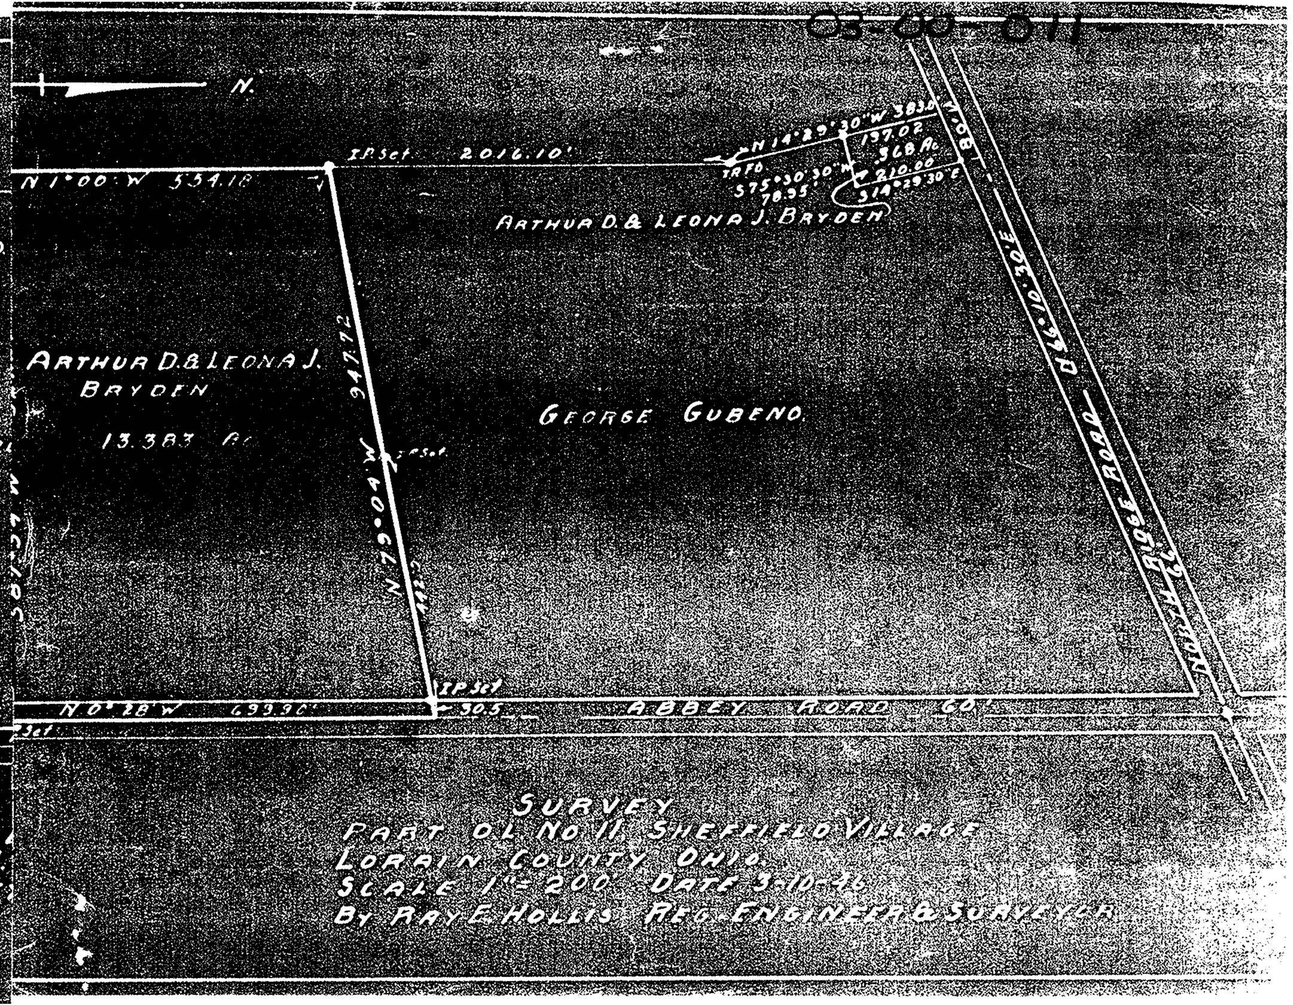
N.
I.P.Set. 2016.10'
N 1°00' W 554.18'
ARTHUR D.& LEONA J. BRYDEN
ARTHUR D.& LEONA J. BRYDEN
13.383 AC.
947.72
N 79°04' W
GEORGE GUBENO.
I.P.Set.
I.P.Set
N 0°28' W 699.90'
30.5
ABBEY ROAD 60'
SURVEY
PART O.L. NO. 11 SHEFFIELD VILLAGE
LORAIN COUNTY OHIO
SCALE 1" = 200' DATE 3-10-46
BY RAY E. HOLLIS REG. ENGINEER & SURVEYOR