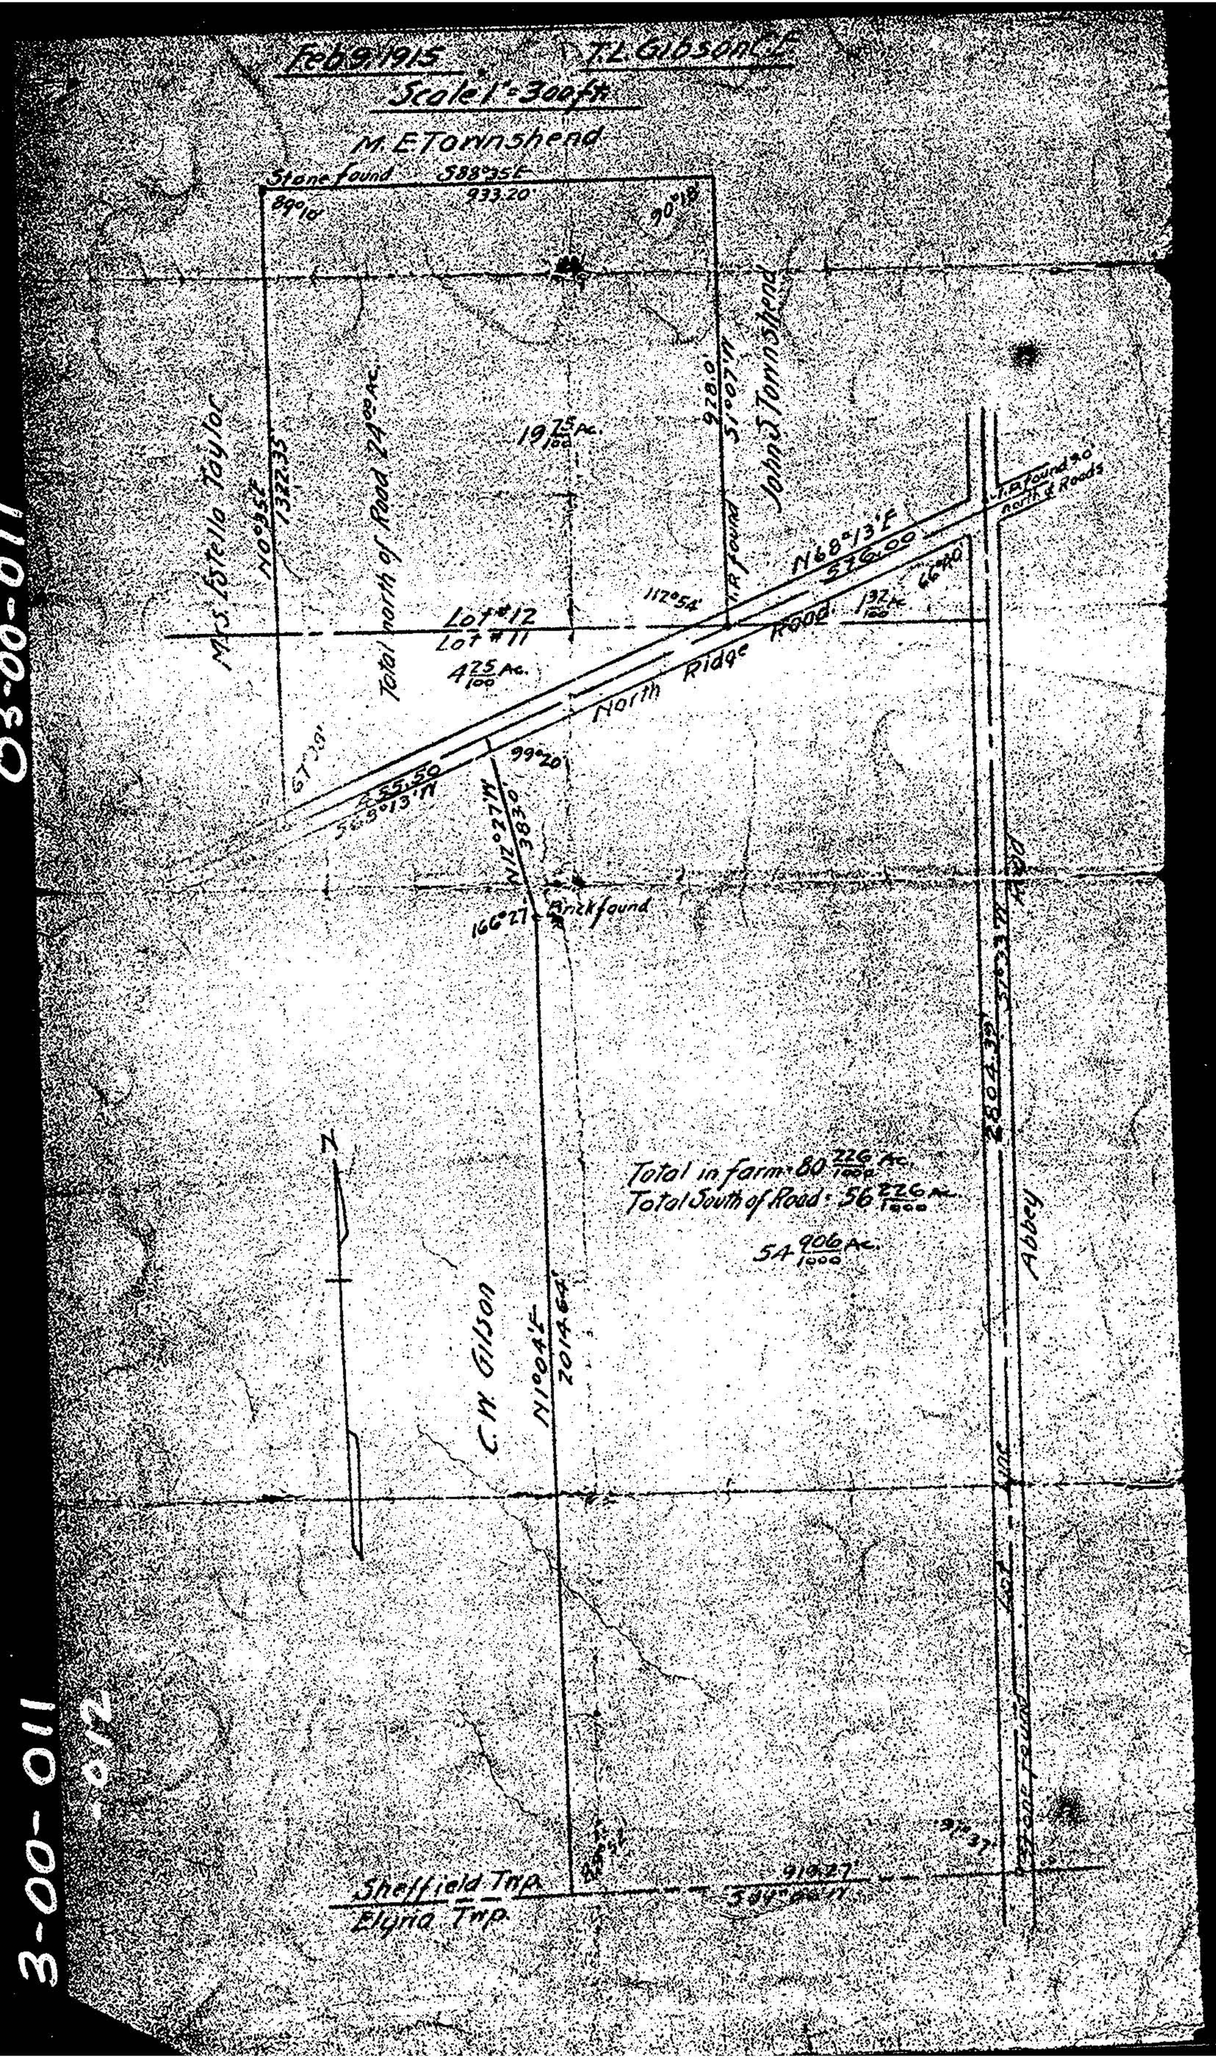
Feb 9, 1915
T.L. Gibson C.E.
Scale 1" = 300 ft.
M. E. Townshend
Stone found
S88°35'E
933.20'
89°10'
90°18'
Mrs. Estella Taylor
N0°35'E
1322.35'
Total north of Road 24.00 Ac.
19 75/100 Ac.
928.0'
S1°07'W
John S. Townshend
I.R. found
I.R. found 9.0' north of Roads
N68°13'E
576.00
112°54'
Lot #12
Lot #11
4 25/100 Ac.
North Ridge Road
1 32/100 Ac.
66°40'
67°39'
455.50
S68°13'W
99°20'
N12°27'W
383.0'
166°27'
Brick found
2804.39'
Abbey
Total in farm = 80 226/1000 Ac.
Total South of Road = 56 226/1000 Ac.
54 906/1000 Ac.
N
C.W. Gilson
N1°04'E
2014.64'
Lot line
Stone found
Sheffield Twp.
Elyria Twp.
919.27'
S89°00'W

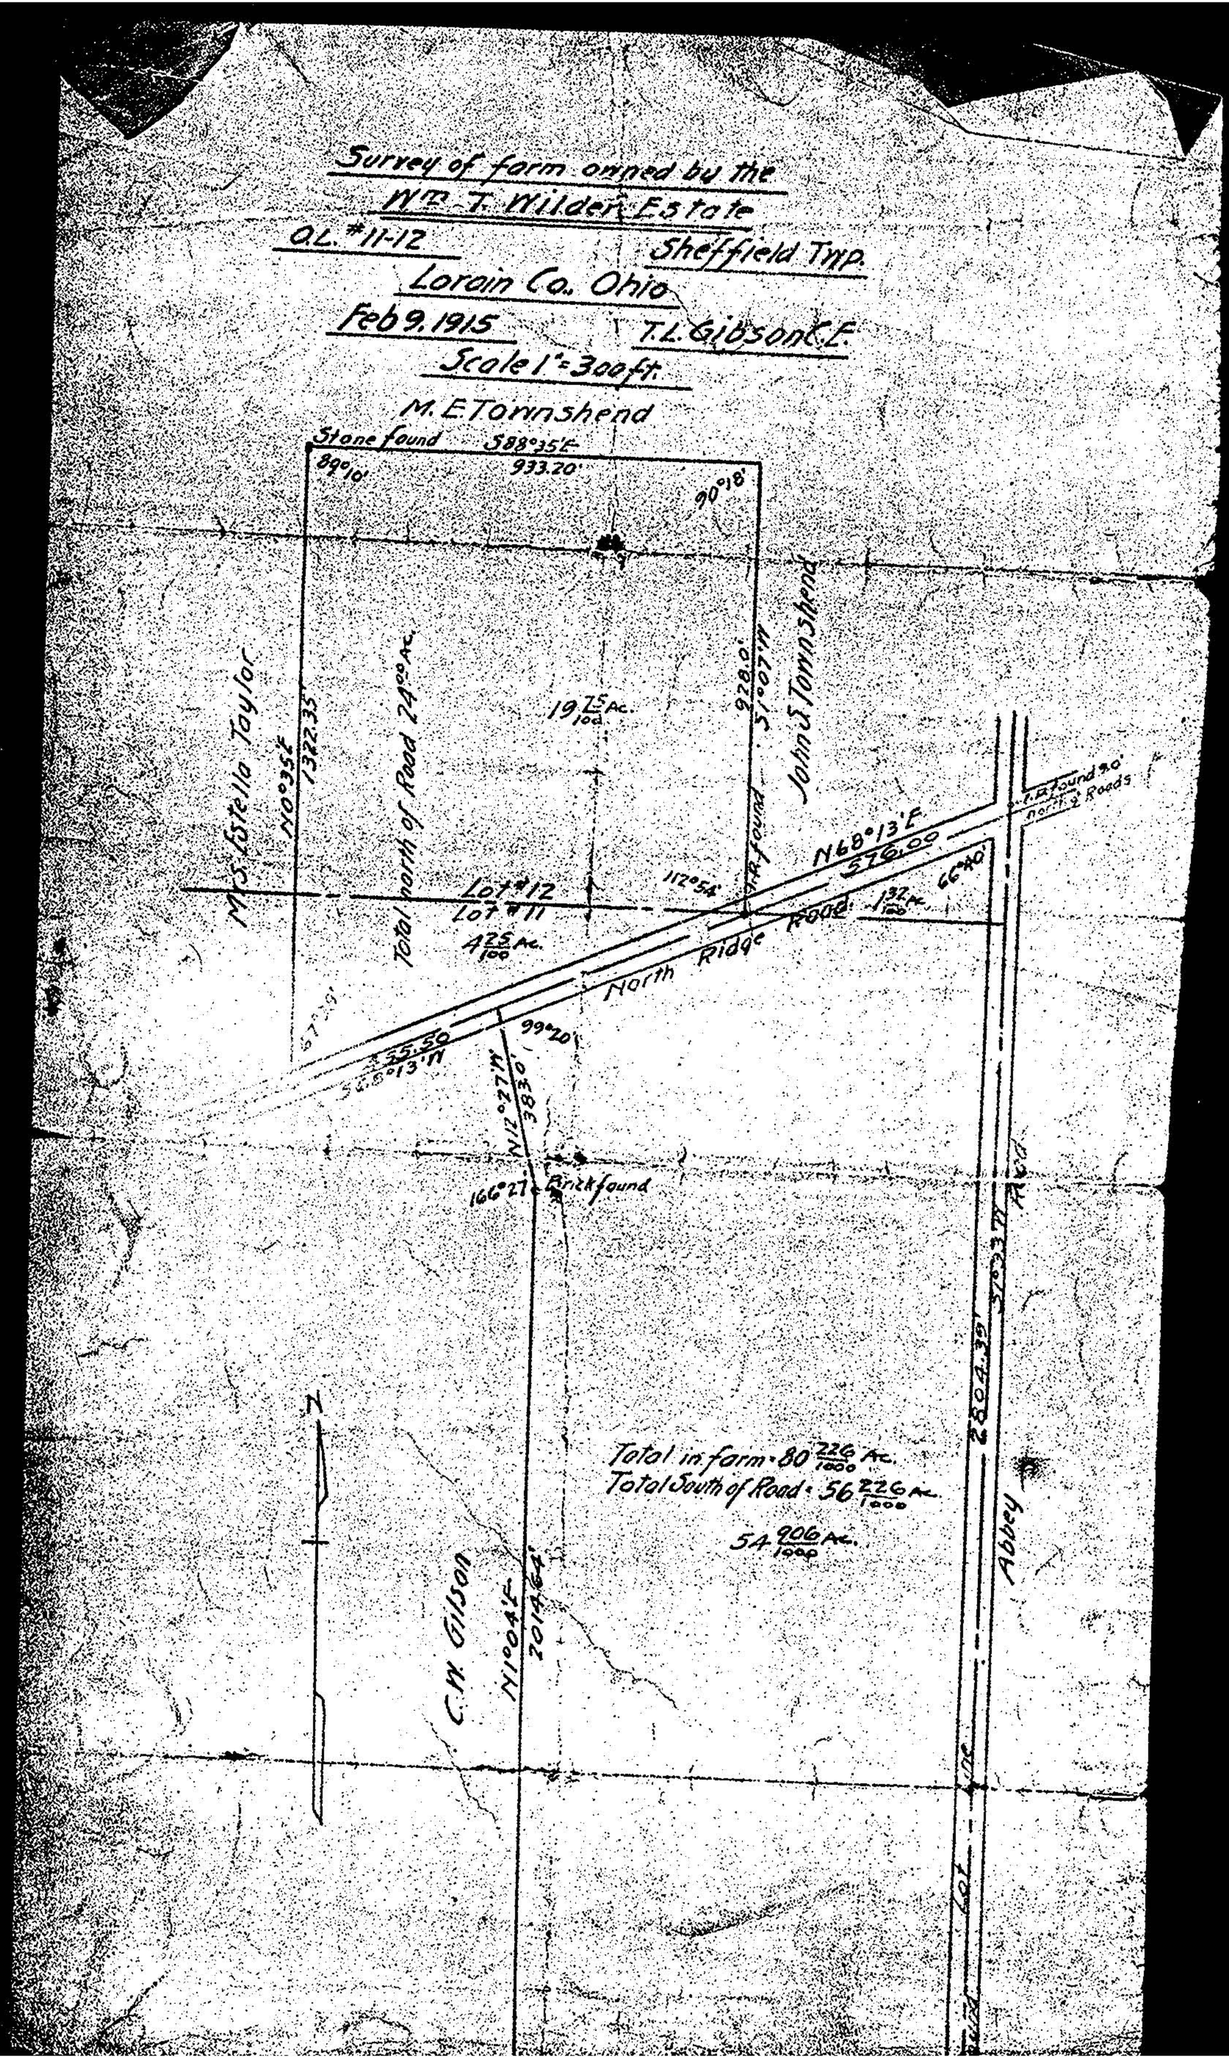
Survey of farm owned by the
Wm. T. Wilder Estate
O.L. #11-12
Sheffield Twp.
Lorain Co. Ohio
Feb 9, 1915
T.L. Gibson C.E.
Scale 1" = 300 ft.
M. E. Townshend
Stone found
S88°35'E
933.20'
89°10'
90°18'
Mrs. Estella Taylor
N0°35'E
1322.35'
Total north of Road 24.00 Ac.
19 75/100 Ac.
928.0'
S1°07'W
John S. Townshend
I.R. found
I.R. found 9.0' north of Roads
N68°13'E
576.00
112°54'
Lot #12
Lot #11
4 25/100 Ac.
North Ridge Road
1 32/100 Ac.
66°40'
67°39'
455.50
S68°13'W
99°20'
N12°27'W
383.0'
166°27'
Brick found
2804.39'
Abbey
Total in farm = 80 226/1000 Ac.
Total South of Road = 56 226/1000 Ac.
54 906/1000 Ac.
N
C.W. Gilson
N1°04'E
2014.64'
Lot line

3-00-011
-012