ER · SCHMIDT
ASSOCIATES
SURVEYORS —— CONSULTANTS in LAND PLANNING
OHIO

SURVEY

Sublot(s) BLOCK 'A'

Subd'n BROOKSIDE ESTATES SUBDIVISION NO.1

Tract

Sec.

State of Ohio

#11932

APPROVED
LORAIN CO.
MAP DEPT.
DATE 8-11-78
PAGE 03-00-013-13
BY C. Francis
VOID AFTER 11932

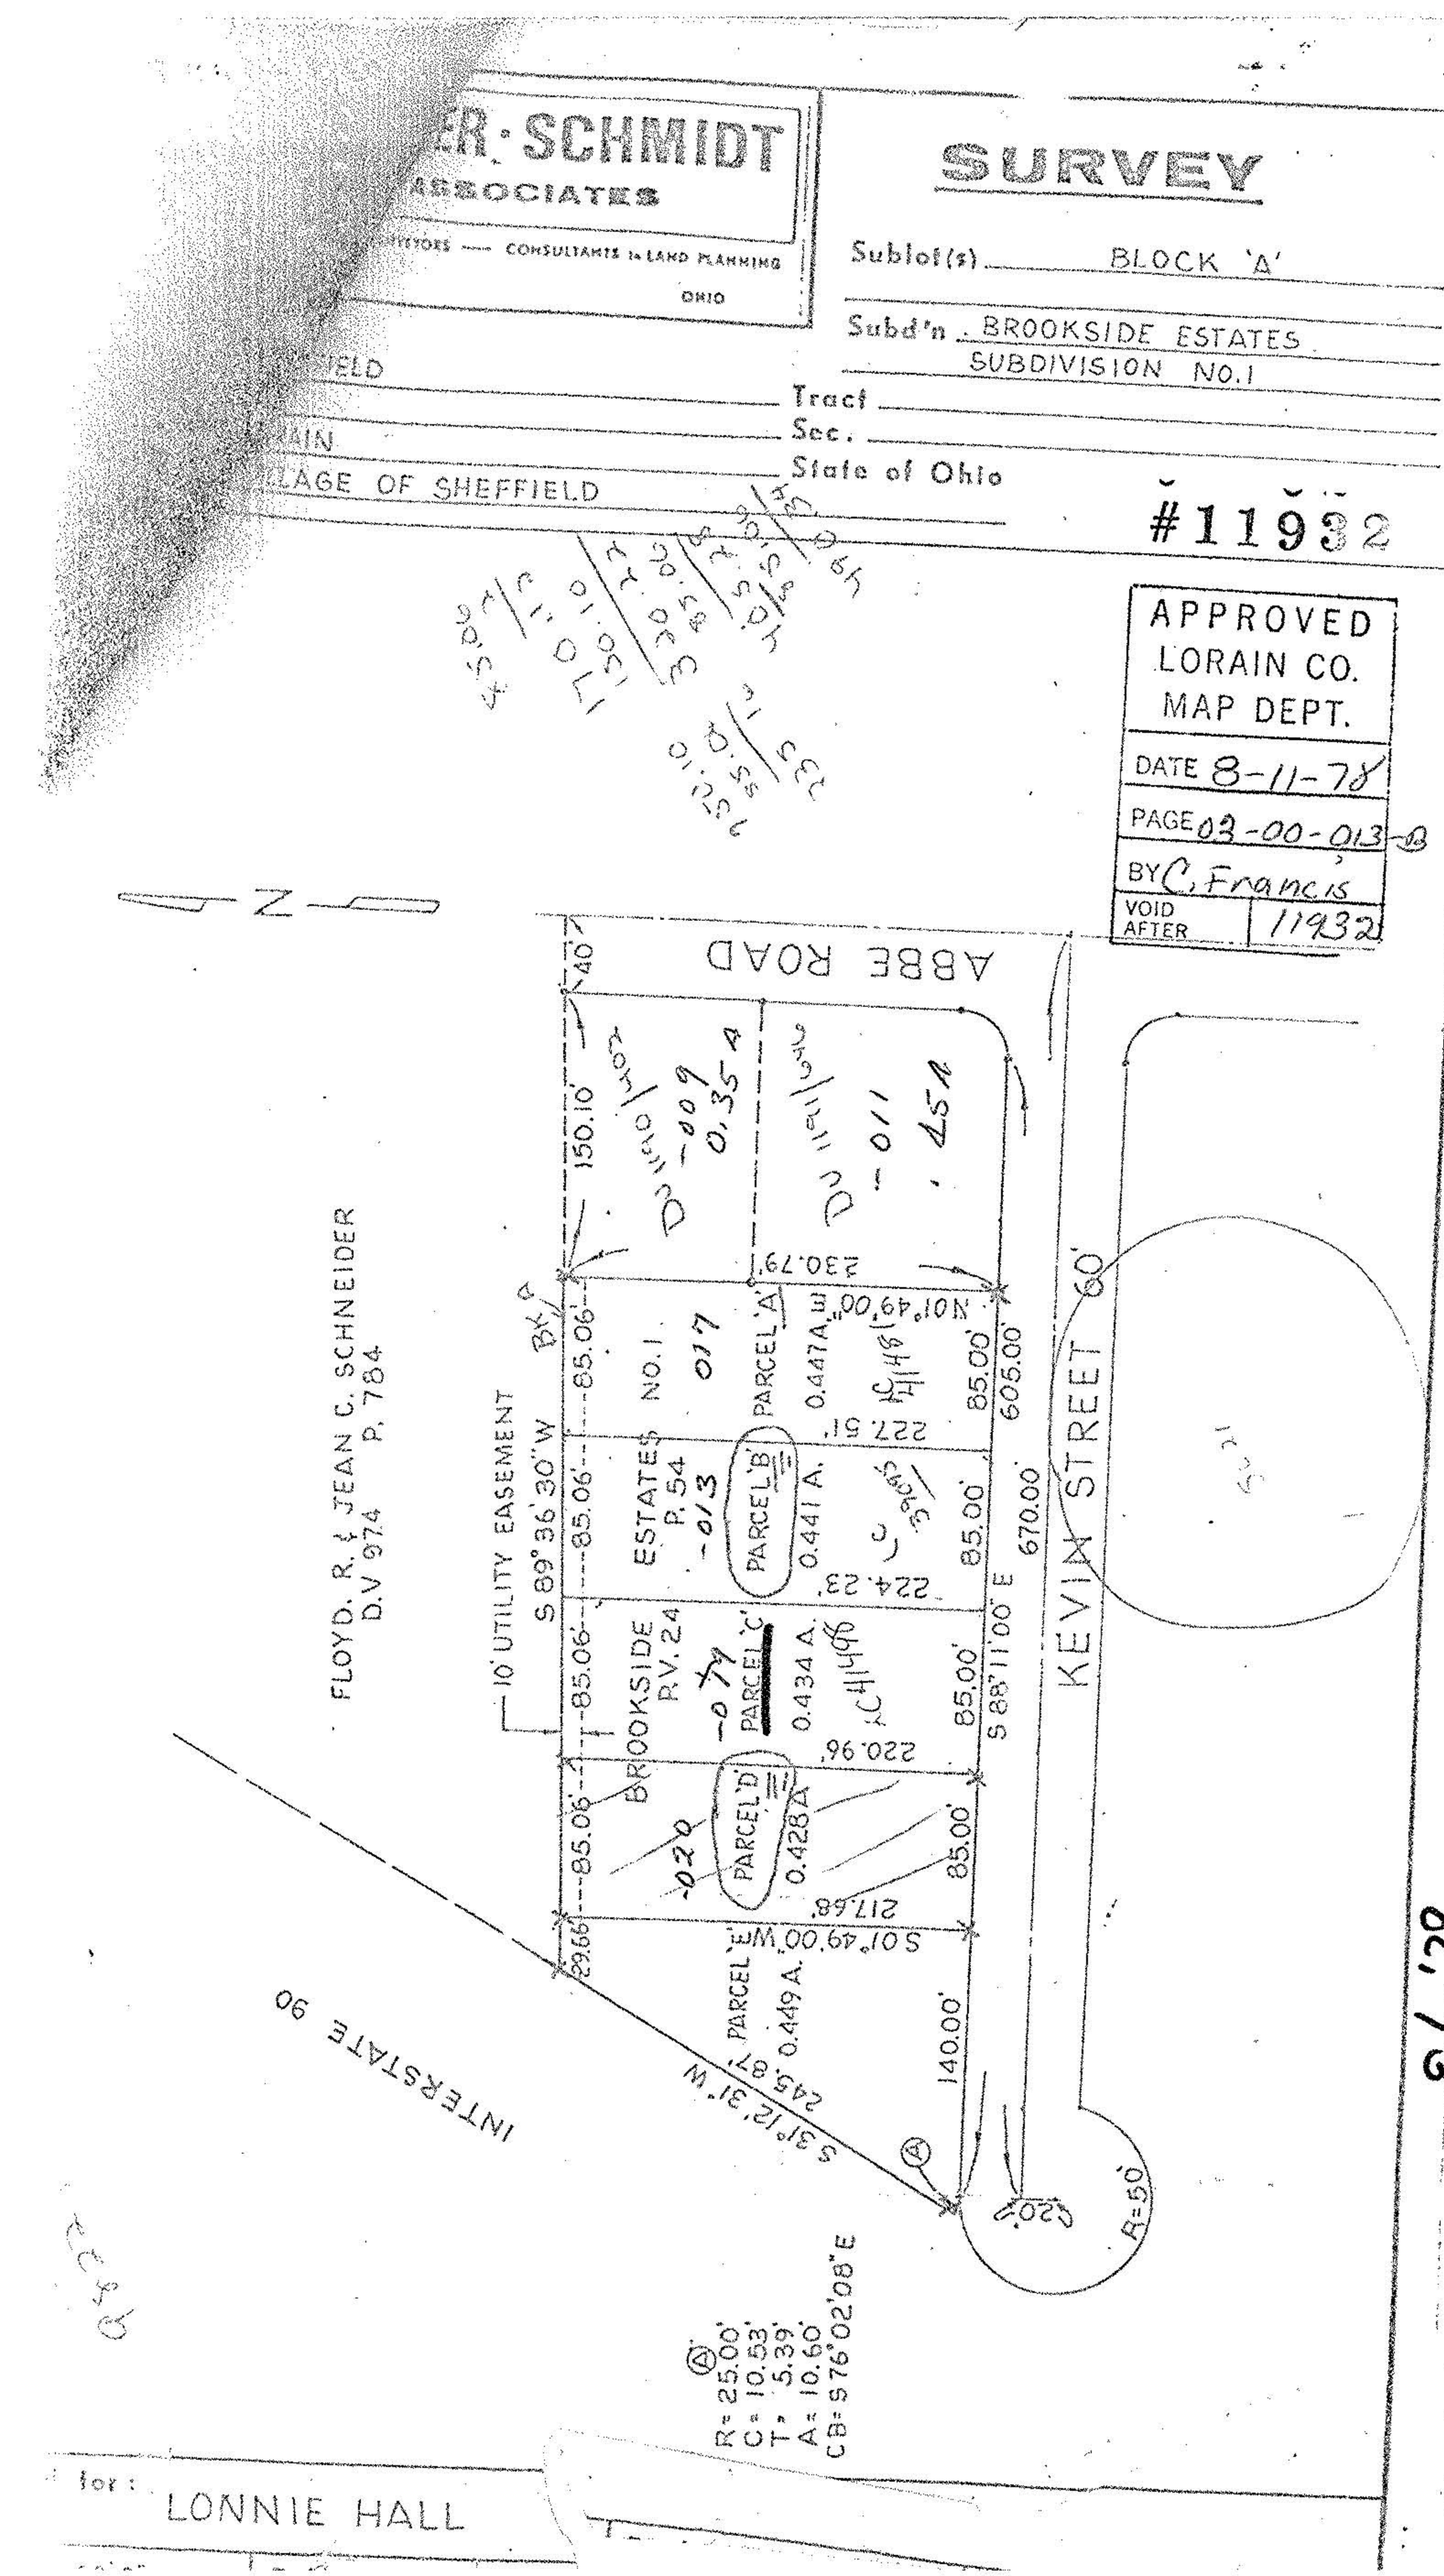

for: LONNIE HALL

03-00-013-13