


Abbe Rd

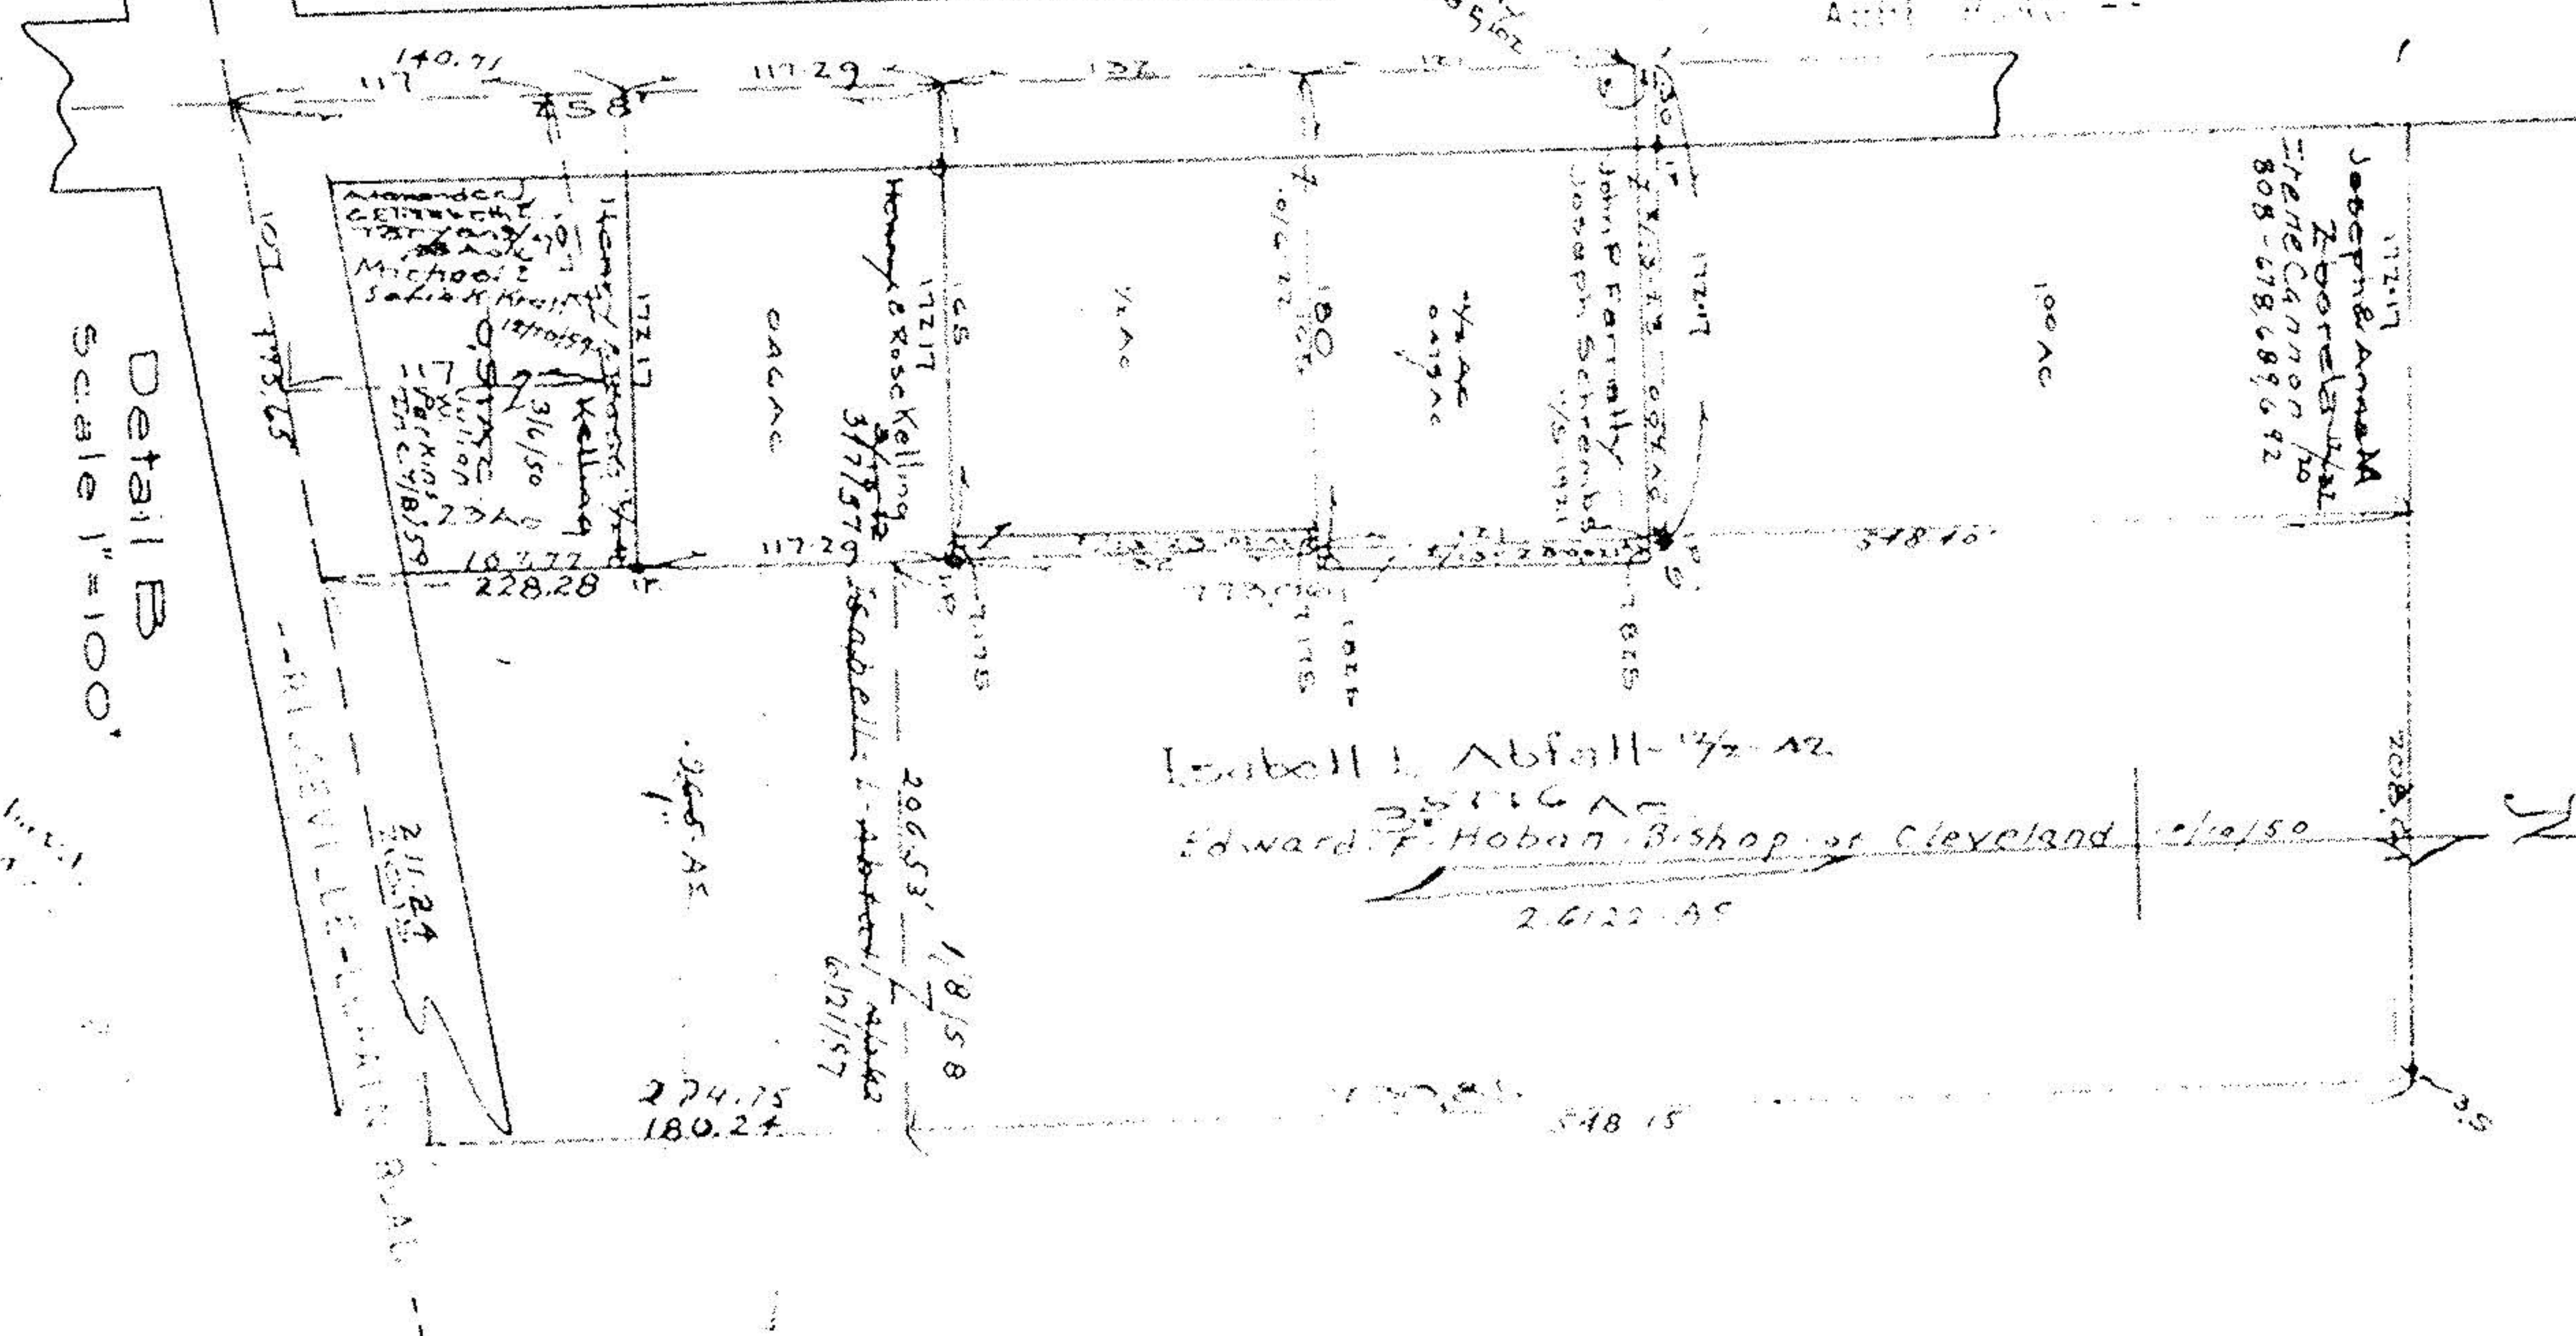

Detail B  
Scale 1"=100'

SHEFFIELD TWP  
Scale 1"=400'