
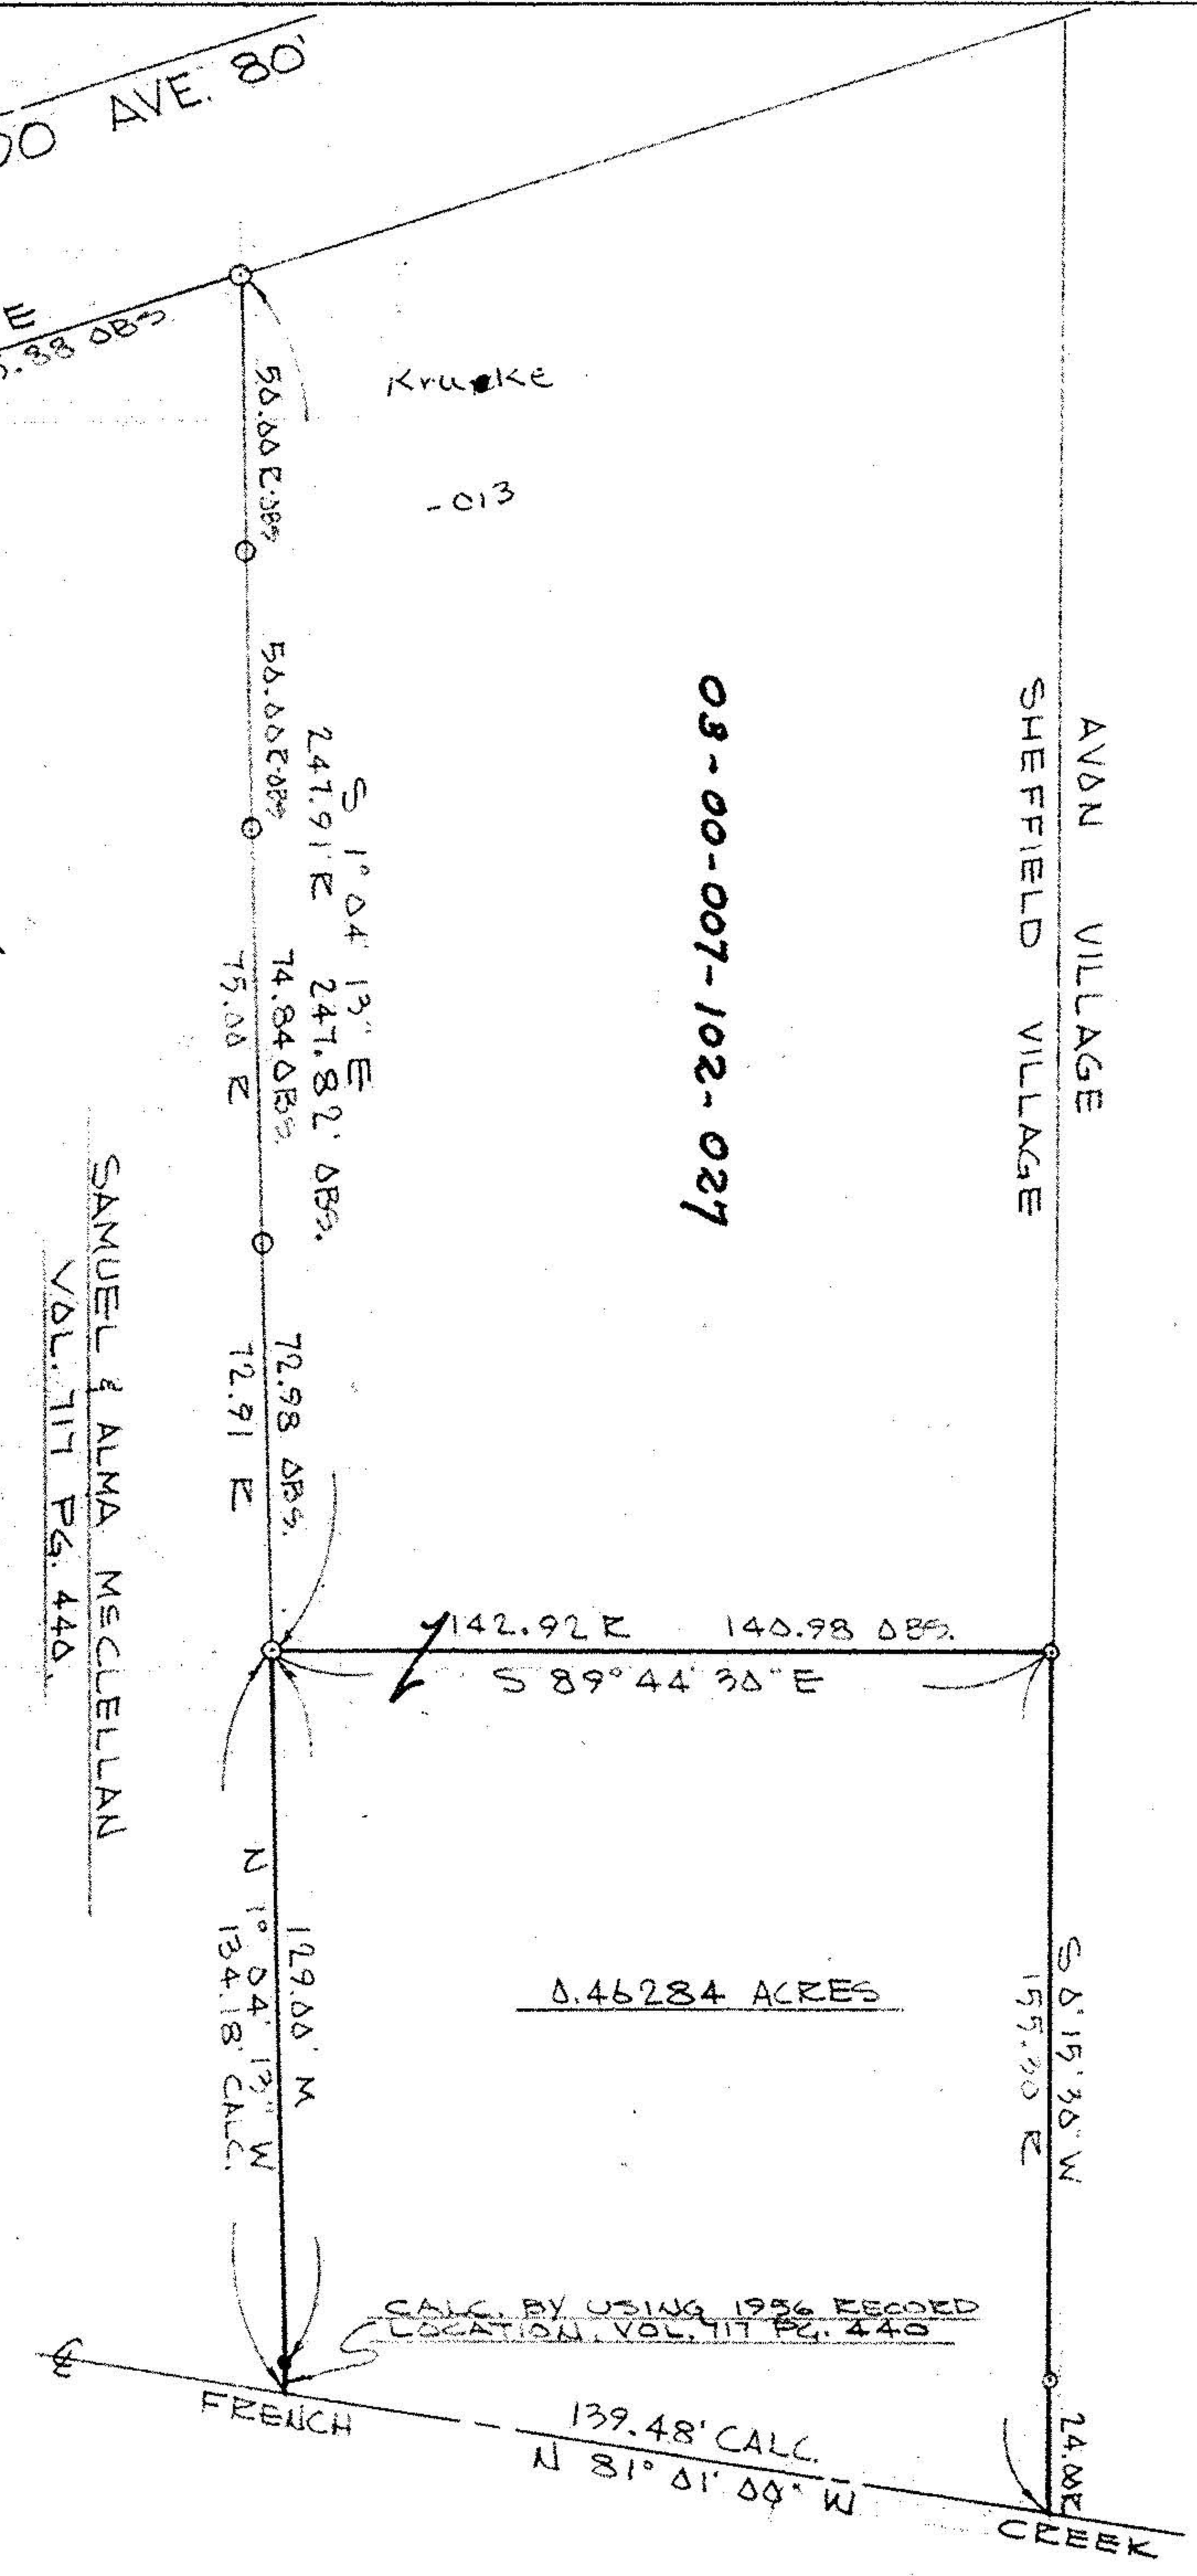


SOVEY  
 ALMA McCLELLAN  
 5788 COLORADO AVE.  
 LORAIN, OHIO

**SCHAFER, HURA & ASSOCIATES, INC.**

ENGINEERS AND SURVEYORS  
 4856 OBERLIN AVE.  
 LORAIN, OHIO

ORIGINAL LOT 7 DATE 8-10-73  
 TOWNSHIP SHEFFIELD SCALE 1"=40'  
 CITY OF LORAIN FIELD BOOK 221 Pg.  
 COUNTY OF LORAIN DRAWN BY JER  
 STATE OF OHIO CHECKED BY J.L.M.  
 N.O. 2030 FILE NO. 3-25-57

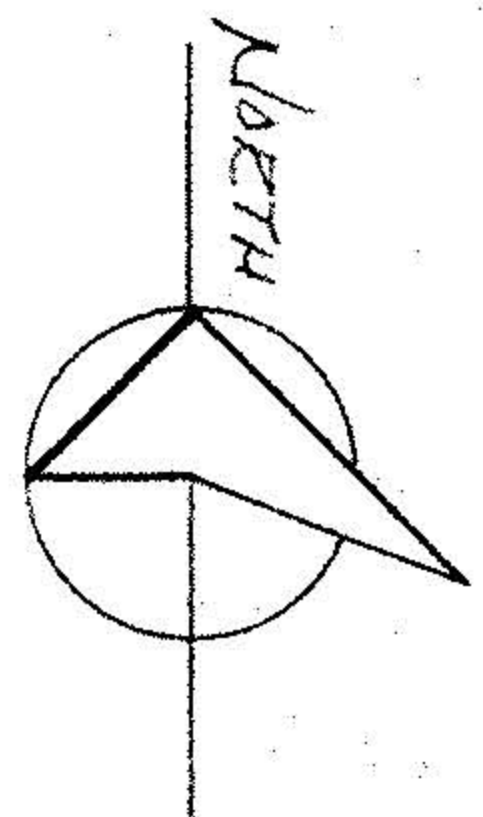

LEGEND  
 IRON PIN FOUND --- O  
 IRON PIN SET --- ●  
 RECORDED --- R  
 MEASURED --- M  
 OBSERVED --- DBS  
 CALCULATED --- CALC.

