WILLIAM B. BARTON
Reg. Land Surveyor No. 4438
188 PARKWOOD AVENUE
AVON LAKE, OHIO 44012
TELEPHONE (216) 933-6662

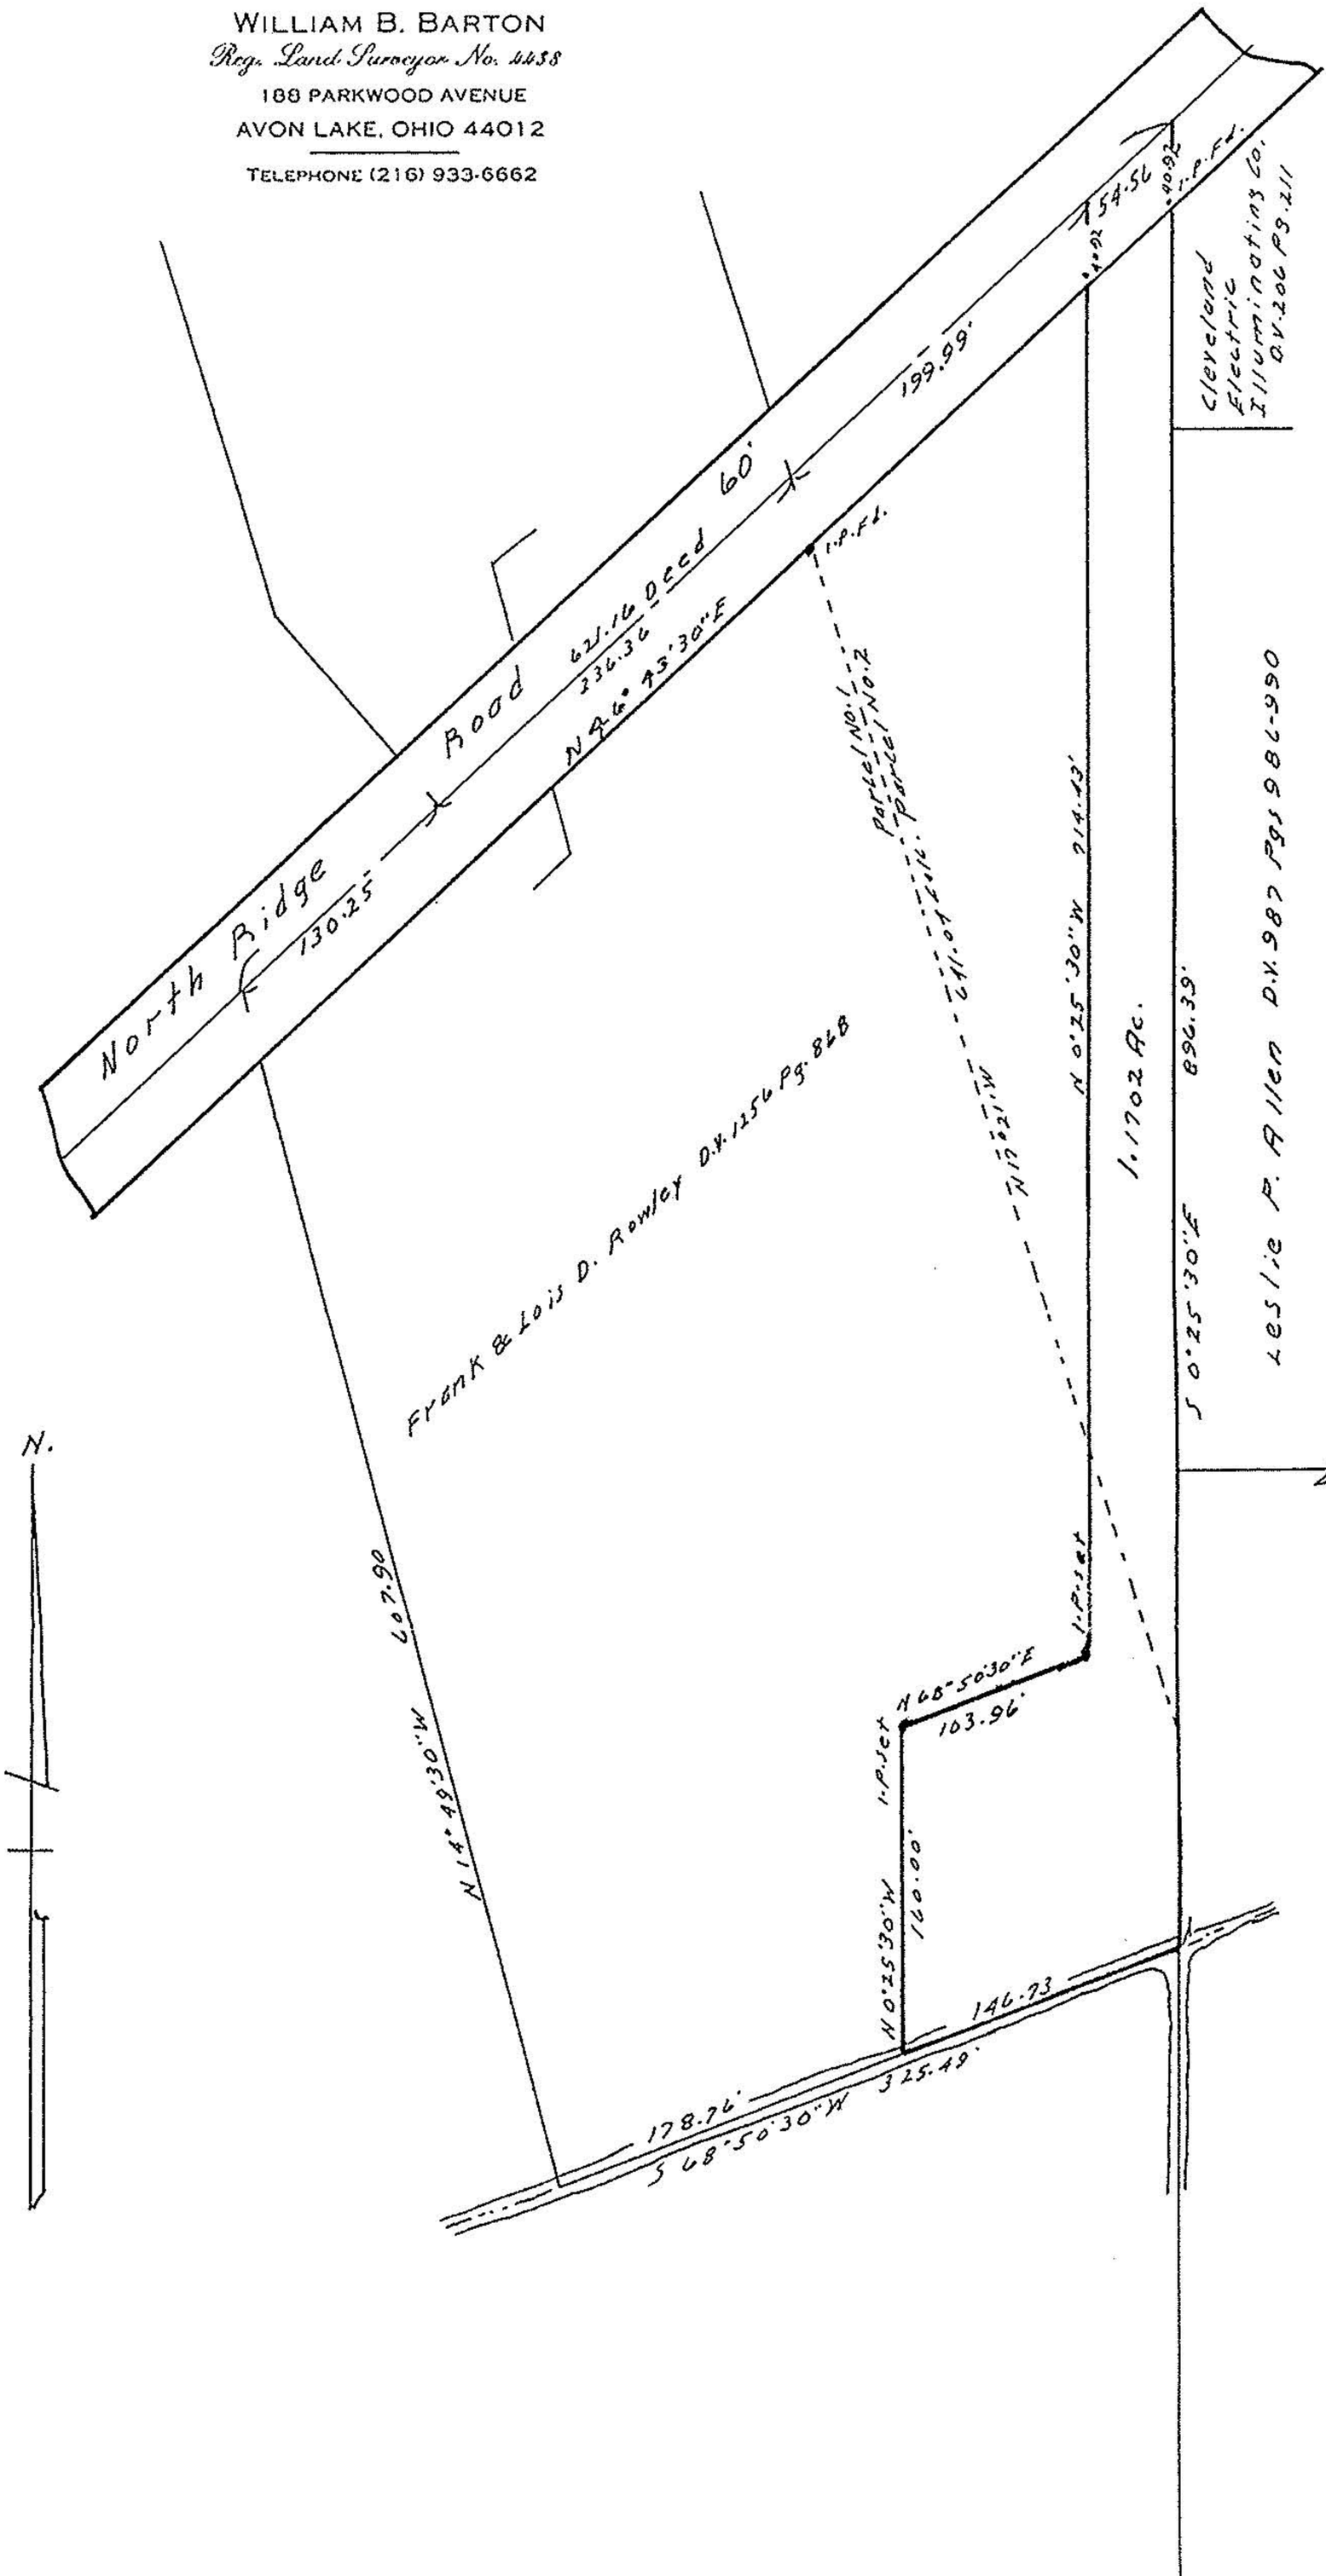

SURVEY
of
Part of Section No. 2, Avon Township, now the city of Avon, . Lorain County, Ohio. Scale 1"=100' May 8, 1987
Rev. 7-23, 1987

#17556

APPROVED
LORAIN CO.
MAP DEPT.
DATE 7-24-87
PAGE 4-00-002-H
BY C. FRANCIS
VOID AFTER 17556

STATE OF OHIO
WILLIAM B. BARTON
4438
REGISTERED SURVEYOR