SURVEY
OF
SUBLOT 24
ED SMITEK SUBDIVISION NO. 2
AND THE
RESUBDIVISION OF THE SAME

PREPARED FOR
JAKRON CONSTRUCTION
BUILDER DEVELOPER

PREPARED BY
FOOR & ASSOCIATES
REGISTERED SURVEYORS

STATE OF OHIO
JAMES R. FOOR
S-5875
REGISTERED
SURVEYOR

SCALE: 1" = 40'
DATE: OCT. 1988

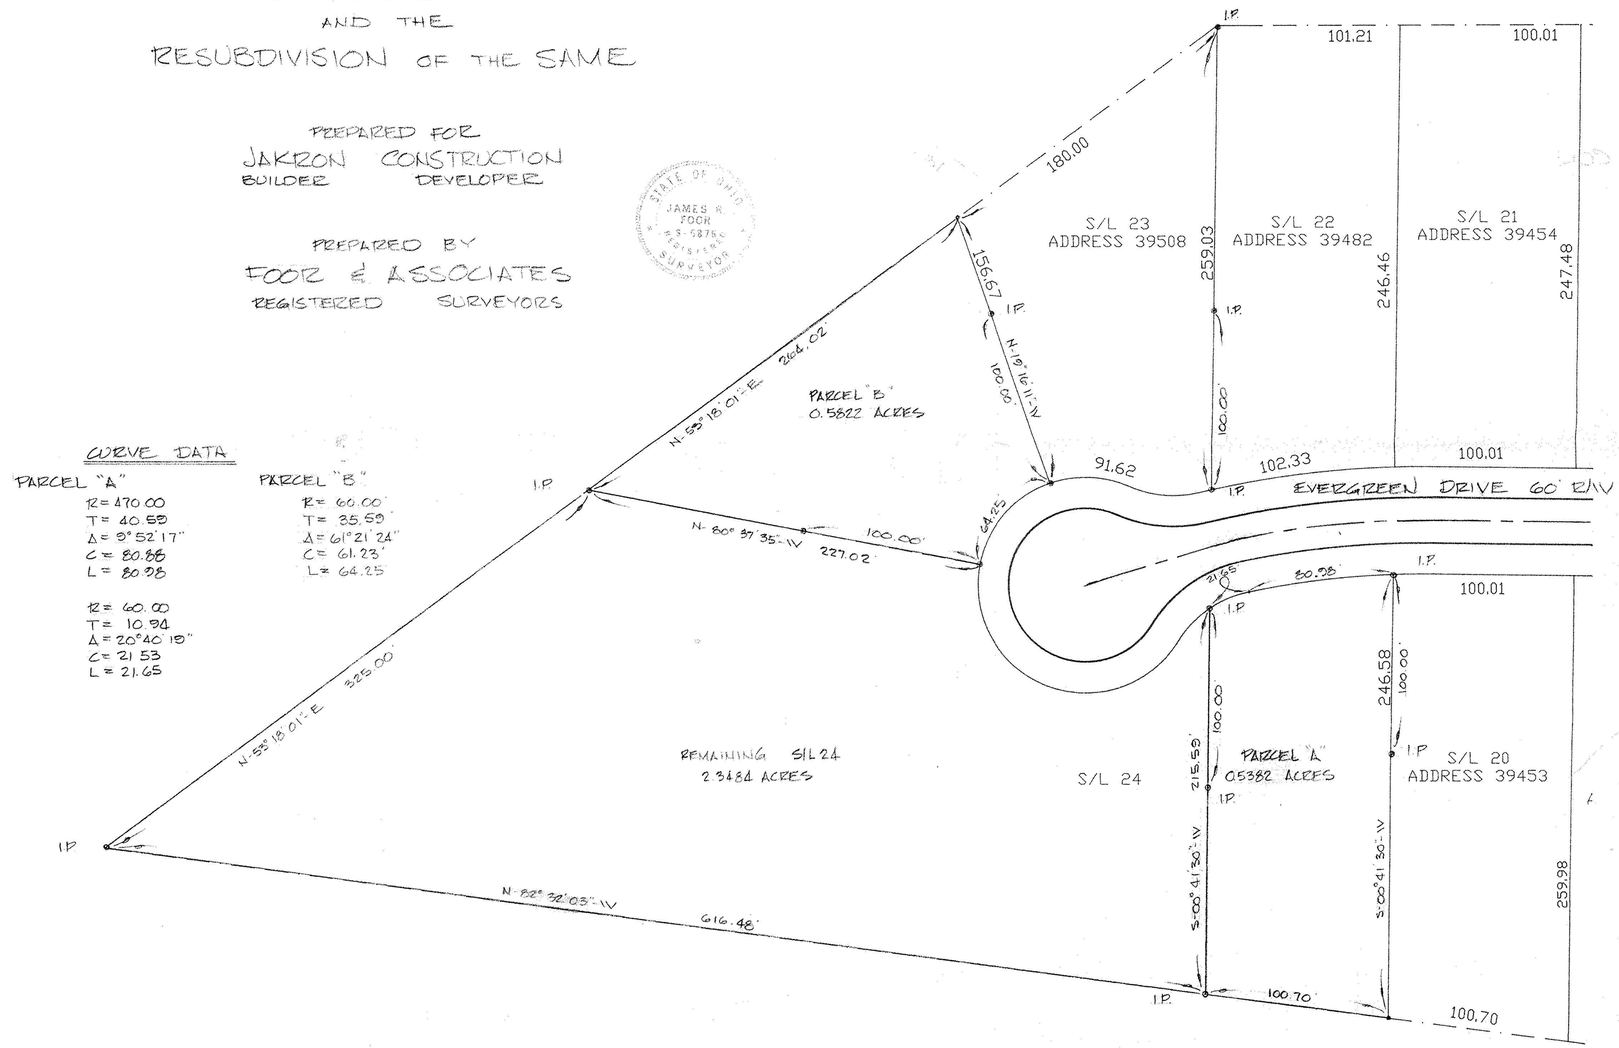

CURVE DATA

PARCEL "A"
R = 470.00
T = 40.59
Δ = 9°52'17"
C = 80.88
L = 80.98

R = 60.00
T = 10.94
Δ = 20°40'19"
C = 21.53
L = 21.65

PARCEL "B"
R = 60.00'
T = 35.59
Δ = 61°21'24"
C = 61.23'
L = 64.25