


Scale 1" = 200' Jan., 8, 1982  
By Arnold F. Koepp Reg. Surveyor

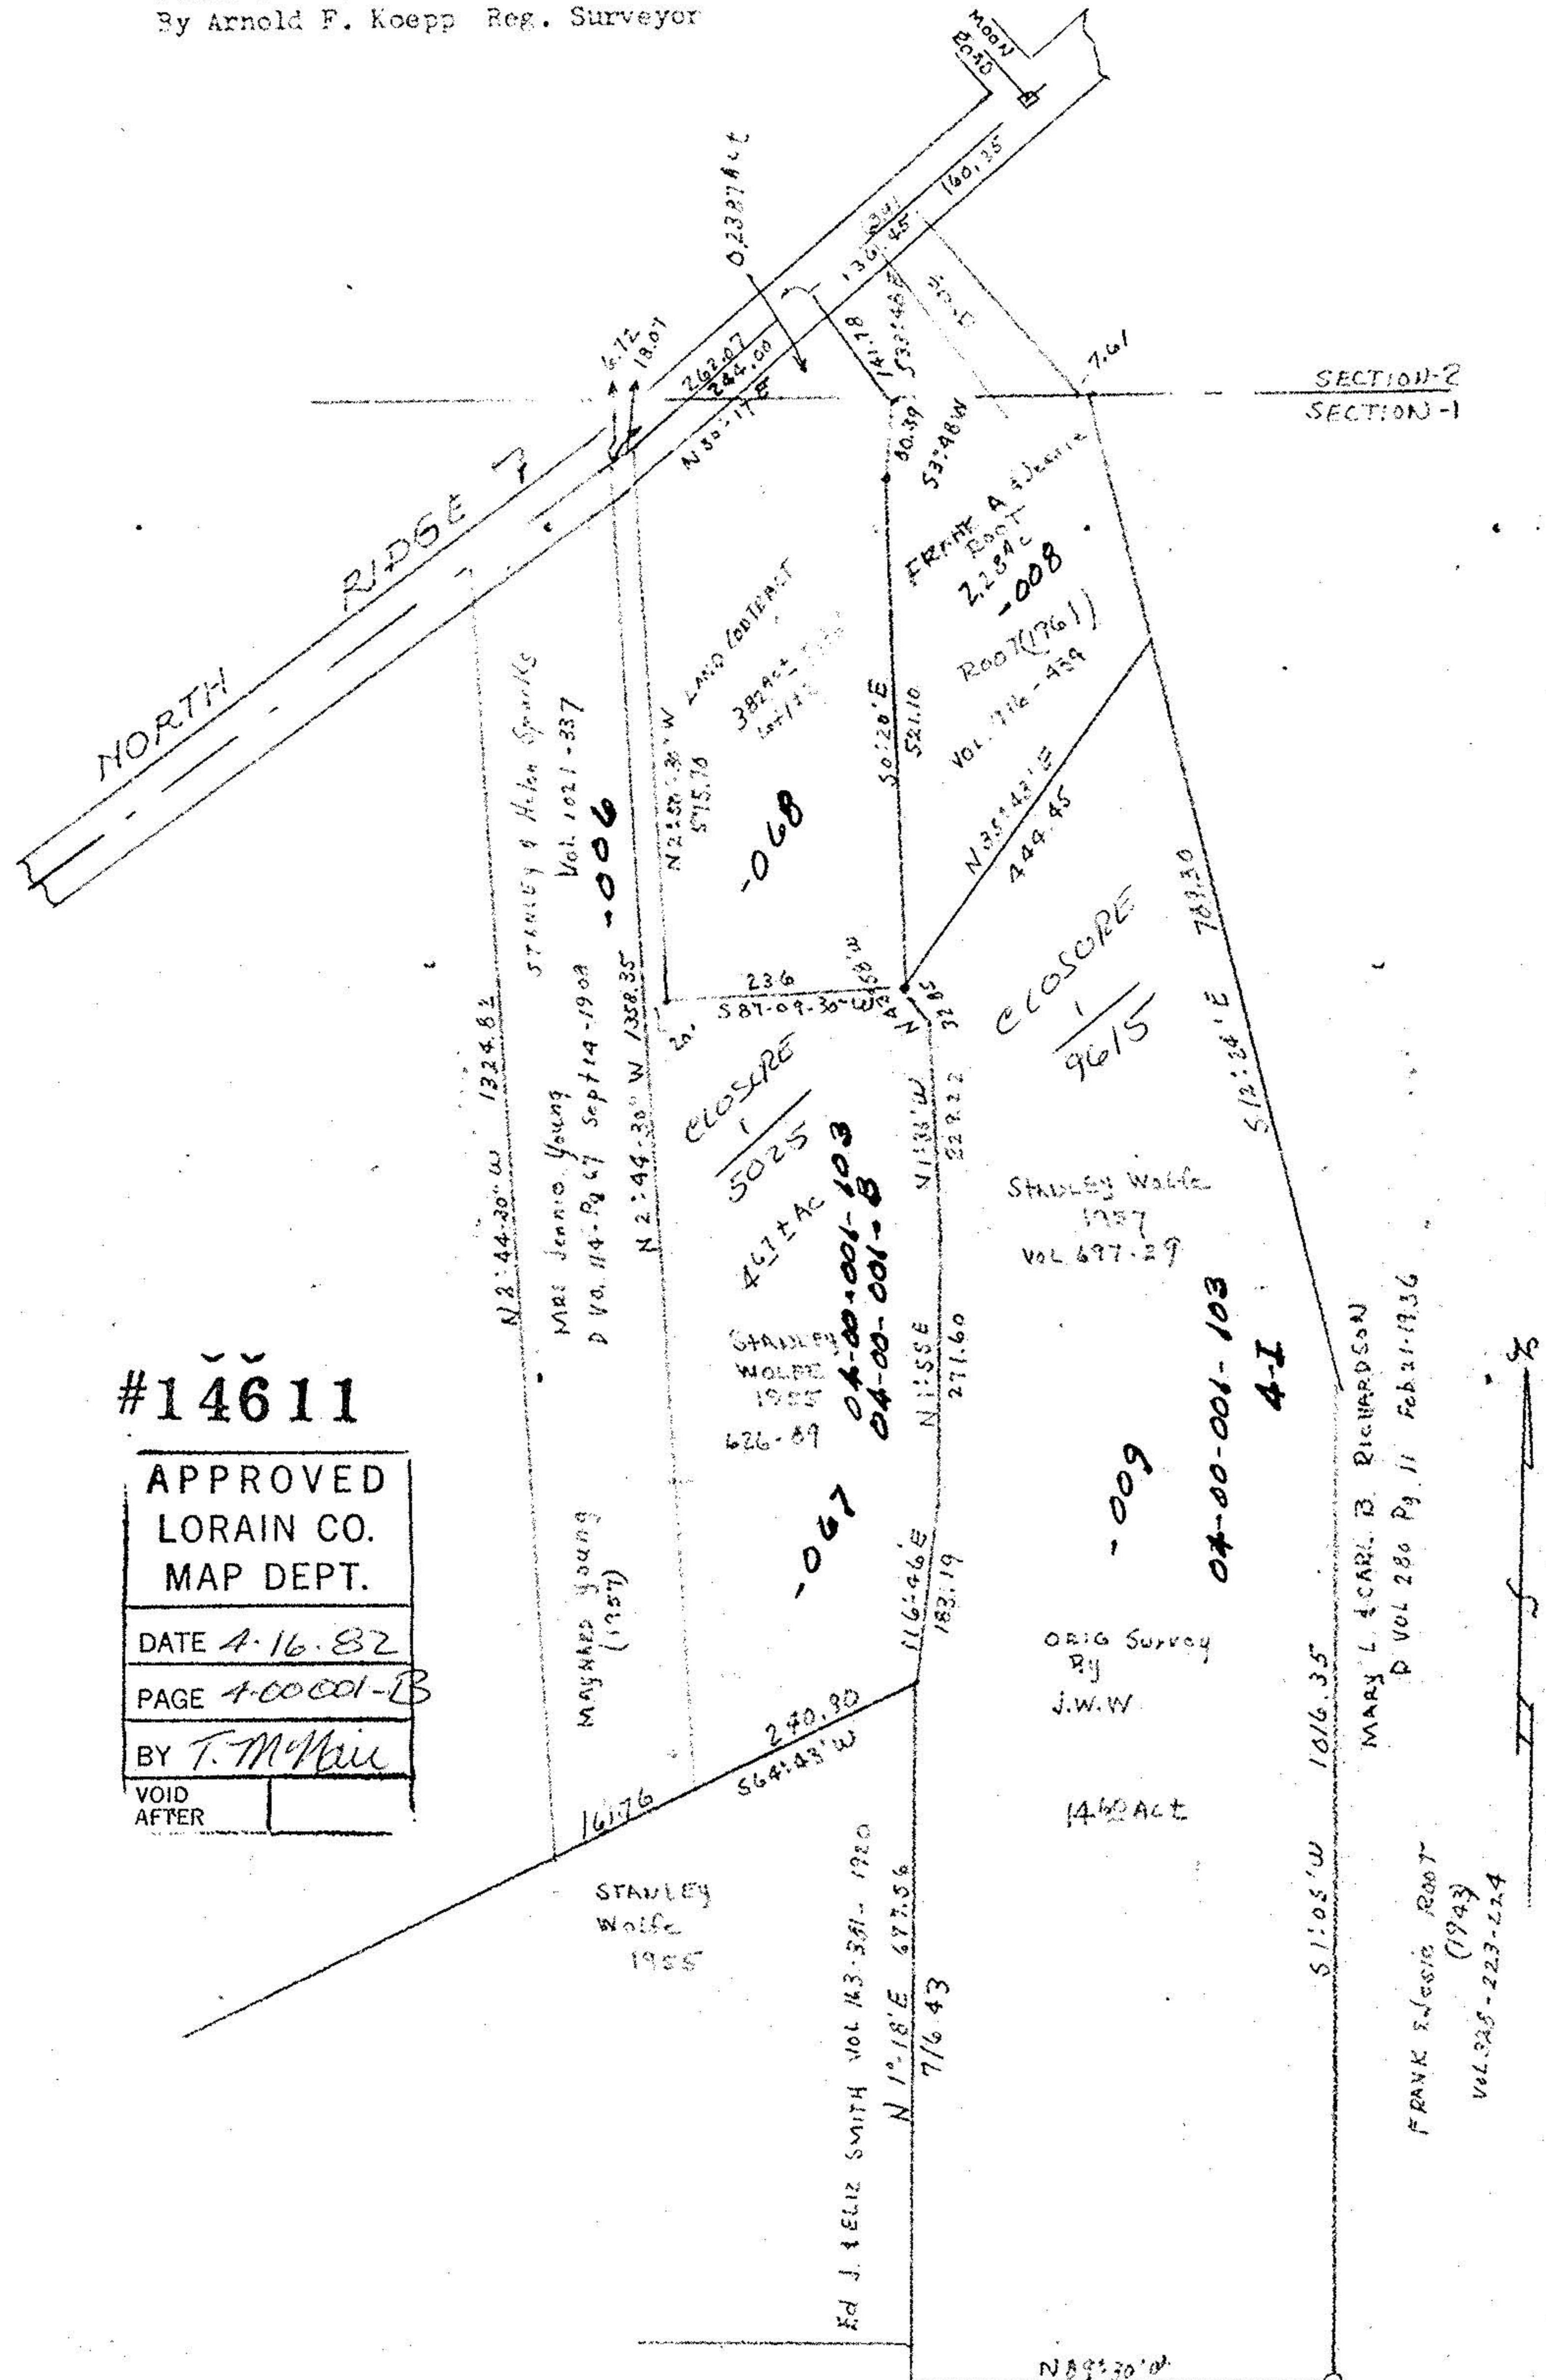

Formerly Peusken Deed, Vol. 279 - Pg. 557