


# SUBDIVISION OF LAND FOR BERNHARD SCHMETZER

CITY OF AVON - LORAIN COUNTY - OHIO

PART OF ORIGINAL AVON TOWNSHIP  
SECTION NO. 1

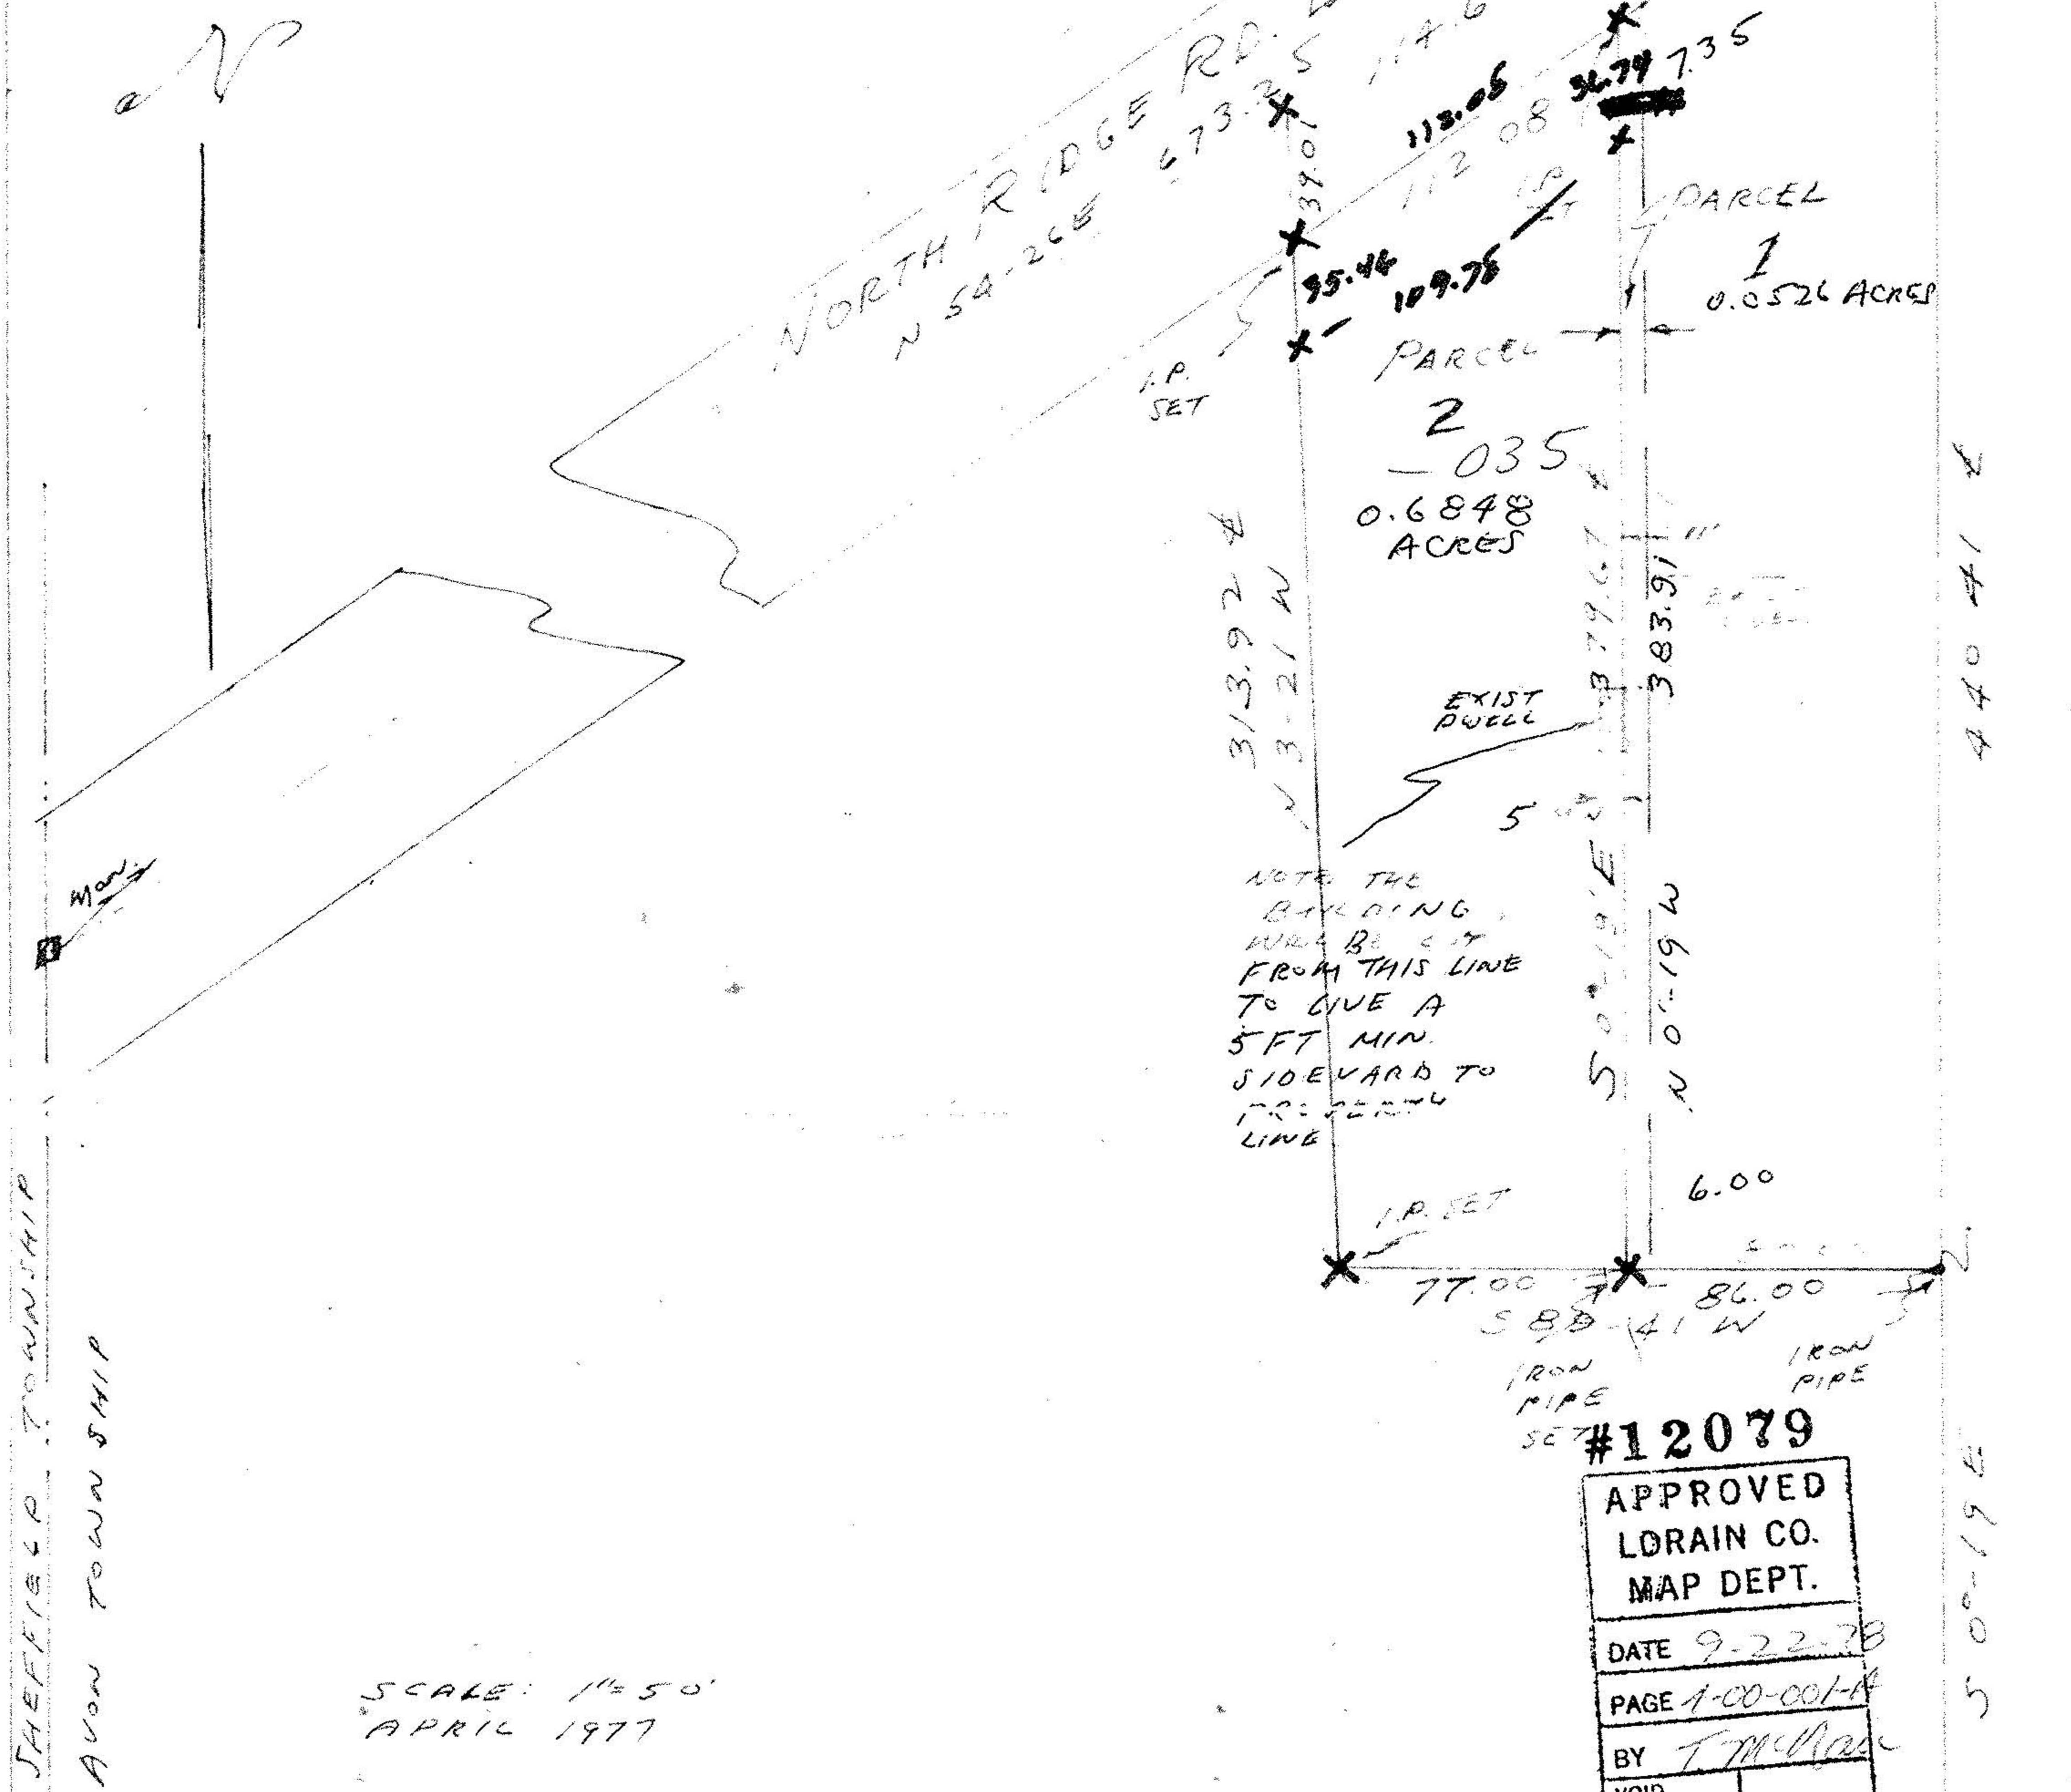


NOTE THE BUILDING  
WALL BE SET  
FROM THIS LINE  
TO GIVE A  
5 FT MIN.  
SIDEYARD TO  
PROPERTY  
LINE

#12079  
APPROVED  
LORAIN CO.  
MAP DEPT.  
DATE 9-22-78  
PAGE 1-00-001-A  
BY T. McMan  
VOID  
AFTER

SCALE: 1" = 50'  
APRIL 1977

*Vincent C. McMan*  
CIVIL ENGINEER

2043 JOSEPH ST.  
AVON, OHIO 44011  
937-5353

 

1.70  
4  
04-00-001-102

54985 REC

4-00-001-A