SURVEY & LAND PARTITION

OF PART OF ORIGINAL AVON TOWNSHIP SECTION Nº THREE
PERMANENT PARCEL Nº 4-00-003-101-084

CITY OF AVON - LORAIN COUNTY - OHIO

FOR:
RONALD KRYSTOWSKI
5060 MOON ROAD
AVON, OHIO 44011

BY:
MARTINI & ASSOCIATES
LAND SURVEYORS
AVON, OHIO

MARCH, 1991
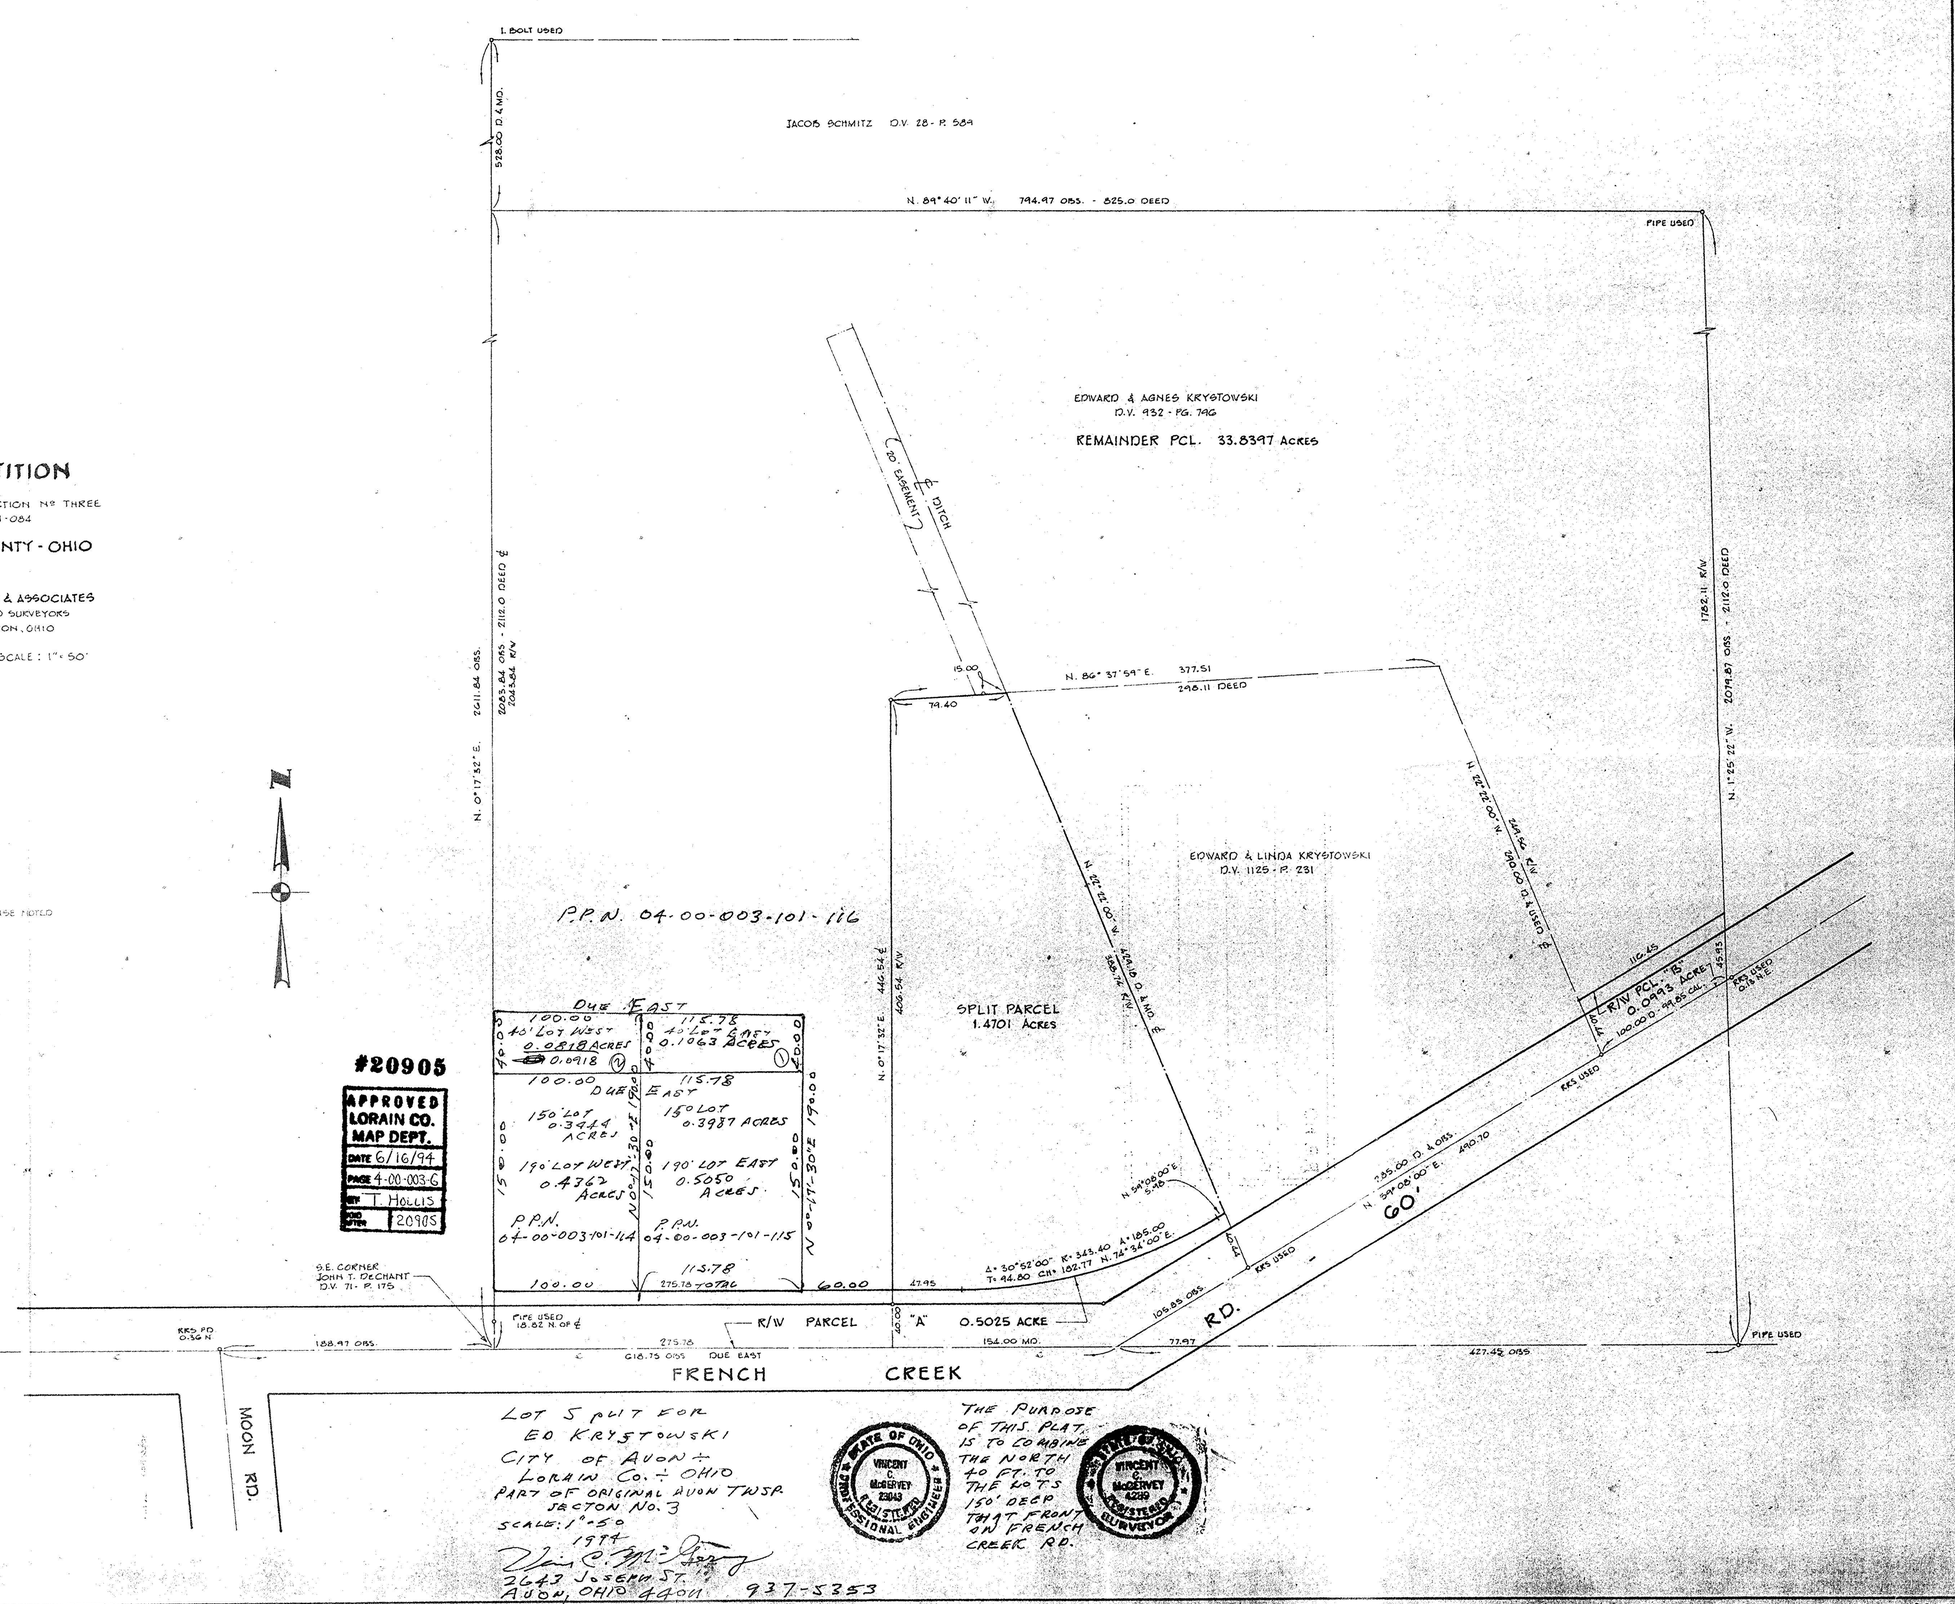
SCALE: 1" = 50'