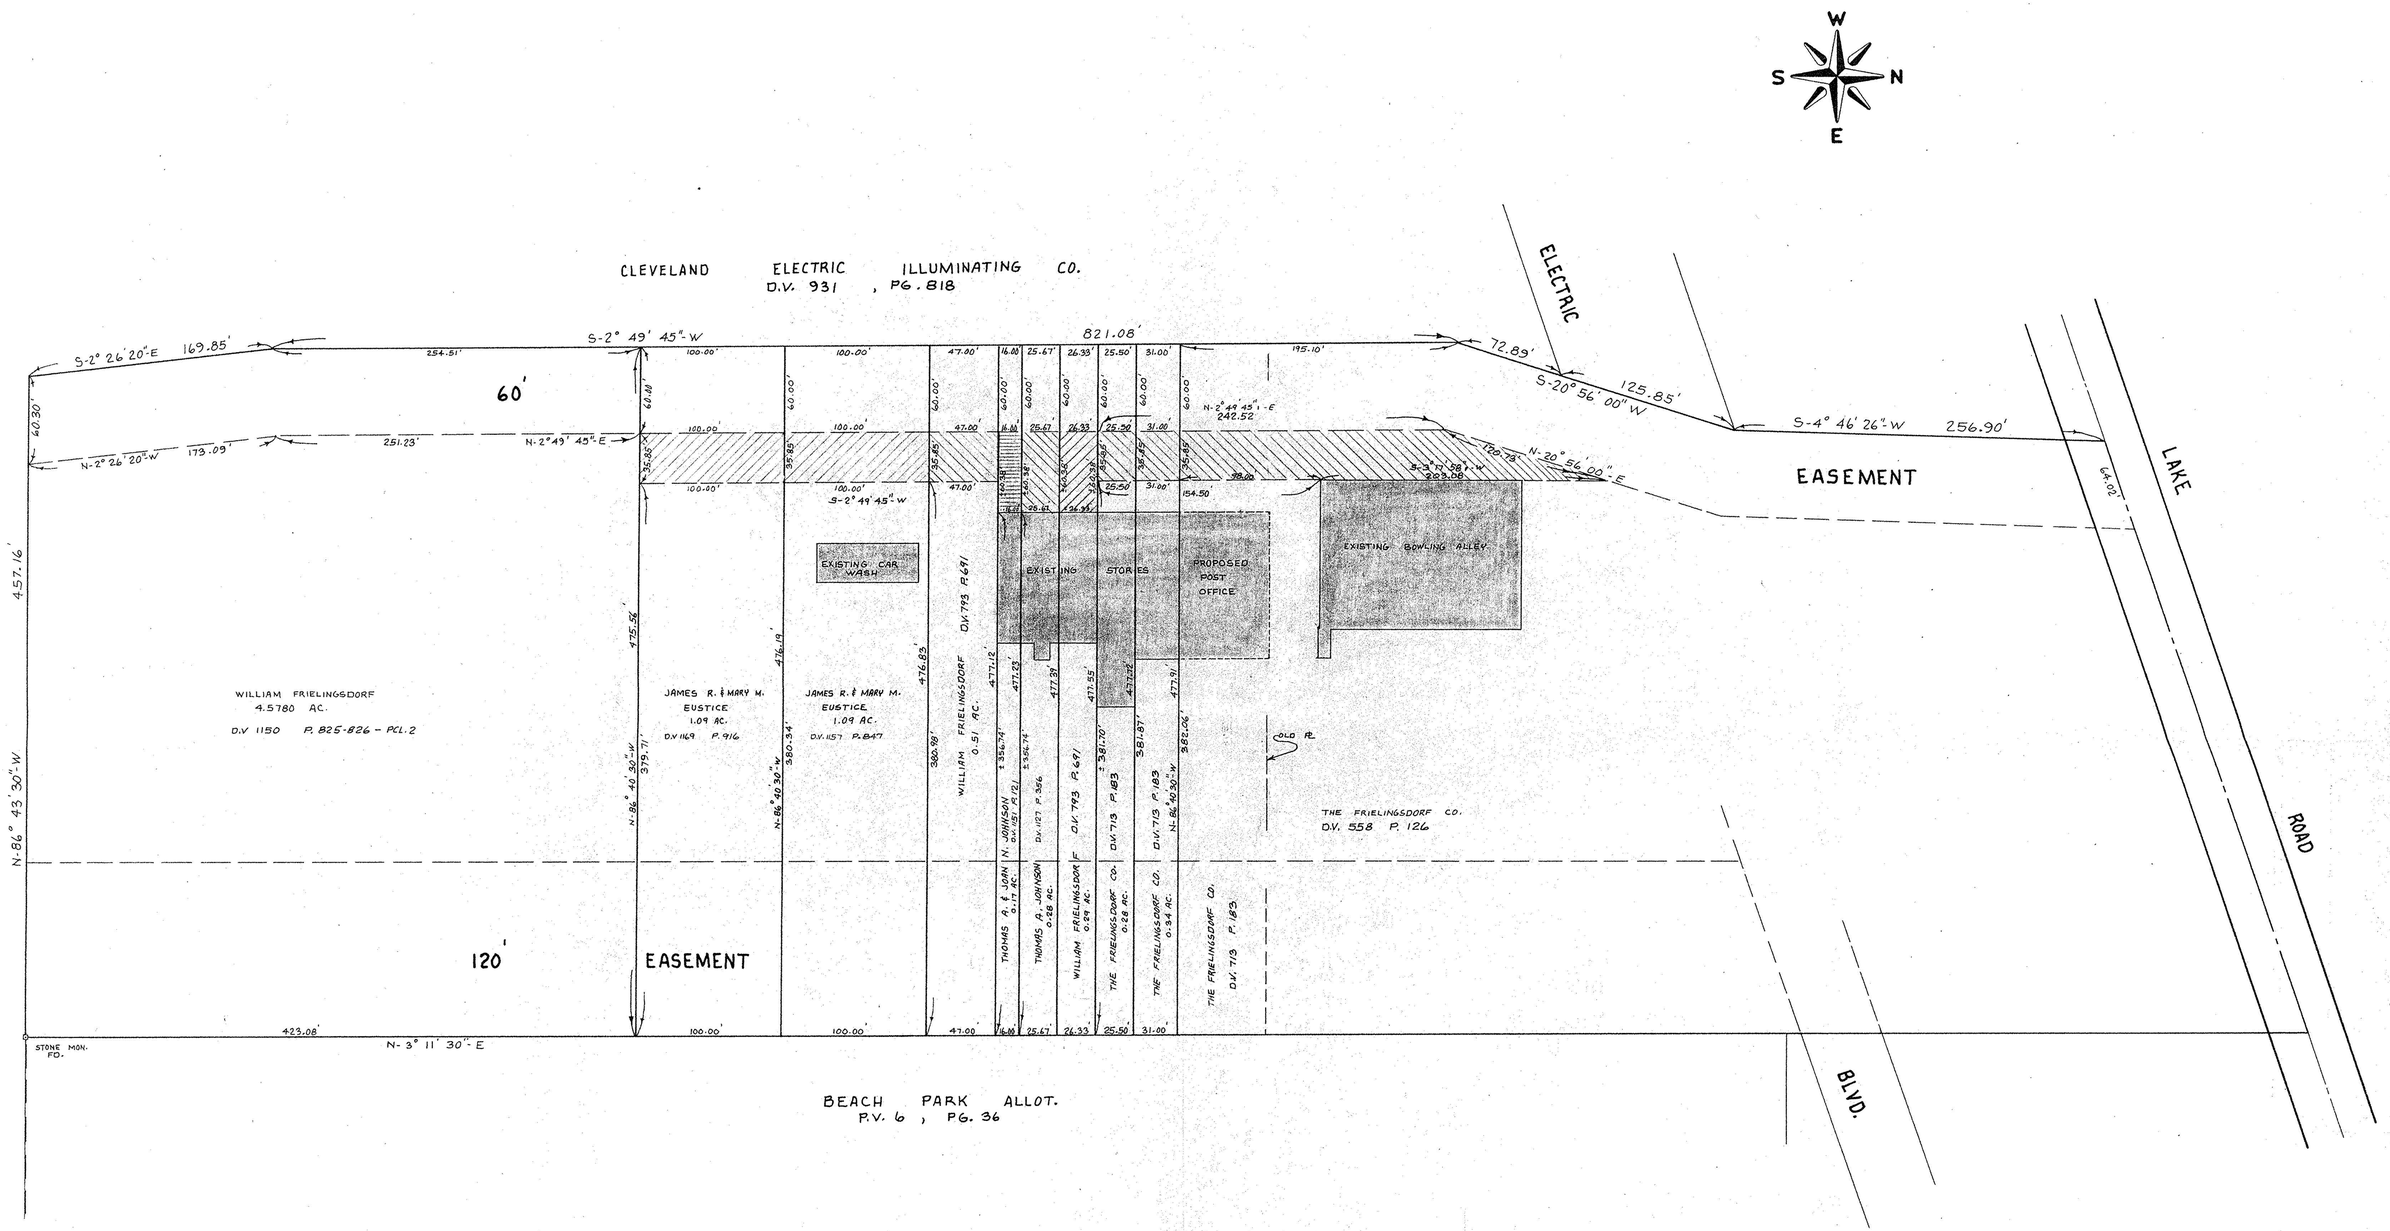

THIS MAP WAS 3RD ONE SUBMITTED FOR THIS SPLIT & WAS THE ONE USED TO DRAW SPLIT TAH
#15445

No.	Date	Description	By
2.	2-4-83	ADD DEED VOL. & PG. INFO. - "SPLIT" ESMT. ON JOHNSON PCLS.	K.V.S.
1.	11-9-82	INCREASE ESMT. COVERAGE ON JOHNSON PCLS. & FRIELINGSDORF 0.29 AC. PCL.	K.V.S.

REVISIONS

PROJECT

PARCEL & EASEMENT MAP
OF
PART OF AVON TOWNSHIP SECTION Nº 6
CITY OF AVON LAKE COUNTY OF LORAIN
STATE OF OHIO

PREPARED FOR:

WILLIAM FRIELINGSDORF

Drawn by: K.V.S.
Checked by:
App. by:
Scale: 1" = 50'
Date: 10-15-82

KLEINOEDER · SCHMIDT and ASSOCIATES
ENGINEERS — SURVEYORS — CONSULTANTS in LAND PLANNING
ELYRIA - NORWALK - MEDINA OHIO

REFERENCES
WAR. F.B. 76 P. 59
4-00-006-D
D.D.A. 2-785

SHEET NO. 1 of 1

APPROVED LORAIN CO. MAP DEPT.
DATE 3-8-84
PAGE 4-00-006-D
BY T. McKay
PROJ. MGR.
JOB NO. 74-188