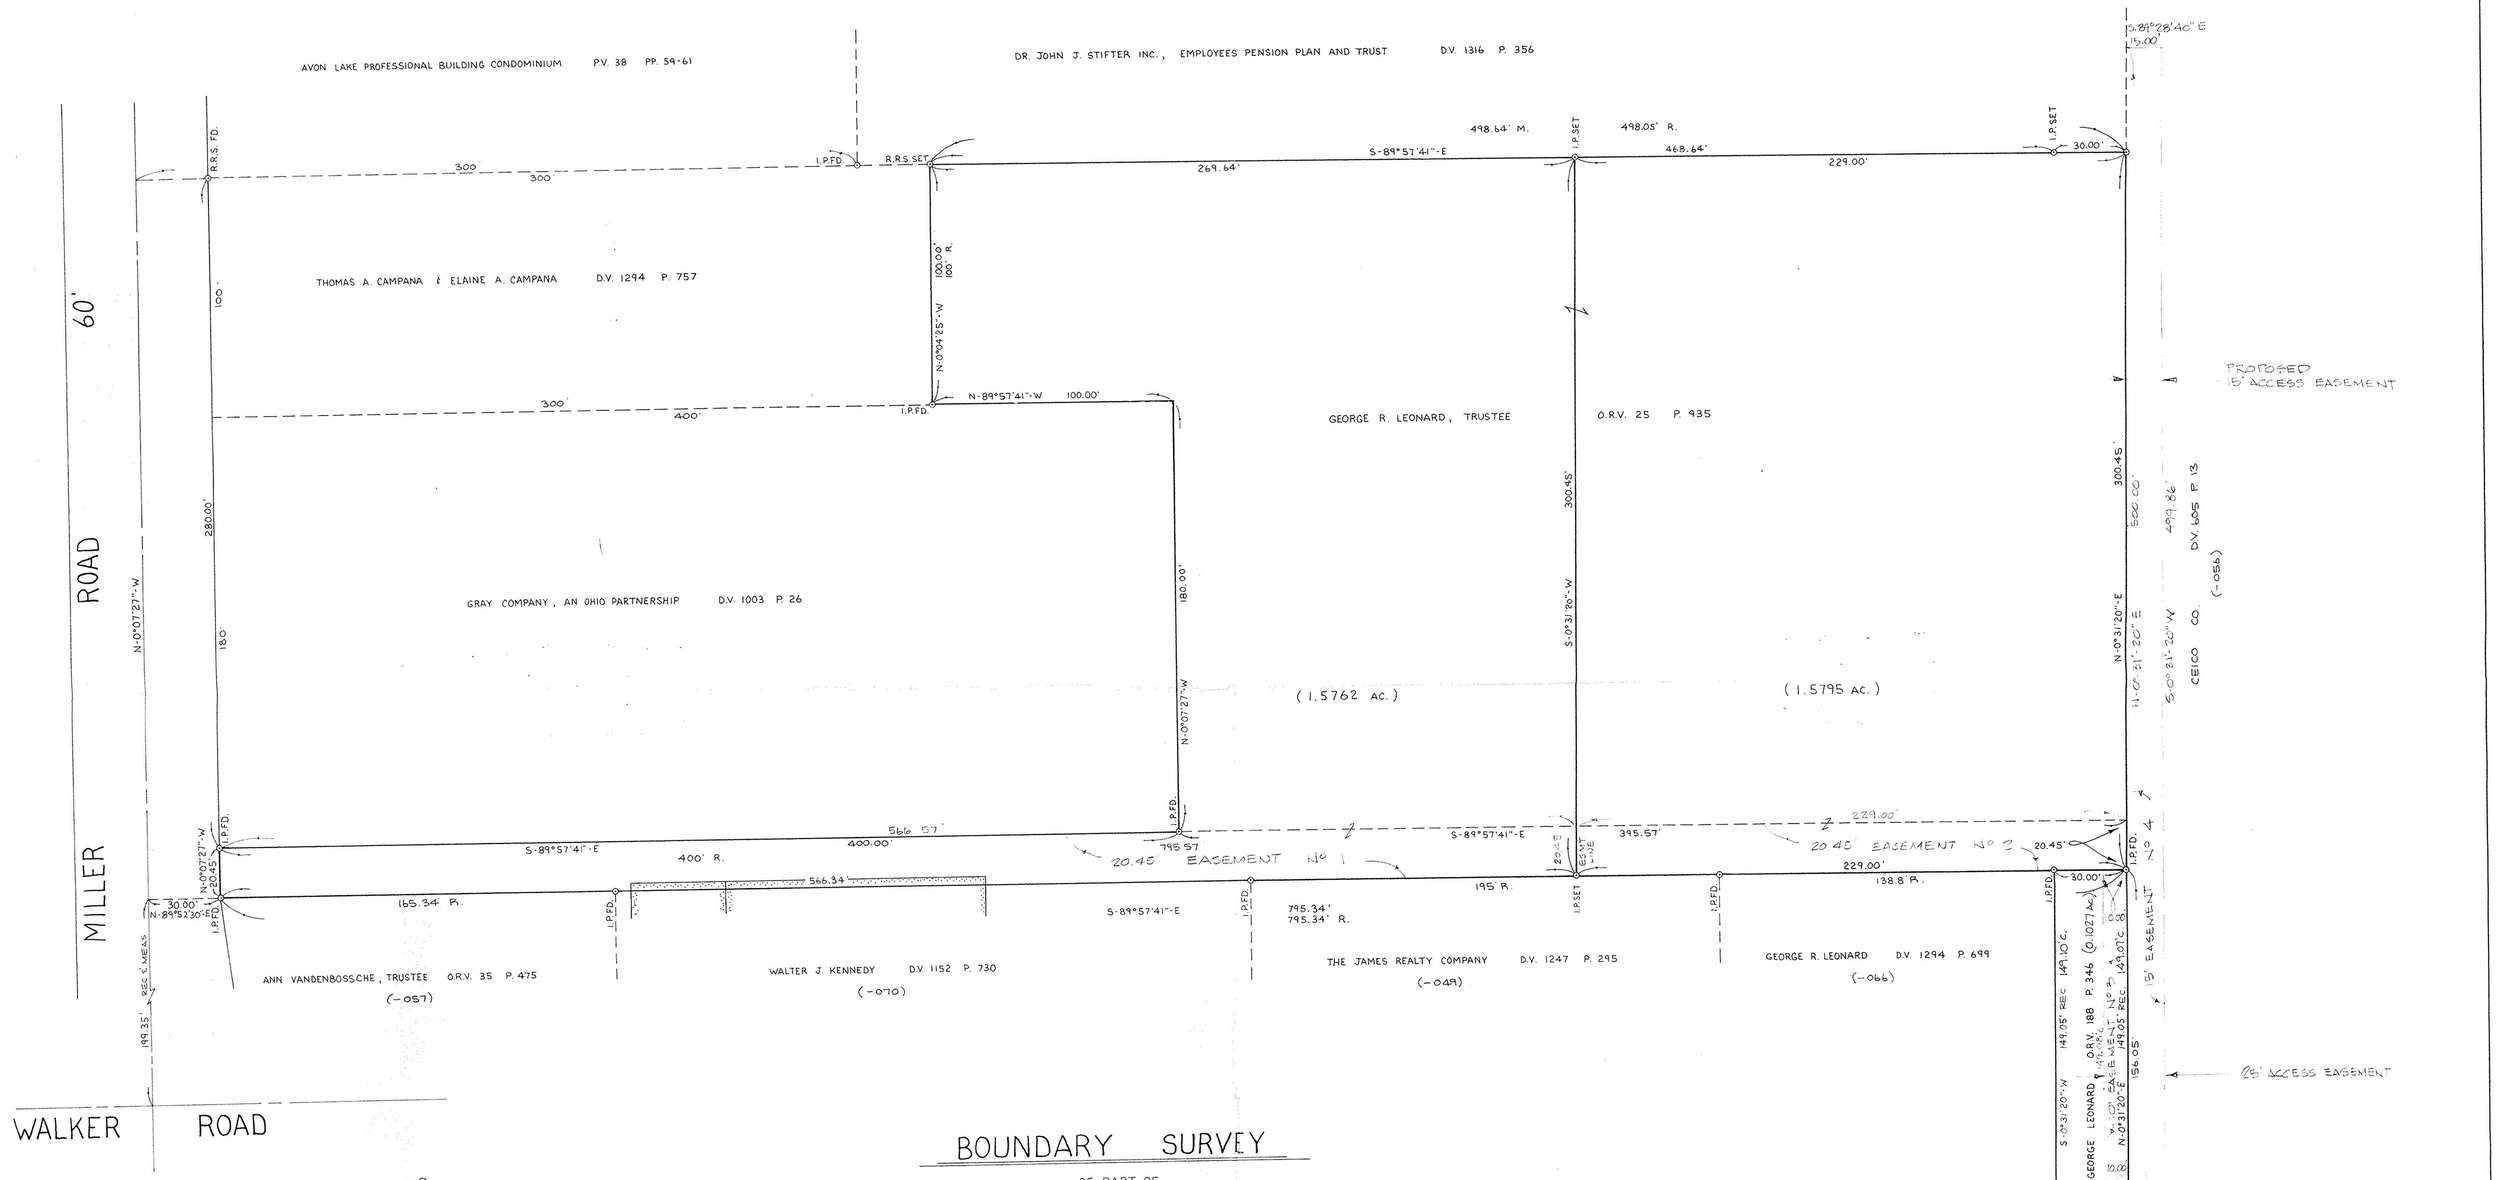

BOUNDARY SURVEY

OF PART OF

ORIGINAL AVON TOWNSHIP SECTION NO. 6

CITY OF AVON LAKE · COUNTY OF LORAIN

STATE OF OHIO

PREPARED BY:
KS ASSOCIATES INC.
ENGINEERS & SURVEYORS

David I. Elwell
DAVID I. ELWELL REG. SURV. NO. 6333
DEC. 12, 1990
REV. 3-15-91 EASEMENT
REV. 6-28-91 EASEMENT (ACCESS)

20047

APPROVED
LORAIN CO.
MAP DEPT.
DATE 8-20-92
PAGE 4-00-006-F
BY CAROLYN FRANCIS
VOID AFTER # 20047

04-00-006-114

PRINTED
JUN 28 1991
KS ASSOCIATES INC.

REF. 91-043

90-527