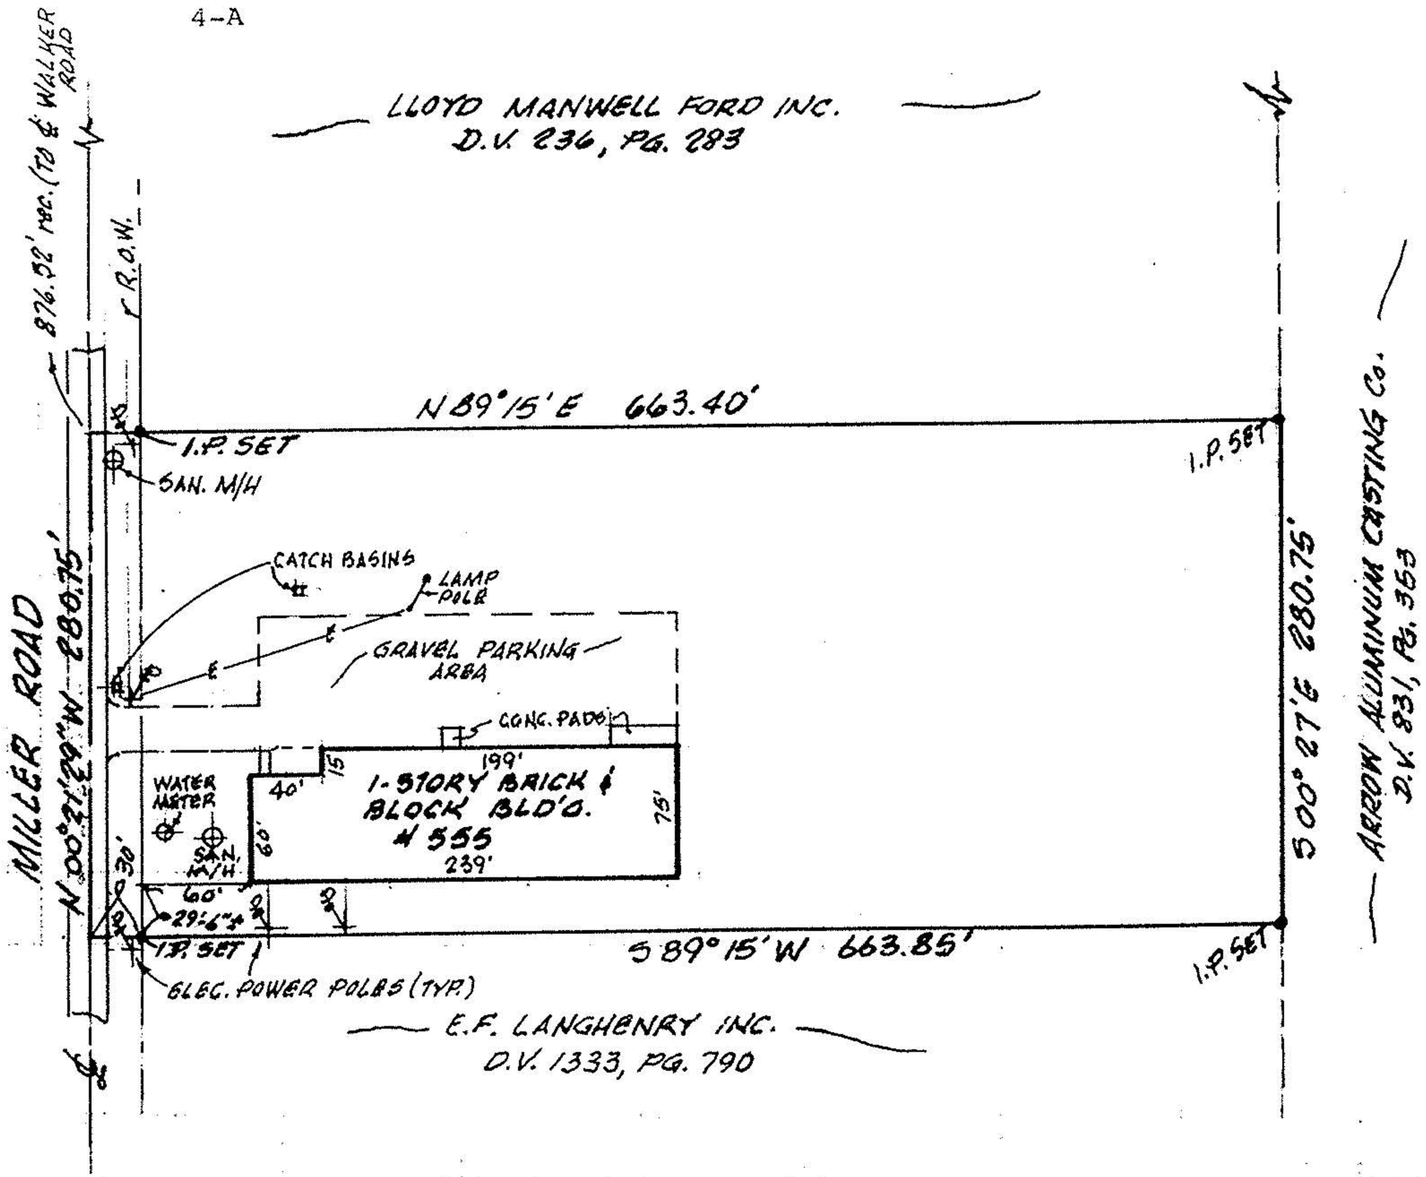

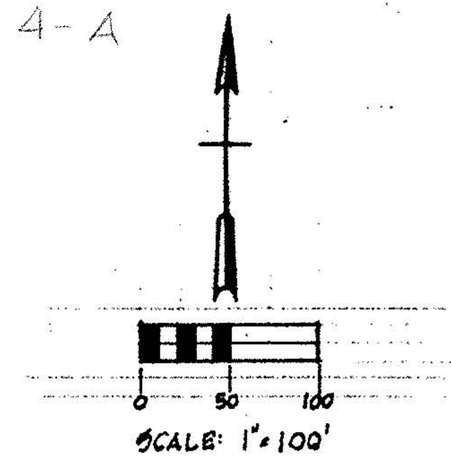

TO: SOCIETY NATIONAL BANK: CONTINENTAL TITLE AGENCY CORP. AND TRANSAMERICA TITLE INSURANCE COMPANY

THIS IS TO CERTIFY THAT THIS MAP OR PLAT AND THE SURVEY ON WHICH IT IS BASED, WERE MADE IN ACCORDANCE WITH "MINIMUM STANDARD DETAIL REQUIREMENTS FOR ALTA/ACSM LAND TITLE SURVEYS" JOINTLY ESTABLISHED AND ADOPTED BY ALTA AND ACSM IN 1986, AND MEETS THE ACCURACY REQUIREMENTS OF A CLASS "A" SURVEY, AS DEFINED THEREIN.

JAMES B. ROBERTS
#4279

MAP of "ALTA/ACSM" LAND TITLE SURVEY

PART of ORIGINAL AVON TOWNSHIP SECTION No. 5
NOW IN CITY of AVON LAKE, OHIO
P.P. No. 04-00-005-000-047 (4.2771 Ac.)

K.E. McCARTNEY & ASSOCIATES
ENGINEERS & SURVEYORS
ELYRIA OHIO
JULY 9, 1990 #903186