
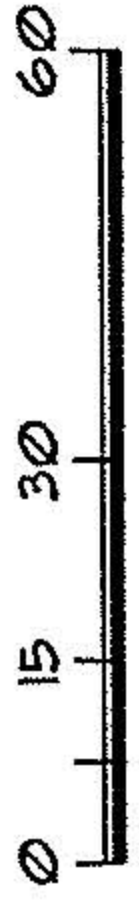


VINEWOOD DRIVE 60'

R=1535.93'  

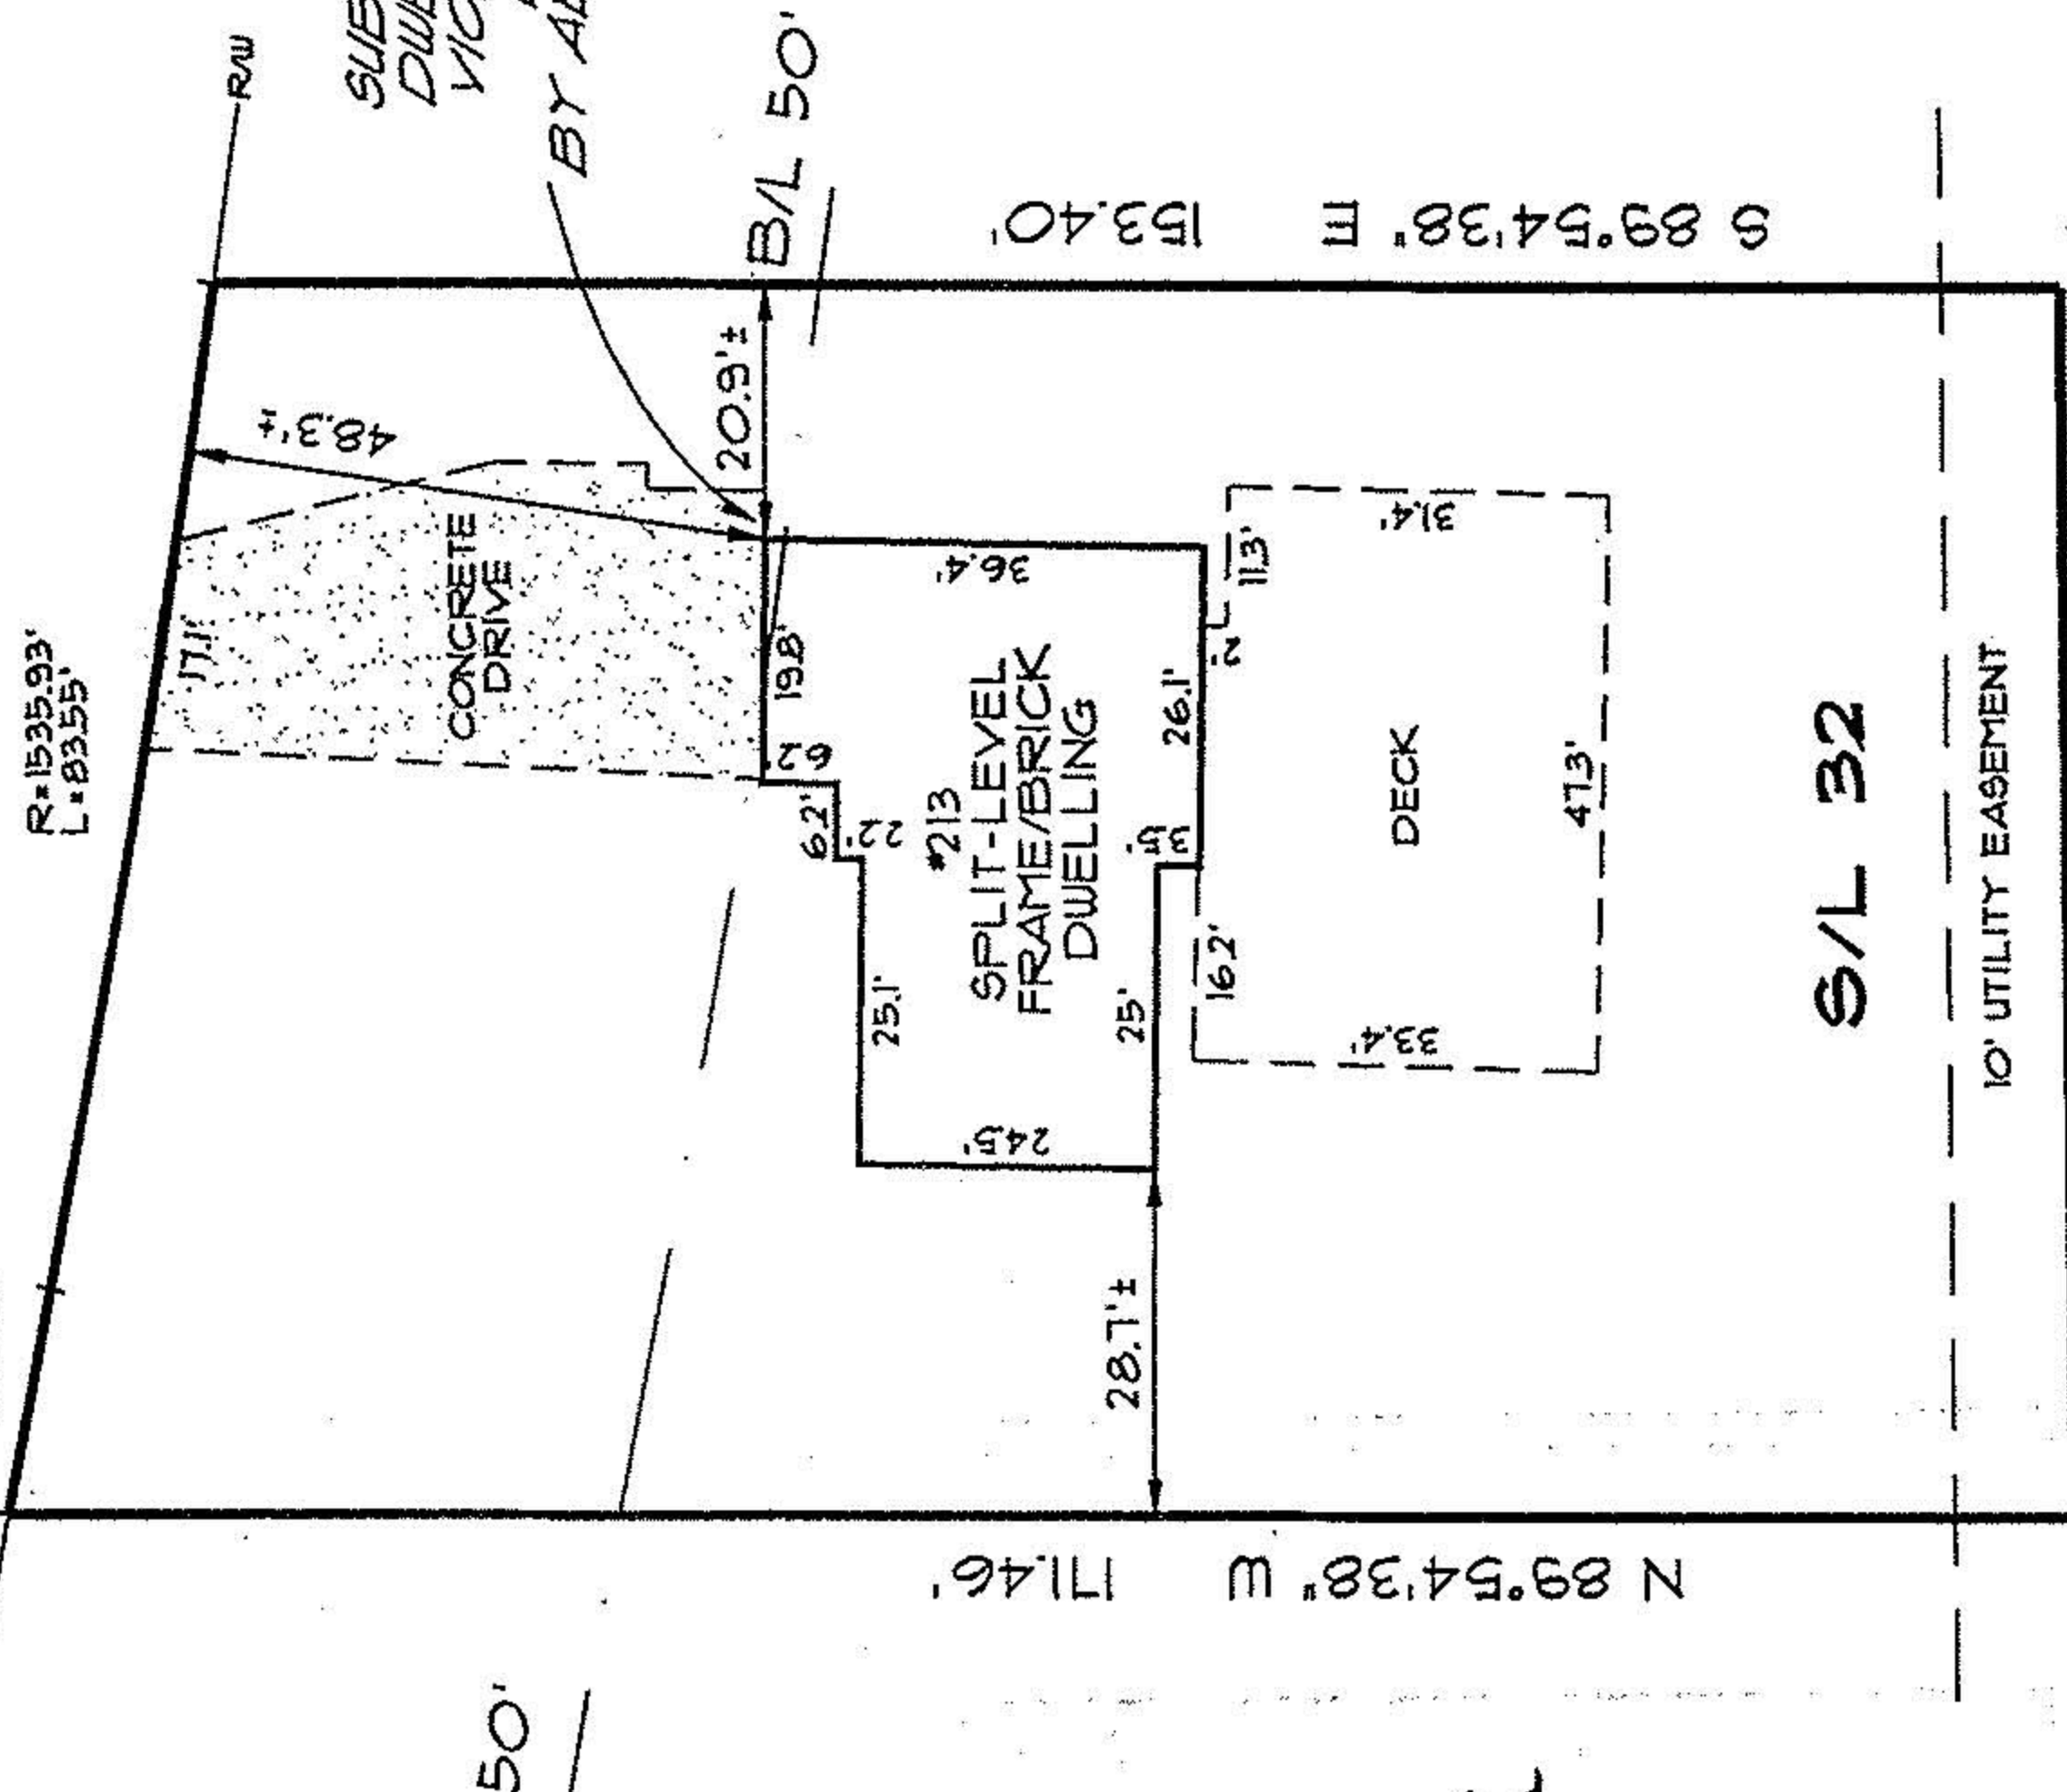

Scale 1"=30'  
MAS/5  
228573  
03/23/1997

#22149-X

APPROVED
LORAIN CO. MAP DEPT.
DATE 4-23-97
PAGE 4-00-007D
BY R. BELL
VOID AFTER # 22149-X

