#19411
REF.

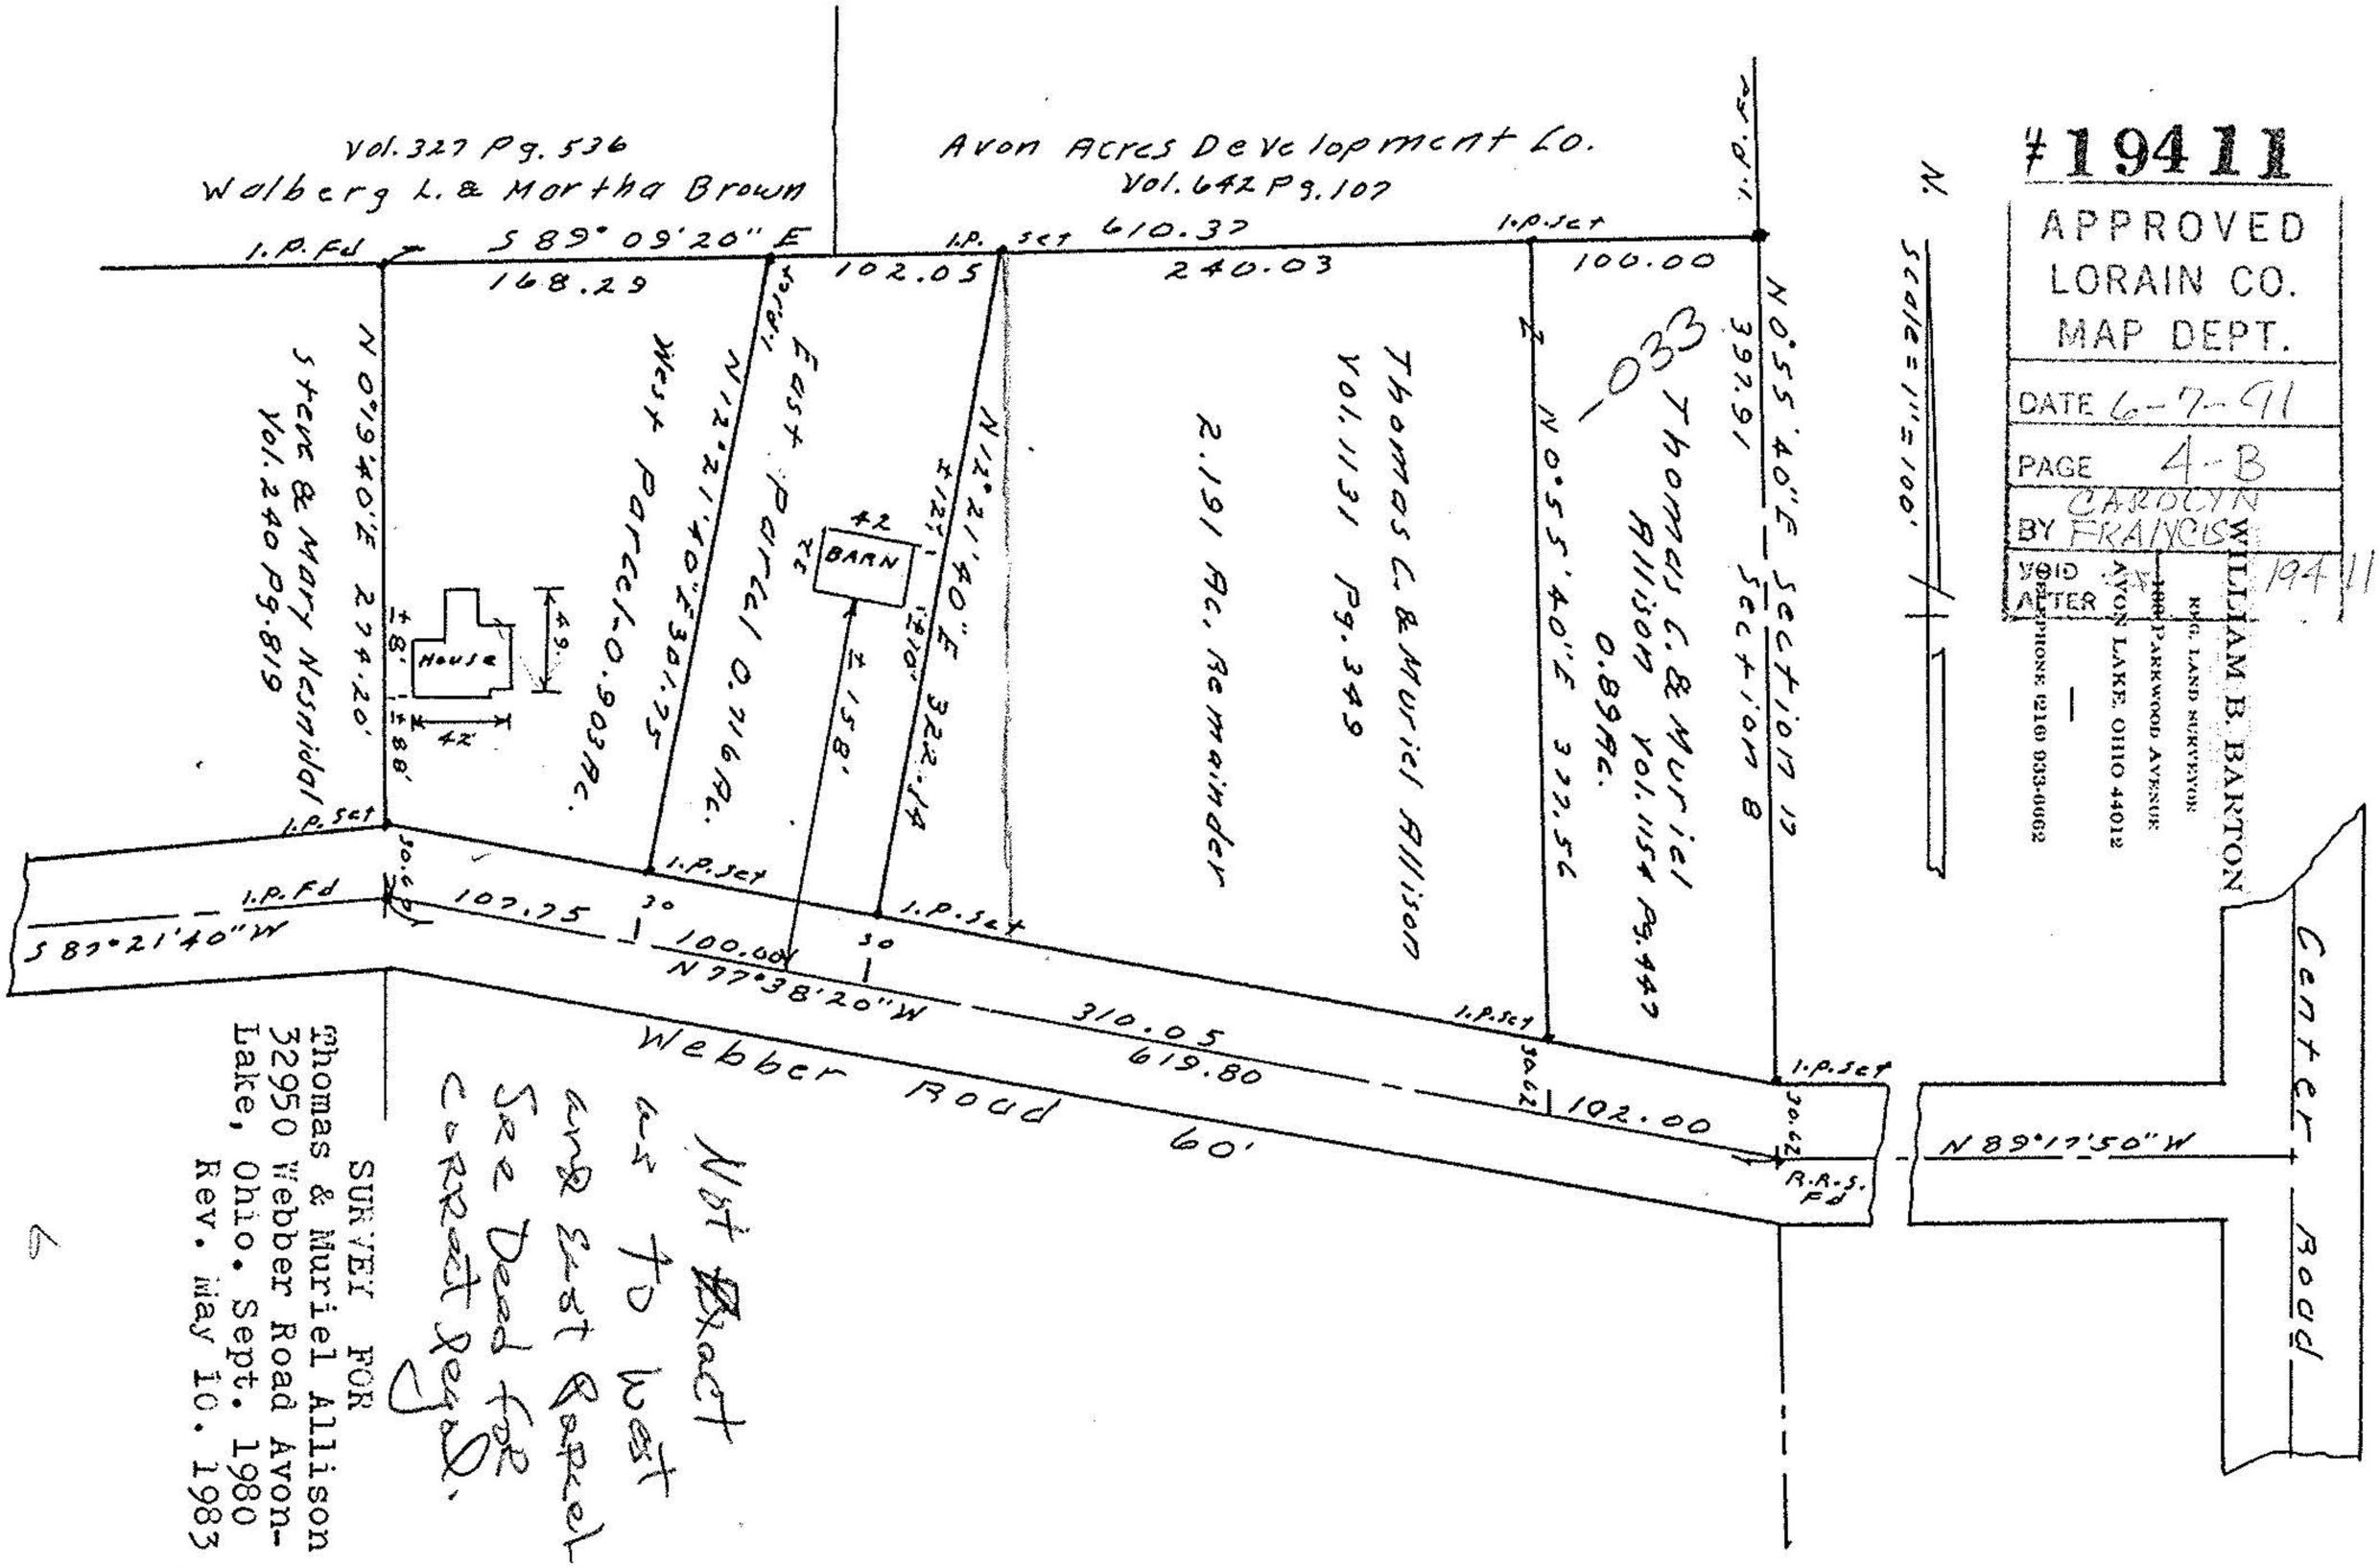

#19411

APPROVED
LORAIN CO.
MAP DEPT.

DATE 6-7-91
PAGE 4-B
BY CAROLYN FRANCIS
VOID AFTER 19411

WILLIAM B. BARTON
REG. LAND SURVEYOR
100 PARKWOOD AVENUE
AVON LAKE, OHIO 44012
TELEPHONE (216) 933-6662

Not Exact as to West and East Parcel. See Deed for correct legal.

SURVEY FOR
Thomas & Muriel Allison
32950 Webber Road Avon-
Lake, Ohio. Sept. 1980
Rev. May 10. 1983

6