

4-00-023 G


4 sec, 23

KLEINOEDER · SCHMIDT
and ASSOCIATES
ENGINEERS — SURVEYORS — CONSULTANTS IN LAND PLANNING
ELYRIA · NORWALK · MEDINA OHIO

SURVEY

Sublot(s) 9816
Subd'n 400-0236

Township AVON Tract _____
Orig. Lot(s) _____ Sec. 23
County of LORAIN State of Ohio
Corporation CITY OF AVON

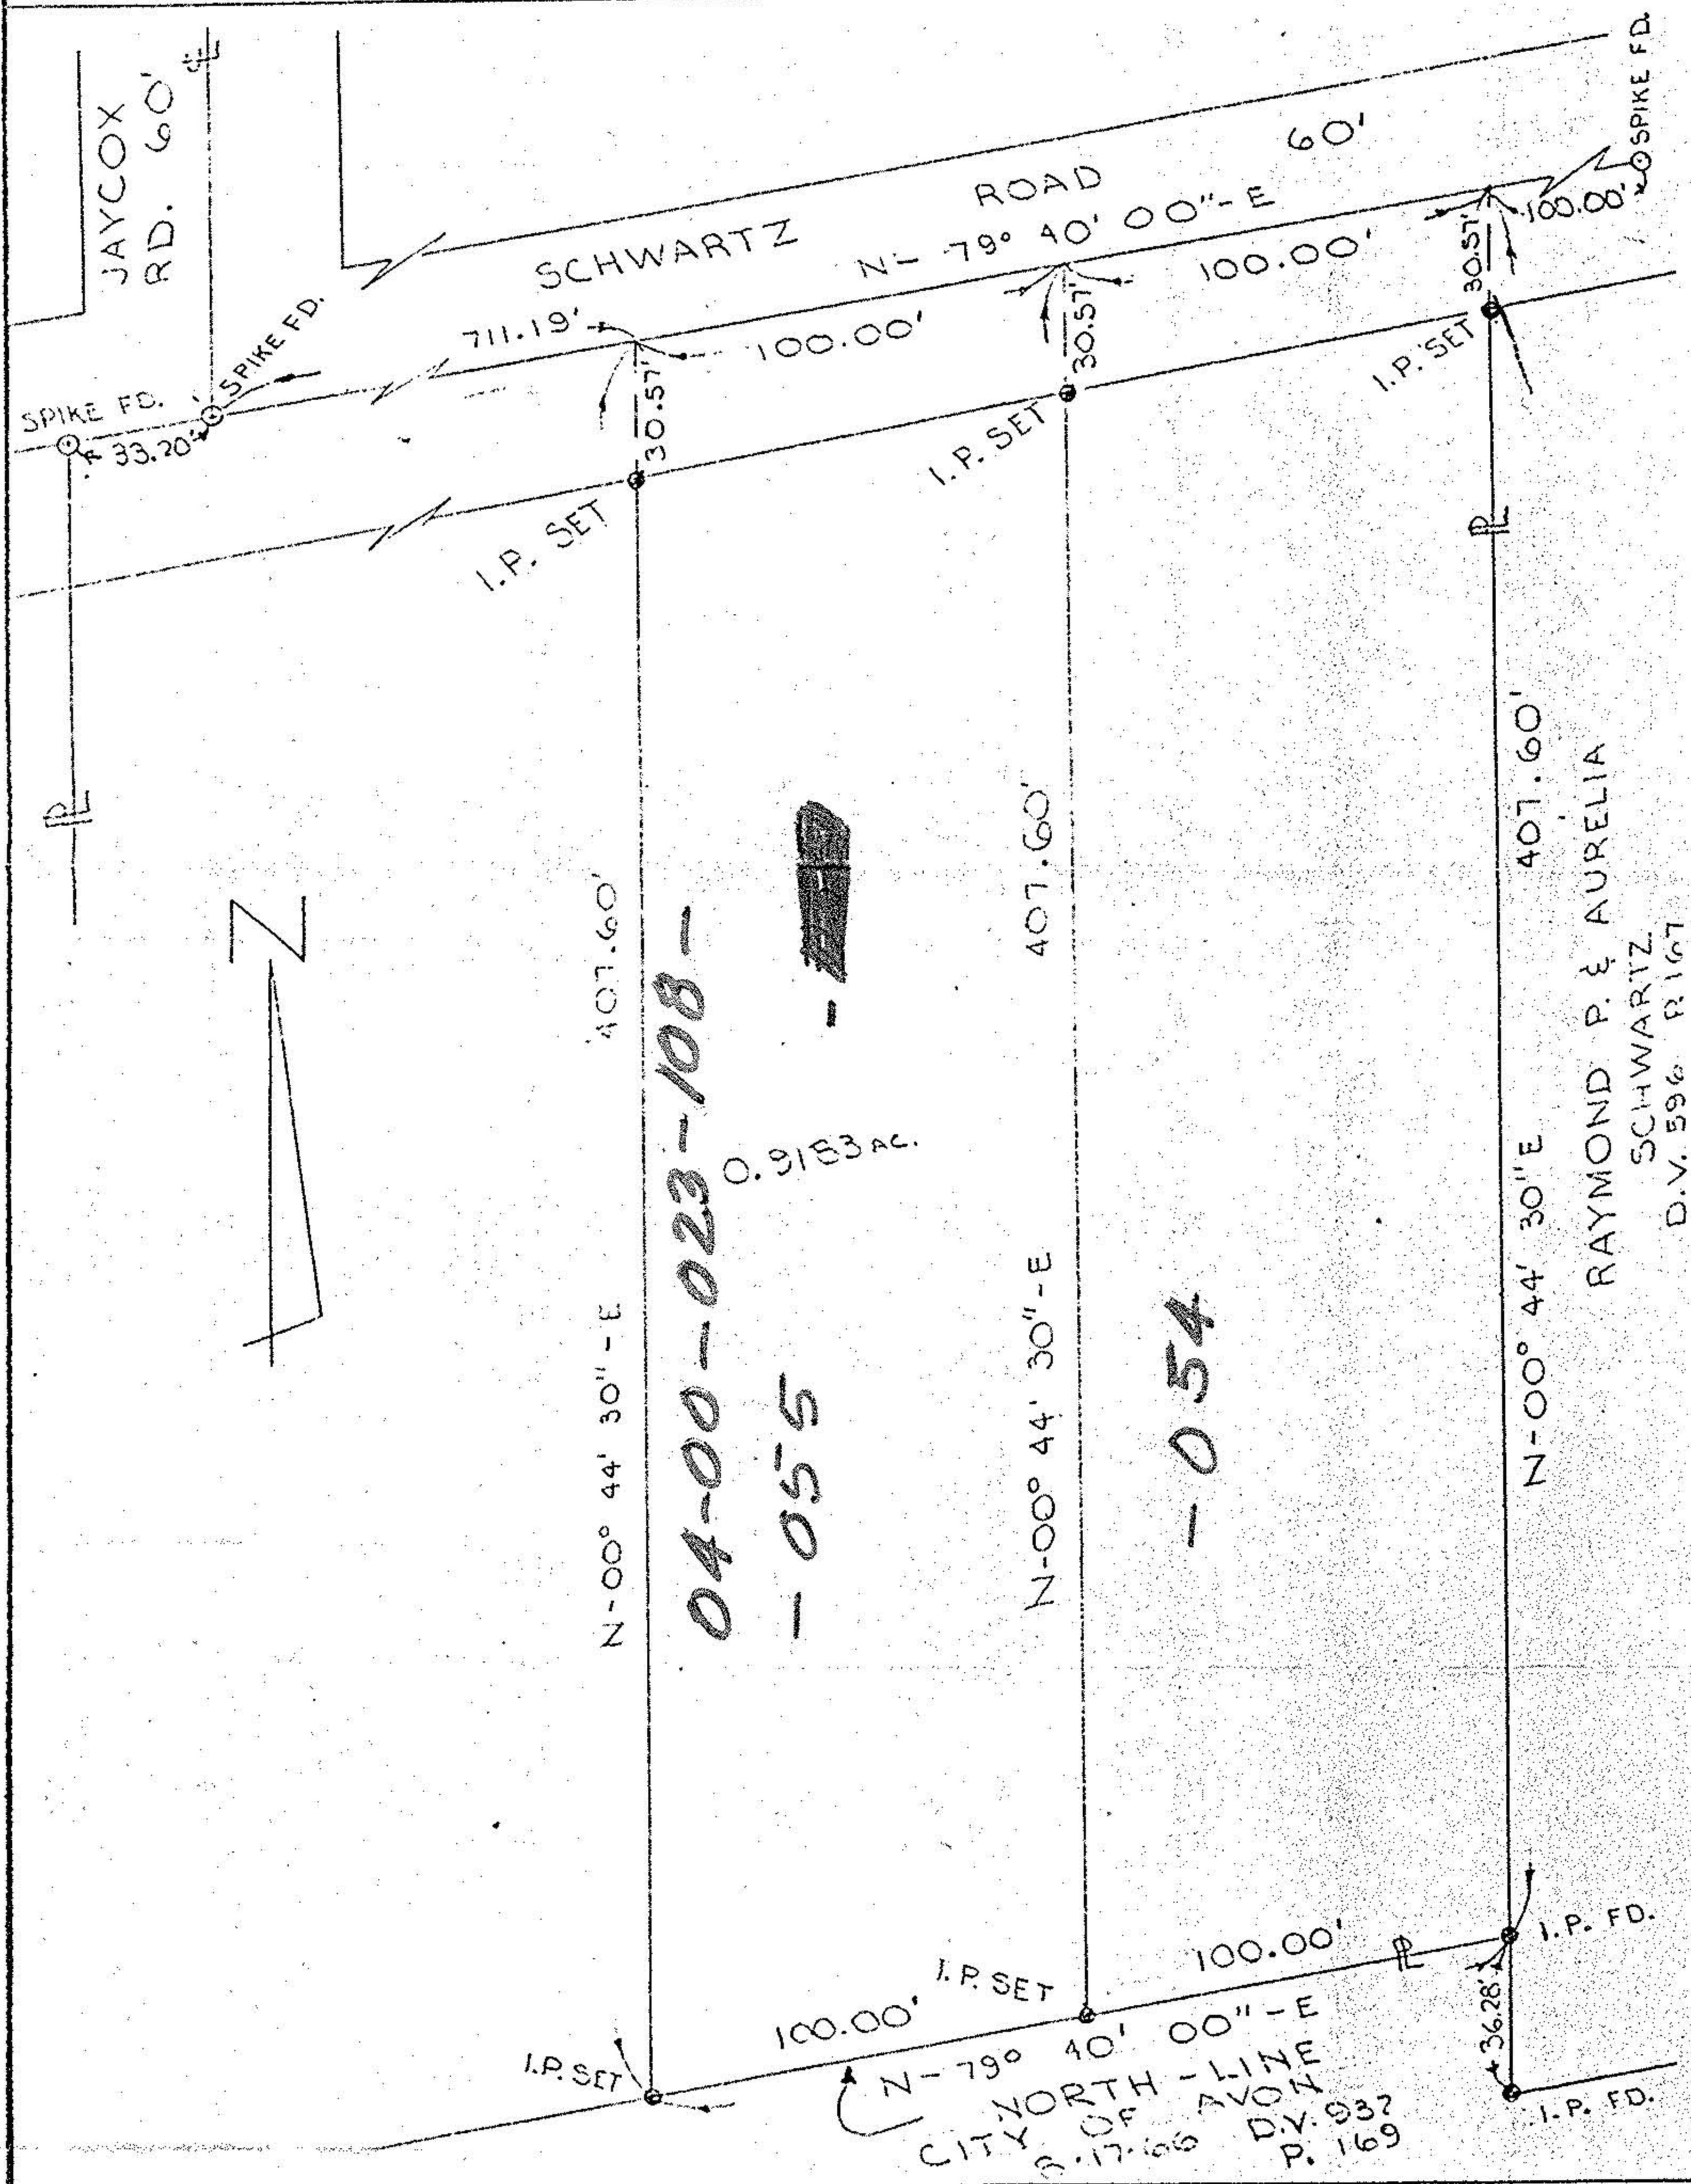

4-00-023 G

Sec. 23

Prepared for: RAYMOND SCHWARTZ 4-00-023-108

Scale: 1" = 50' Date: 6-1-76 Dr. by: P.M. Job No 70-183

RAYMOND P. & AURELIA SCHWARTZ
D.V. 596 P. 167