KLEINOEDER · SCHMIDT and ASSOCIATES

ENGINEERS — SURVEYORS — CONSULTANTS in LAND PLANNING

ELYRIA - NORWALK - MEDINA OHIO

PLOT PLAN

JOB Nº 77-66

SUBLOT

SUBDIVISION

OTHER PART OF AVON TOWNSHIP SECTION NO. 23
CITY OF AVON COUNTY OF LORAIN STATE OF OHIO

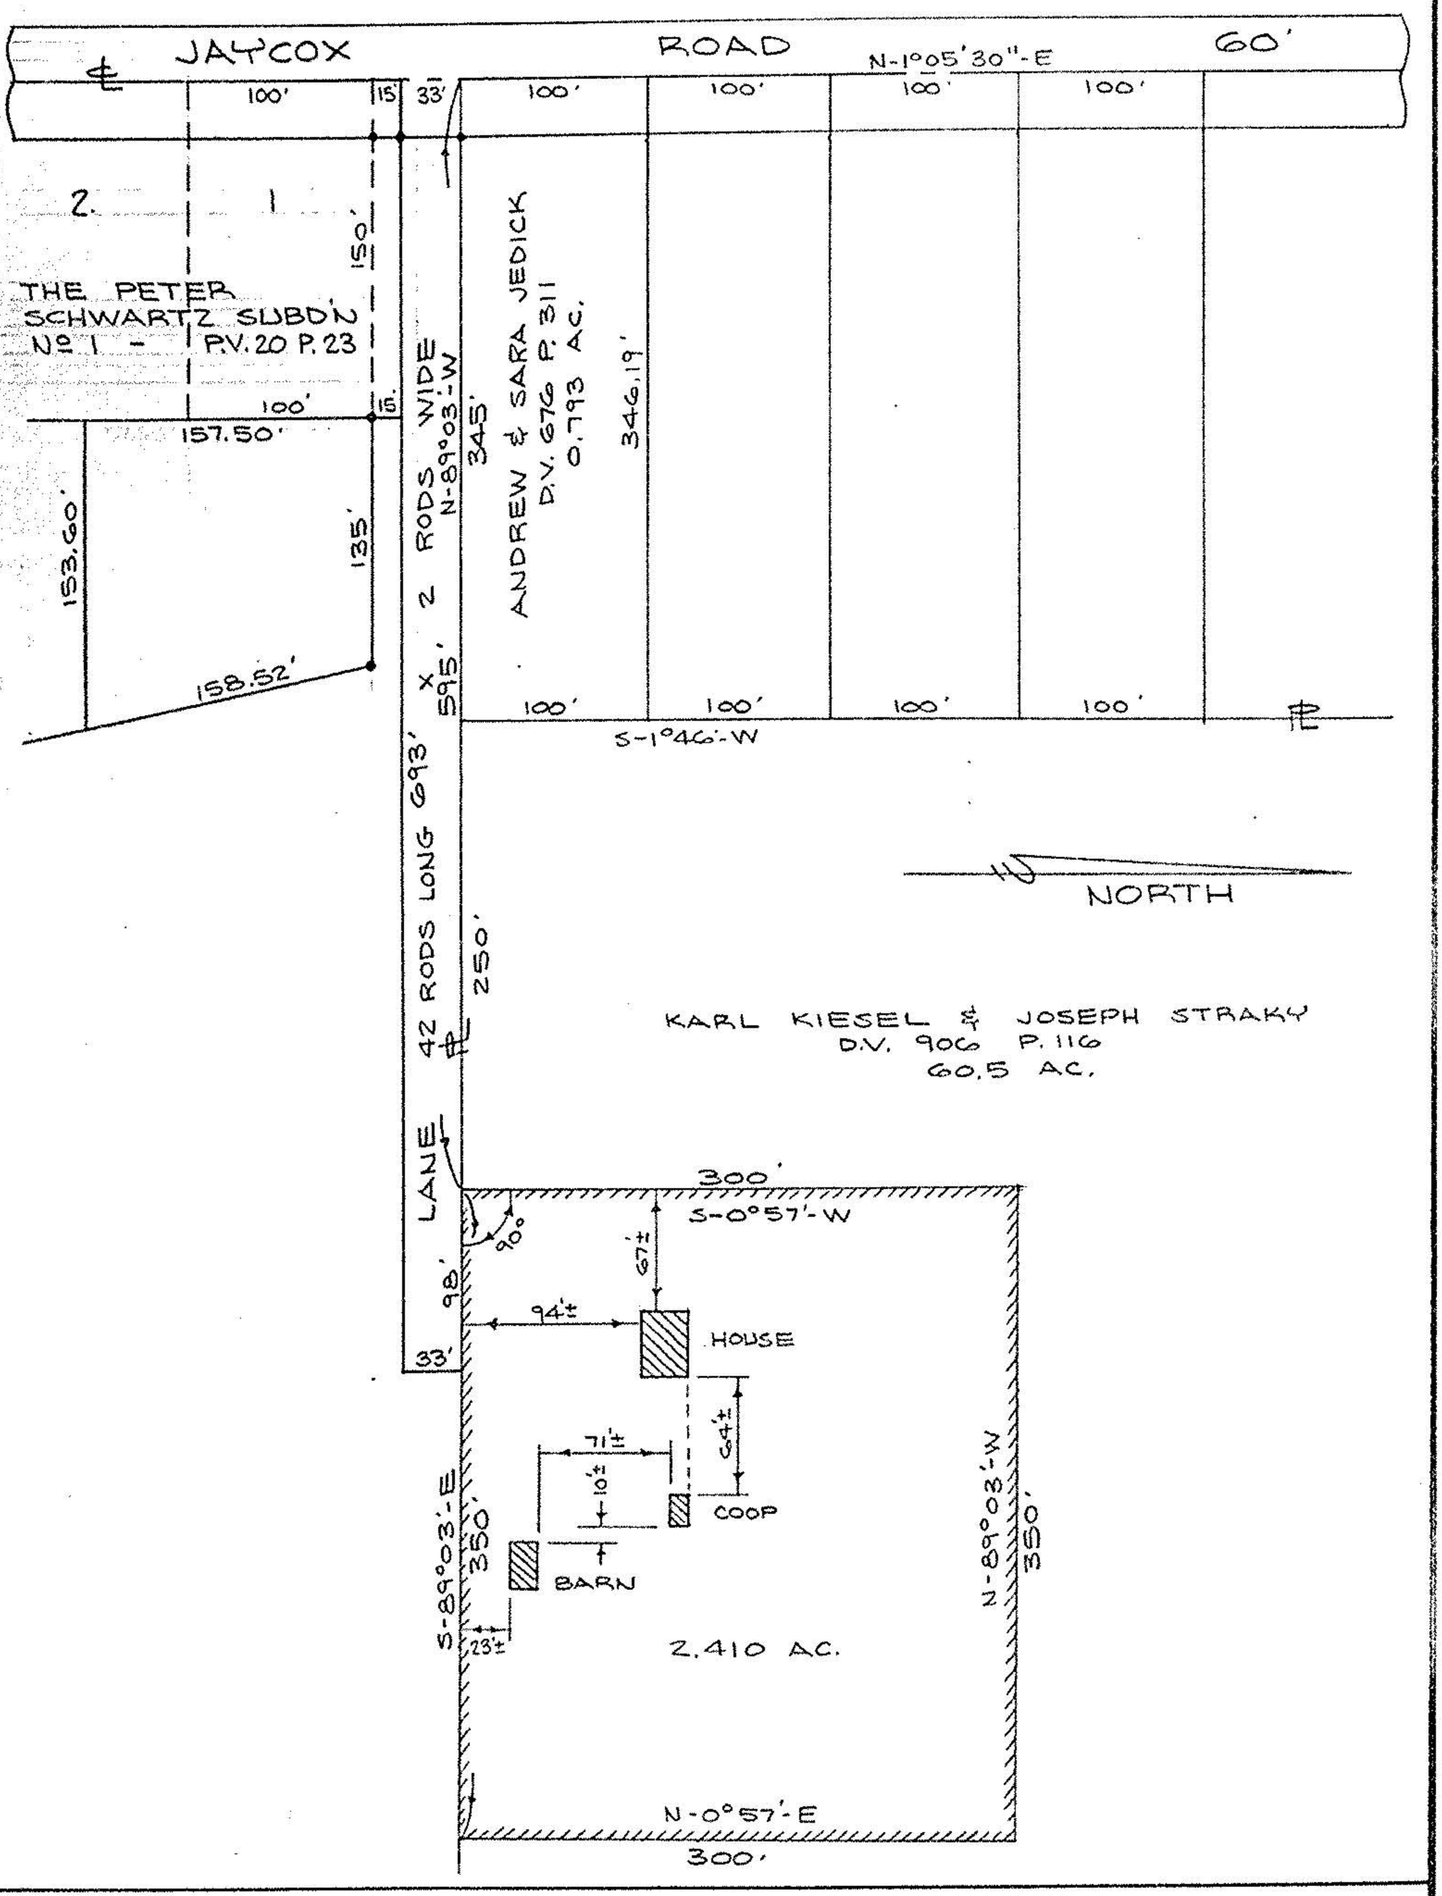

Prepared for: KARL KIESEL

Scale: 1" = 100' **Date:** MAR. 26, 1977