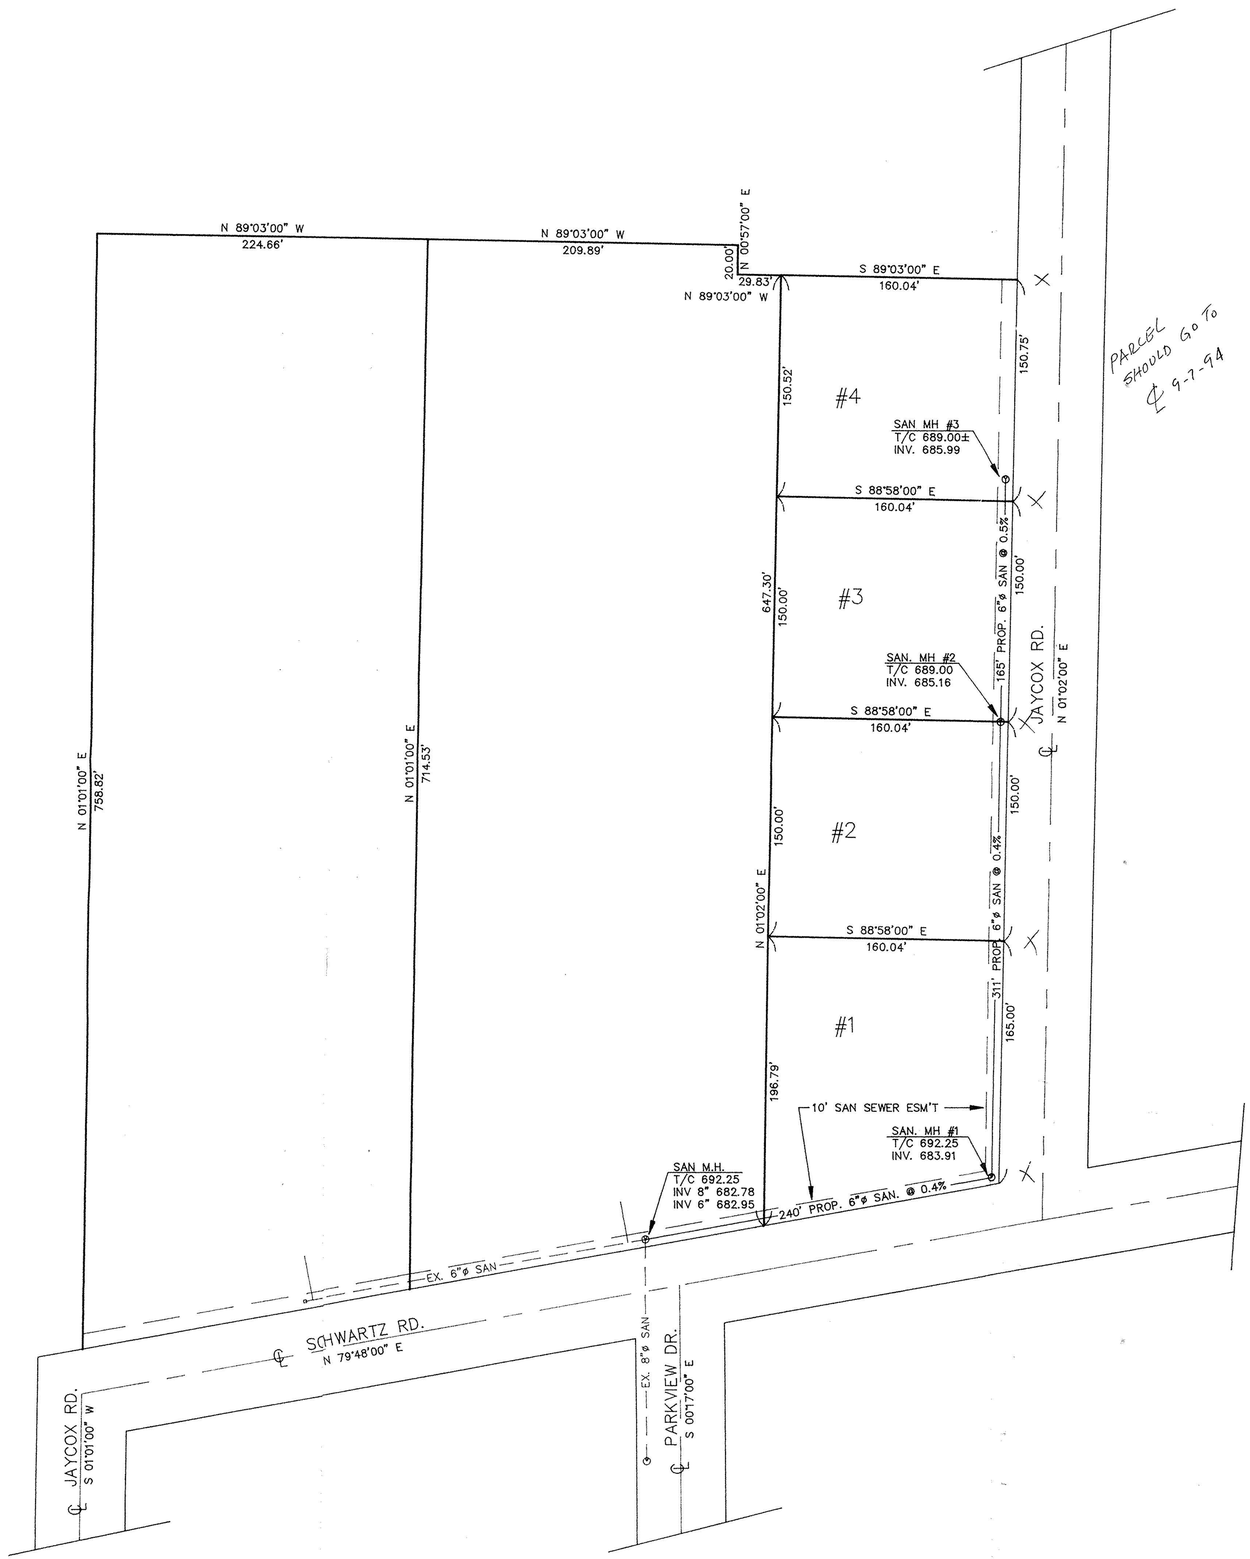

PARCEL SHOULD GO TO ℄ 9-7-94

N

GRAPHIC SCALE

50 0 25 50 100 200

(IN FEET)
1 inch = 50 ft.
FEBRUARY 28, 1994

[redacted]

PRELIMINARY PLAN
SANITARY SEWER EXTENSION
SCHWARTZ RD. & JAYCOX RD.

BY:
MICHAEL ZUNICH AND ASSOCIATES
35888 CENTER RIDGE ROAD
NORTH RIDGEVILLE, OHIO 44039
PH: (216)327-7740

NOT A BOUNDARY SURVEY

STATE OF OHIO
MICHAEL H. ZUNICH
E-35312
REGISTERED
PROFESSIONAL ENGINEER