14-00-077-000

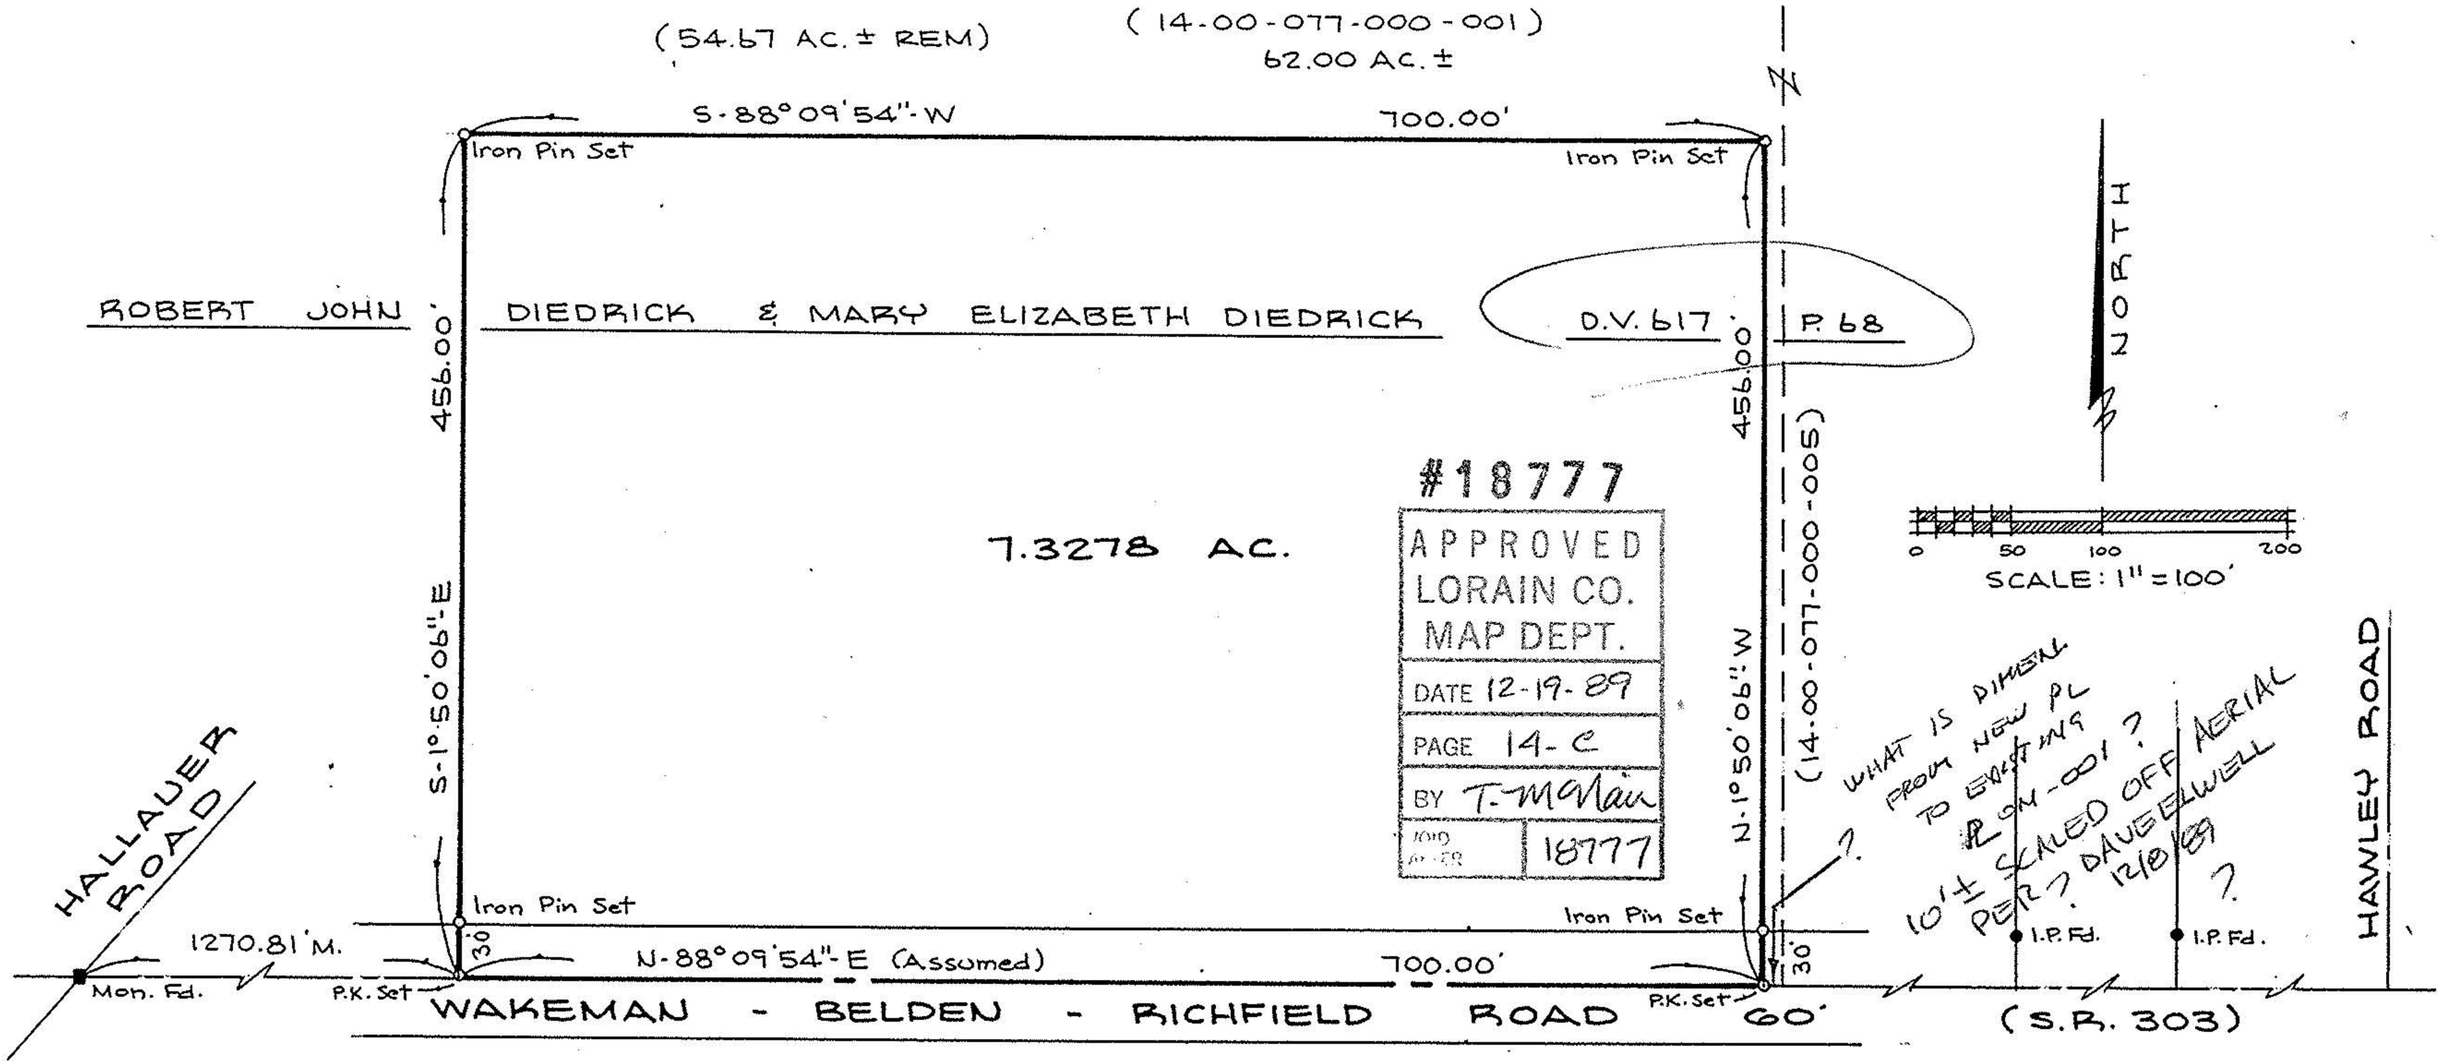

#18777
APPROVED
LORAIN CO.
MAP DEPT.
DATE 12-19-89
PAGE 14-C
BY T. McNair
VOID AFTER 18777

STATE OF OHIO
DAVID L. ELWELL
6333
REGISTERED SURVEYOR

David L. Elwell
REG. SURV. NO. 6333

BOUNDARY SURVEY

PART OF PITTSFIELD TOWNSHIP
TOWNSHIP OF PITTSFIELD COUNTY OF LORAIN
STATE OF OHIO

PREPARED BY

KS ASSOCIATES INC.
ENGINEERS SURVEYORS

89-509