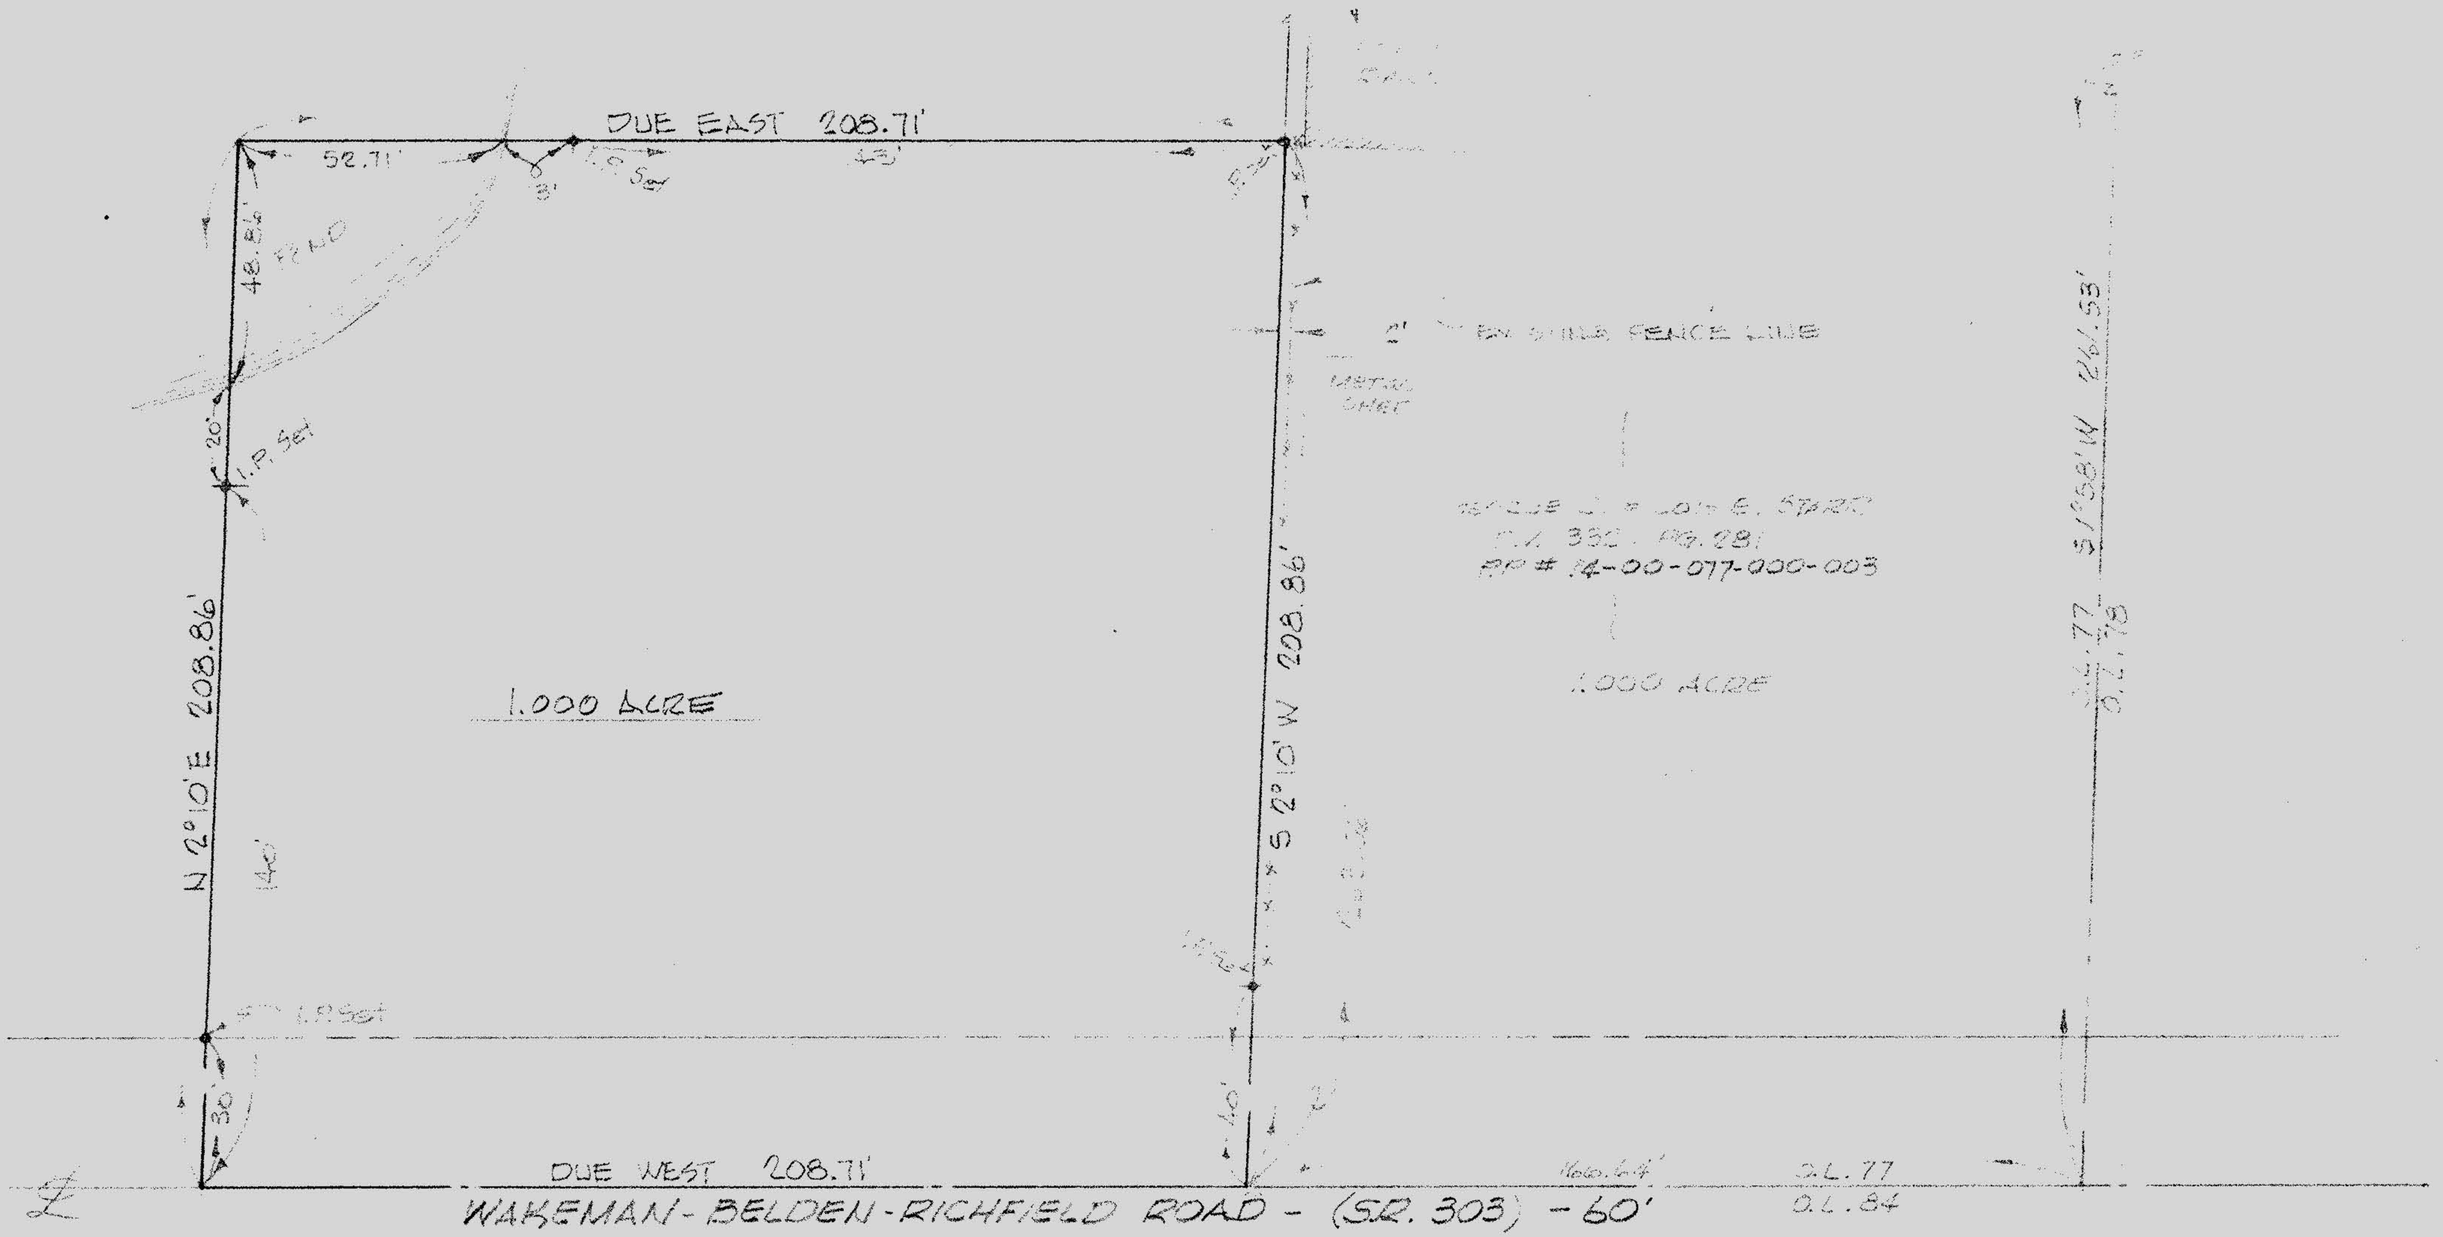

MAP of SURVEY

PREPARED FOR ROBERT G. DIEDRICK

PART of ORIGINAL PITTSFIELD TWP. LOT NO. 77

TOWNSHIP of PITTSFIELD, LORAIN COUNTY, OHIO

NORTH

SCALE: 1" = 30'

McGLINCHY and ASSOCIATES INC.
PROFESSIONAL ENGINEER and SURVEYORS
110½ MIDDLE AVE. ELYRIA OHIO
AUGUST, 1980 #806416