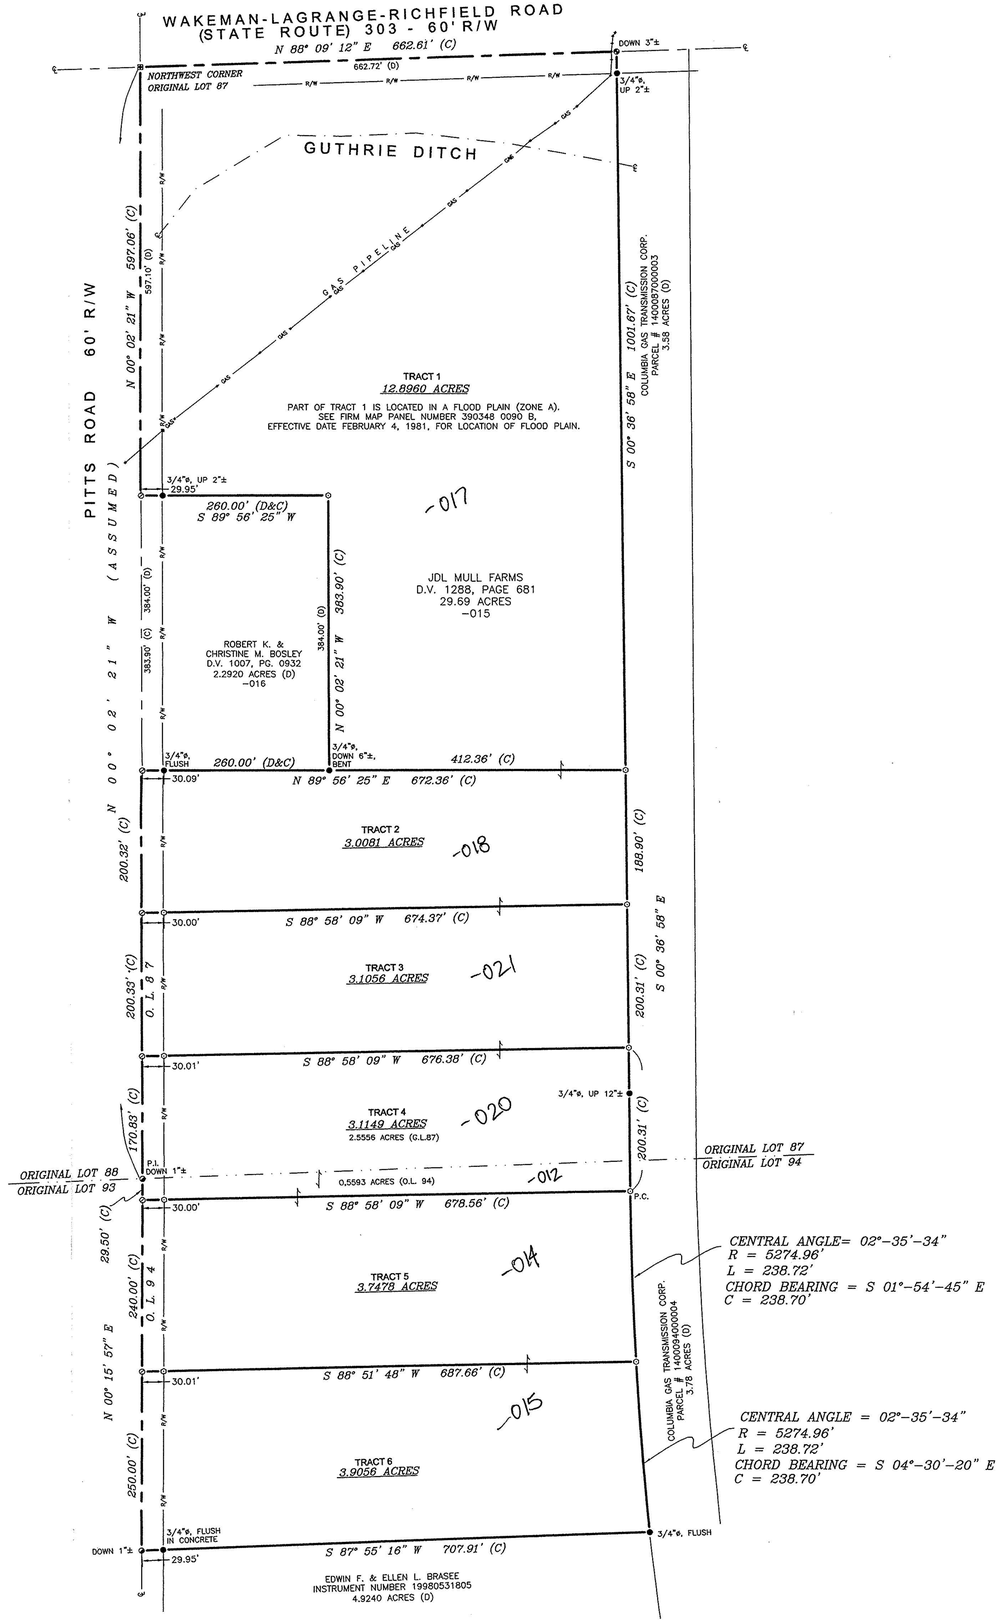

NORTH
ASSUMED

0 100' 200'
SCALE IN FEET

BOUNDARY LEGEND

SET	FOUND	DESCRIPTION
		CONC. MONUMENT
		RAILROAD SPIKE
		NAIL
		IRON ROD
		DRILL HOLE
		STONE
		MONUMENT BOX
		IRON PIPE
		WOOD POST
	(D)	DEED
	(P)	PLAT
	(M)	MEASURED
	(S)	SURVEYED
	(C)	CALCULATED

REFERENCES

DEED VOLUME AND PAGE AS SHOWN

SURVEY FOR ETHEL A. SECHREST BY
RODGER G. SIMON, DATED AUGUST 19,1981
REVISED FOR DAVID MULL
DATED JUNE 30, 1983
REVISED FOR EDWIN BRASSEE
DATED FEBRUARY, 1998

00885

APPROVED
LORAIN CO.
MAP DEPT

DATE 10-2-01
PAGE 14-F
BY JHATFIELD
#01-00885

NOTE:
ALL IRON ROD SET ARE 5/8" DIA. x 30" LENGTH WITH PERSONALIZED CAPS (HANK AND ASSOC.) DRIVEN FLUSH.

SURVEYOR'S STATEMENT

I HEREBY DECLARE THAT THE ABOVE PARCEL WAS SUREYED DURING AUGUST, 2001, PROPERTY LINES SHOWN ARE LOCATED FROM DEEDS ON RECORD AND ARE DEED LINES. BEARINGS ARE ASSUMED FOR ANGULAR MEASUREMENT ONLY. ALL INFORMATION SHOWN IS TRUE AND CORRECT TO THE BEST OF MY KNOWLEDGE AND BELIEF (PER CHAPTER 4733-37 OF THE OHIO REVISED CODE).

STATE OF OHIO
JAMES GORDON HOMAN, JR.
S-6972
REGISTERED PROFESSIONAL SURVEYOR

JAMES G. HOMAN, JR., P.S. # 6972 — 09-05-01 DATE

REVISIONS:	1
CHECKED BY:	DCT
DRAWN BY:	LGS
	SCALE 1" = 100'
	DATE: 08-28-01

PLAT OF SURVEY FOR:
SPRINKLE / MULL
LOCATED IN PARTS OF ORIGINAL LOTS 87 & 94
PITTSFIELD TOWNSHIP, TOWNSHIP-4-NORTH, RANGE-18-WEST,
LORAIN COUNTY, OHIO.

HANK AND ASSOCIATES, INC.
ENGINEERING SURVEYING
137 SOUTH WASHINGTON STREET
TIFFIN, OHIO 44883
PHONE: (419) 447-4300 FAX: (419) 447-2076

JOB NO. 2011.141

1 / 1