21-F

21-01-011

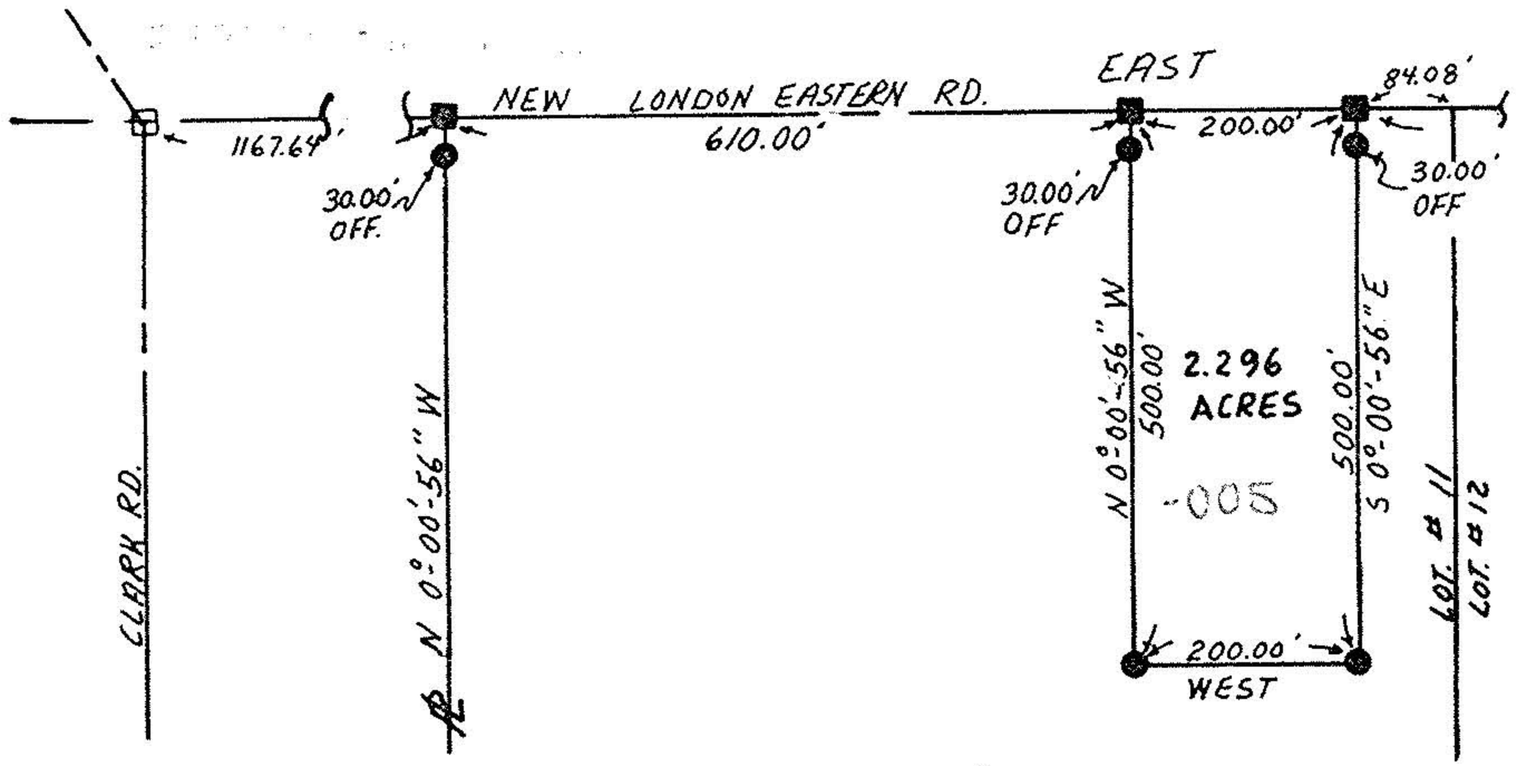

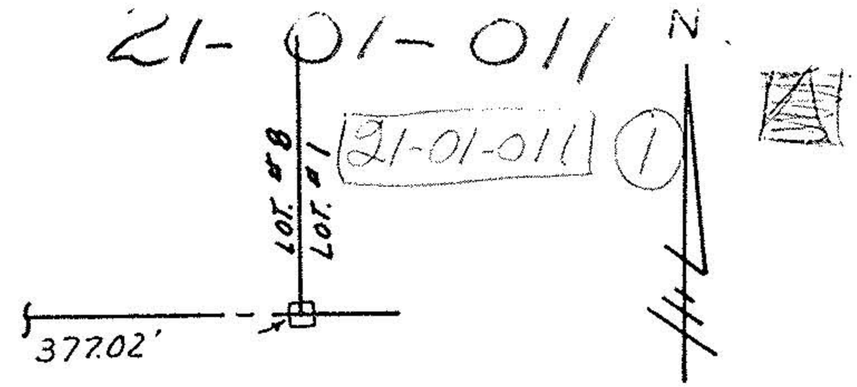

I hereby certify this plat to be a true delineation of a field survey by Hudnut-Laughery and Associates in September, 1979.

Ronald L. Laughery
Ronald L. Laughery, P. S. No. 6111

Plat of a survey to locate and describe a portion of the Original Huntington Township, Lot No. 11, Tract No. 1.

#13174

APPROVED
LORAIN CO.
MAP DEPT.

DATE 10-19-79
PAGE 21-F
BY T. McNair
VOID AFTER

0 200' 400' 600'
Scale 1" = 200'

SYMBOLS

- □ Railroad Spike Found
- ○ Iron Pin Found
- ■ Railroad Spike Set
- ● Iron Pin Set

Note: All Bearings Shown are for Determination of Angles Only

HUDNUT - LAUGHERY & ASSOCIATES
Engineering & Surveying
1283 Center Lane Drive
Ashland, Ohio 44805

Huntington Township, Tract No. 1, Lot No. 11, Lorain County, Ohio.