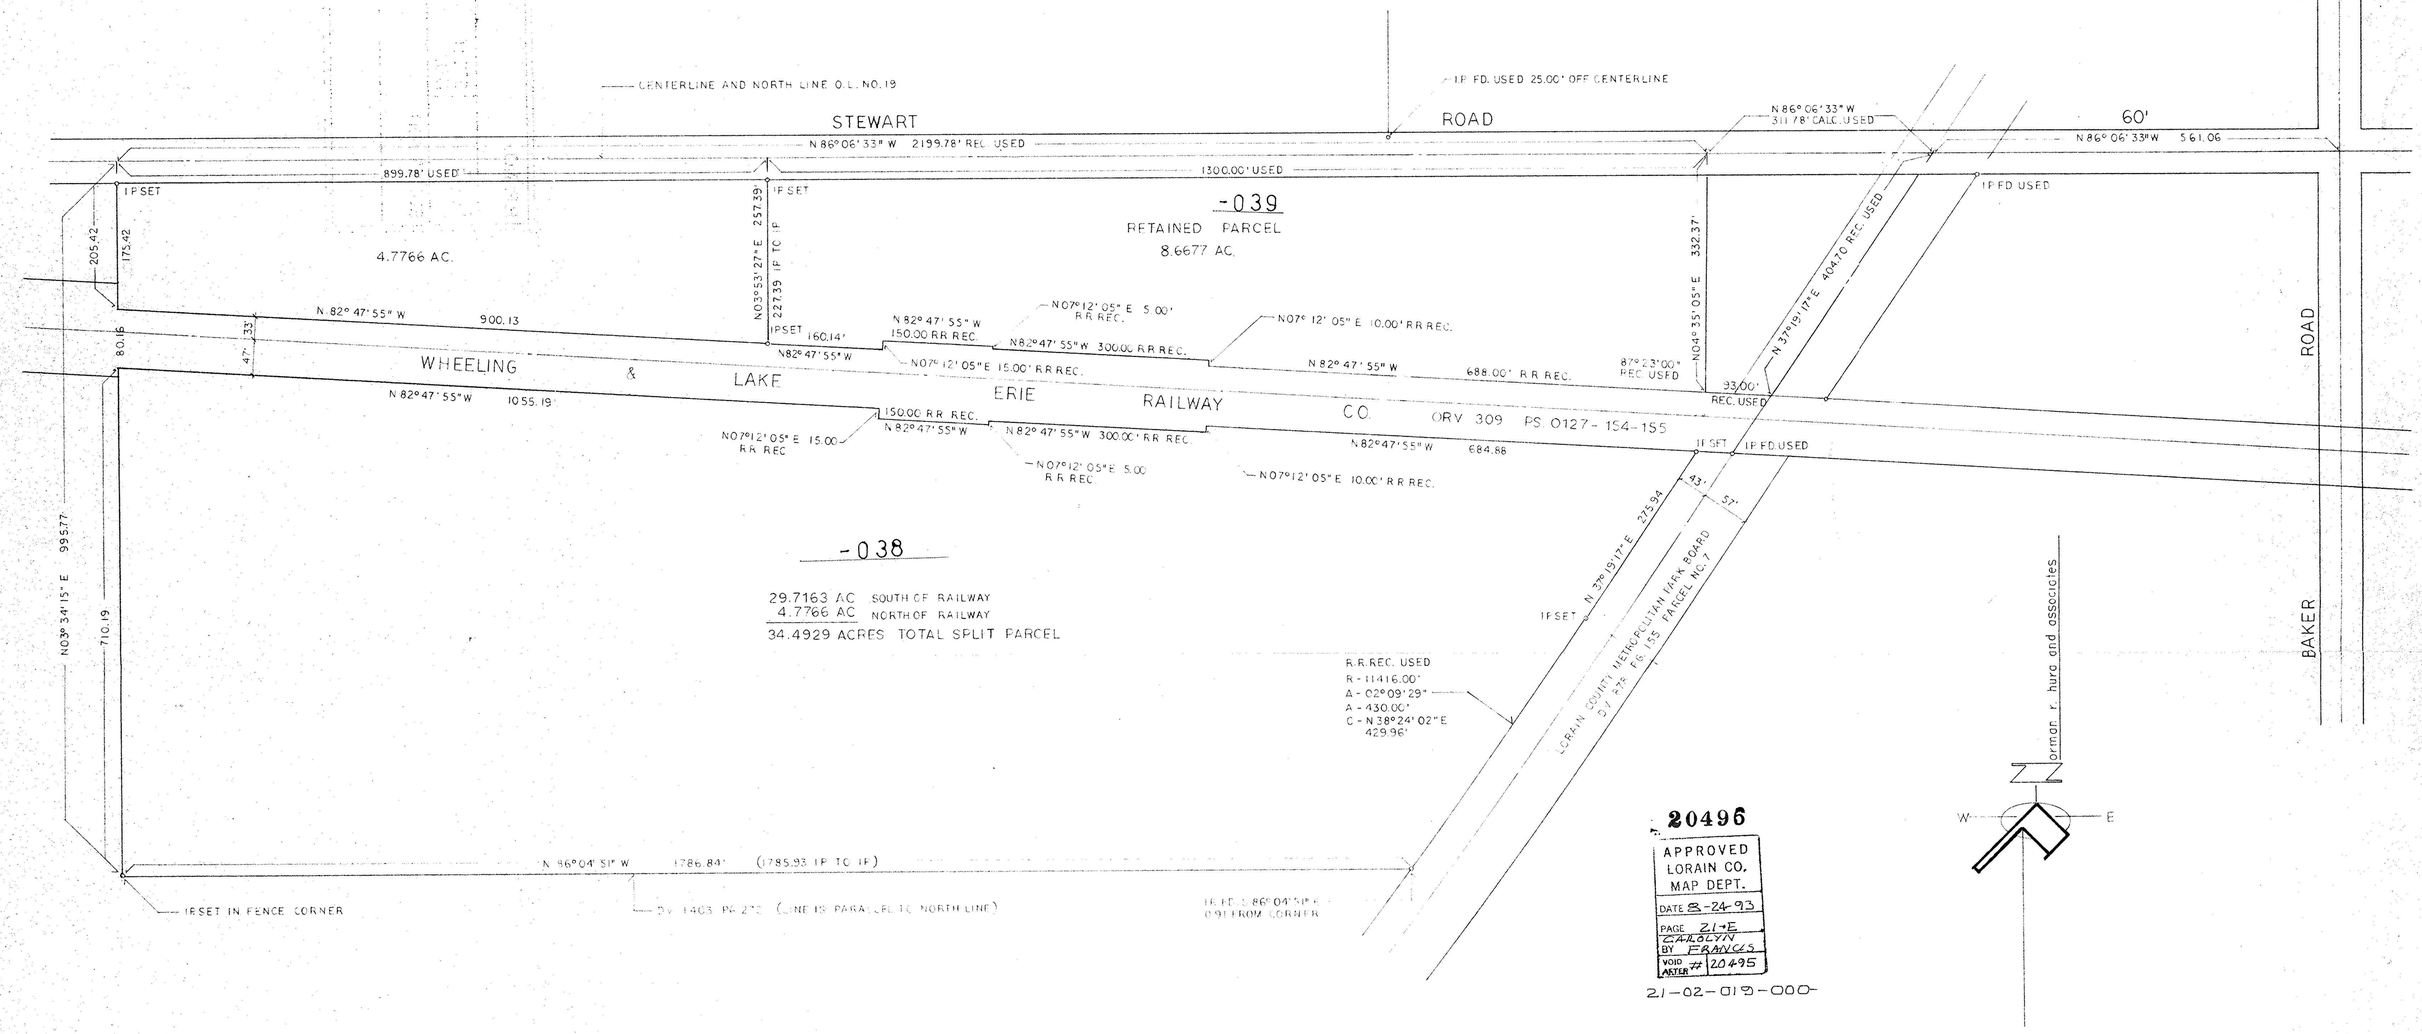


APPROVED
LORAIN CO.
MAP DEPT.
DATE 8-24-93
PAGE 21-E
BY CAROLYN FRANCIS
VOID AFTER # 20495

21-02-019-000-

LORAIN COUNTY METROPOLITAN PARK DISTRICT	LOT SPLIT FROM PPN 21-02-019-000-001 PART OF ORIGINAL LOT NO. 19 TRACT NO. 2 HUNTINGTON TOWNSHIP - LORAIN CO. OHIO	PRESENT OWNER FRANK P. & MARY S. SIMONSON DV 1403 PG 271-272	MAY 1993 SCALE 1" = 100'-0"	STATE OF OHIO N. R. HURA S 5208 REGISTERED PROFESSIONAL SURVEYOR