




STATE OF OHIO
DEPARTMENT OF TRANSPORTATION
LOR-162-6.198
HUNTINGTON TOWNSHIP
LORAIN COUNTY

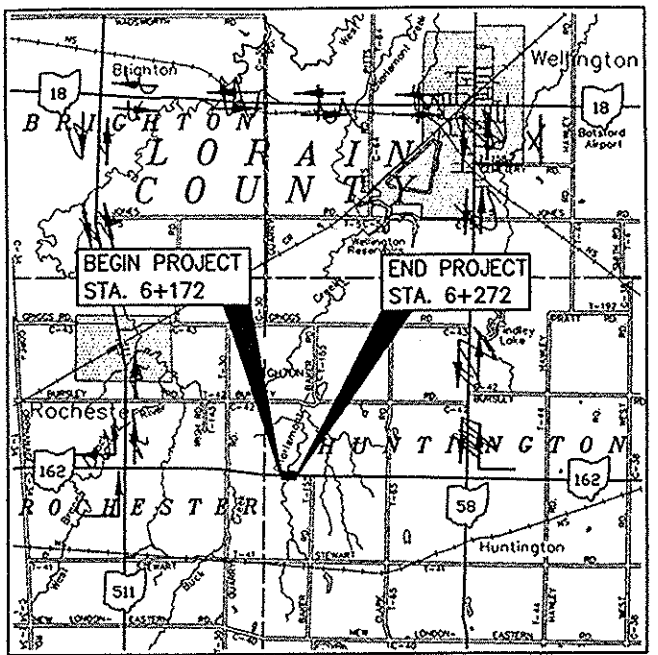

Detour to go south to US 224

Info Only min 3.8

PROJECT DESCRIPTION
REPLACEMENT OF CONCRETE ARCH CULVERT CROSSING CHARLEMONT CREEK WITH A PREFABRICATED STRUCTURE WITH FOOTERS AND ROADWAY WORK TO IMPROVE EXISTING VERTICAL CURVE AND APPROACH RECONSTRUCTION. TOTAL PROJECT LENGTH IS 100 METERS. *Give km nearest road*

1997 SPECIFICATIONS
THE STANDARD SPECIFICATIONS OF THE STATE OF OHIO, DEPARTMENT OF TRANSPORTATION, INCLUDING CHANGES AND SUPPLEMENTAL SPECIFICATIONS LISTED IN THE PROPOSAL SHALL GOVERN THIS IMPROVEMENT.

MAINTENANCE OF TRAFFIC ENDORSEMENT
I HEREBY APPROVE THESE PLANS AND DECLARE THAT THE MAKING OF THIS IMPROVEMENT WILL REQUIRE THE CLOSING OF TRAFFIC OF THE HIGHWAY, AND THAT DETOURS WILL BE PROVIDED AS INDICATED ON THIS SHEET.

RECEIVED
JUN 19 2000
DEPT. OF TRANSPORTATION
DISTRICT 3
RW DEPT.

No Const. Cost estimate provided. Scope required this @ Stage 3.

#00890

APPROVED
LORAIN CO.
MAP DEPT
DATE 10-4-01
PAGE 21-E
BY JHATFIELD
#01-00890

UNDERGROUND UTILITIES
TWO WORKING DAYS BEFORE YOU DIG
CALL 1-800-362-2764 (Toll Free)
OHIO UTILITIES PROTECTION SERVICE
NON-EMERGENCY MUST BE CALLED DIRECTLY

Scope required this @ Stage 3

SPECIAL PROVISIONS
WATERWAY PERMIT NWP# _____ DATE: _____

STANDARD CONSTRUCTION DRAWINGS				SUPPLEMENTAL SPECIFICATIONS								
BP-3.1M	10-28-94	GR-1.1M	10-21-97	DM-1.1M	10-21-97	TC-41.20M	07-01-94	MT-101.60M	04-25-94	STW STD. DWGS?	806	09-09-97
		GR-1.2M	01-03-96	DM-4.2M	06-30-95	TC-52.10M	07-29-94	MT-105.10M	04-25-94		814	08-02-98
		GR-1.3M	11-30-94	DM-4.3M	04-29-99	TC-52.20M	07-29-94	MT-105.11M	04-25-94		842	01-08-99
		GR-2.1M	04-14-98	DM-4.4M	04-29-99	TC-65.10M	11-03-93				863	10-12-99-09-97
		GR-2.2M	10-21-97			TC-65.13M	11-03-93				870	08-10-99
											877	04-13-99
											899	10-21-98
											904	05-05-98
											905	04-01-98
											906	05-05-98
											907	10-21-98
											908	01-06-99
		RM-1.1M	04-29-99			MC-105.11M	04-25-94					

PLAN PREPARED BY:
EUTHENICS INC.
CONSULTING ENGINEERS
975 Keynote Circle, Cleveland, Ohio

FEDERAL PROJECT NO. 16052
CONSTRUCTION PROJECT NO. 036240
RAILROAD INVOLVEMENT NONE
LOR-162-6.198

SUMMARY OF ADDITIONAL RIGHT OF WAY

TOTAL NUMBER OF :
3 OWNERSHIPS
0 TOTAL TAKES
0 OWNERSHIPS WITH STRUCTURES INVOLVED
0 OWNERSHIPS WITH PERSONALTY ITEMS

PARCEL NO.	OWNER	SHEET NO.	OWNERS RECORD BOOK PAGE	AUDITOR'S PARCEL	RECORD AREA(ha)	TOTAL P.R.O. (ha)	GROSS TAKE (ha)	P.R.O. IN TAKE (ha)	NET TAKE (ha)	STRUCTURE	NET RESIDUE (ha)		TYPE FUND	REMARKS AND PERSONALTY	AS ACQUIRED	
											LEFT	RIGHT			PAGE	BOOK
1-T	JARVIS M. BABCOCK & ALICE L. BRADLEY & KATHERINE J. SILVER	4	0R1297 200	21-05-033-000-001	20.2344 (50.00 Ac.)	0.3116 (0.77 Ac.)	0.0030 (0.007 Ac.)	-	0.0030 (0.007 Ac.)	NO	20.2344 (50.00 Ac.)	-	State	GRADING OPERATIONS		
				21-04-000-000-001	20.7564 (51.29 Ac.)	0.3480 (0.86 Ac.)	-	-	-	NO	-	20.7564 (51.29 Ac.)				
2-WD	JARVIS MEACH BABCOCK	4, 5	446 66	21-05-033-000-002	21.0437 (62.00 Ac.)	0.5180 (1.28 Ac.)	0.1987 (0.491 Ac.)	0.0822 (0.203 Ac.)	0.1165 (0.288 Ac.)	NO	20.4092 (50.4320 Ac.)	-		GRADING OPERATIONS AND REPLACEMENT OF CULVERT		
3-WD	KARL AND REBECCA UNANGST	4, 5	970 925	21-04-000-000-023	32.4154 (80.10 Ac.)	1.0198 (2.52 Ac.)	0.1915 (0.473 Ac.)	0.0823 (0.203 Ac.)	0.1092 (0.270 Ac.)	NO	31.2864 (77.510 Ac.)	-	State	GRADING OPERATIONS AND REPLACEMENT OF CULVERT		

REVISED
10-30-01

FEDERAL PROJECT NO. 16052
STATE JOB NO. 036240
P.L.D. NO. 16052
RW DESIGNER DIB
RW REVIEWER EPS
SUMMARY OF ADDITIONAL RIGHT OF WAY
LOR-162-6.198
1/23