WILLIAM B. BARTON
Reg. Land Surveyor No. 4438
188 PARKWOOD AVENUE
AVON LAKE, OHIO 44012
TELEPHONE (216) 933-6662

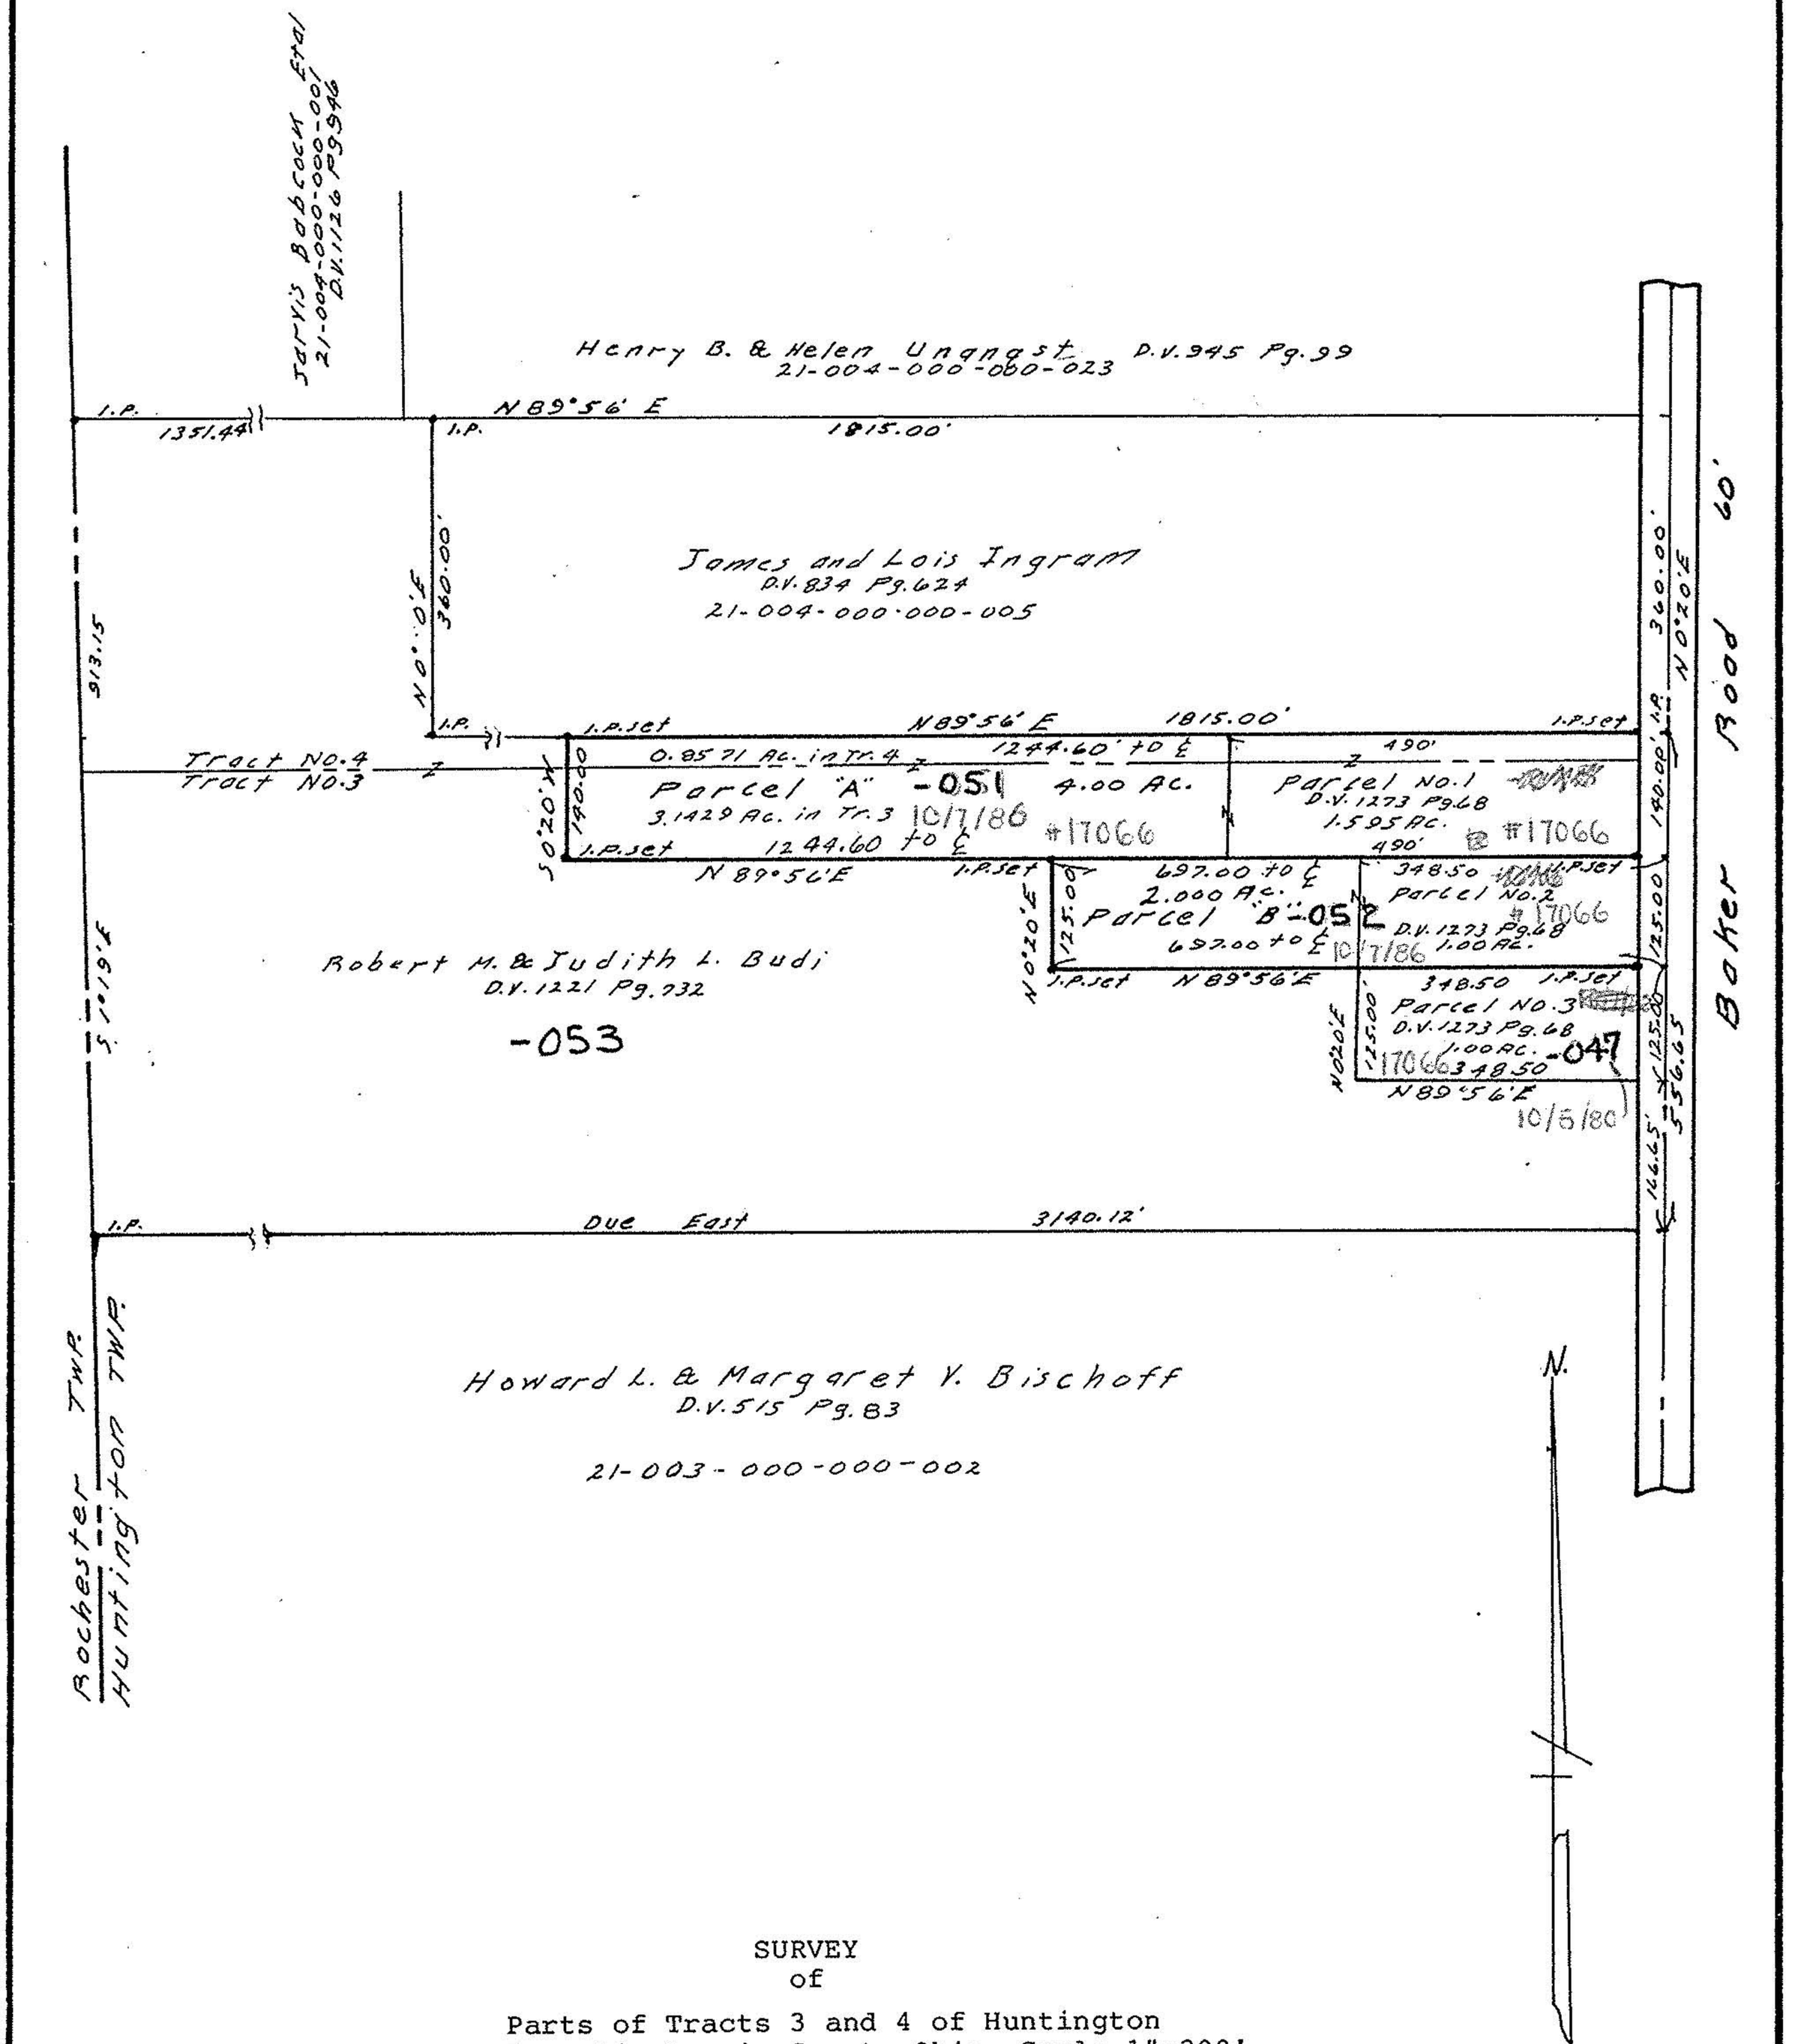

SURVEY
of

Parts of Tracts 3 and 4 of Huntington Township Lorain County Ohio. Scale 1"=200'
October 3,1986.

#17066

APPROVED
LORAIN CO.
MAP DEPT.
DATE 10-7-86
ENGR 21-E
BY C. FRANCIS
VOID AFTER 17066

STATE OF OHIO
WILLIAM B. BARTON
4438
REGISTERED SURVEYOR

21-E