West Huntington Twp. Lorain Co. Ohio
Aug. 7, 1980
[illegible] Koepp Reg. Surveyor No. 4306

21-05-004-000-029

21-B

#18079 VOID #17890

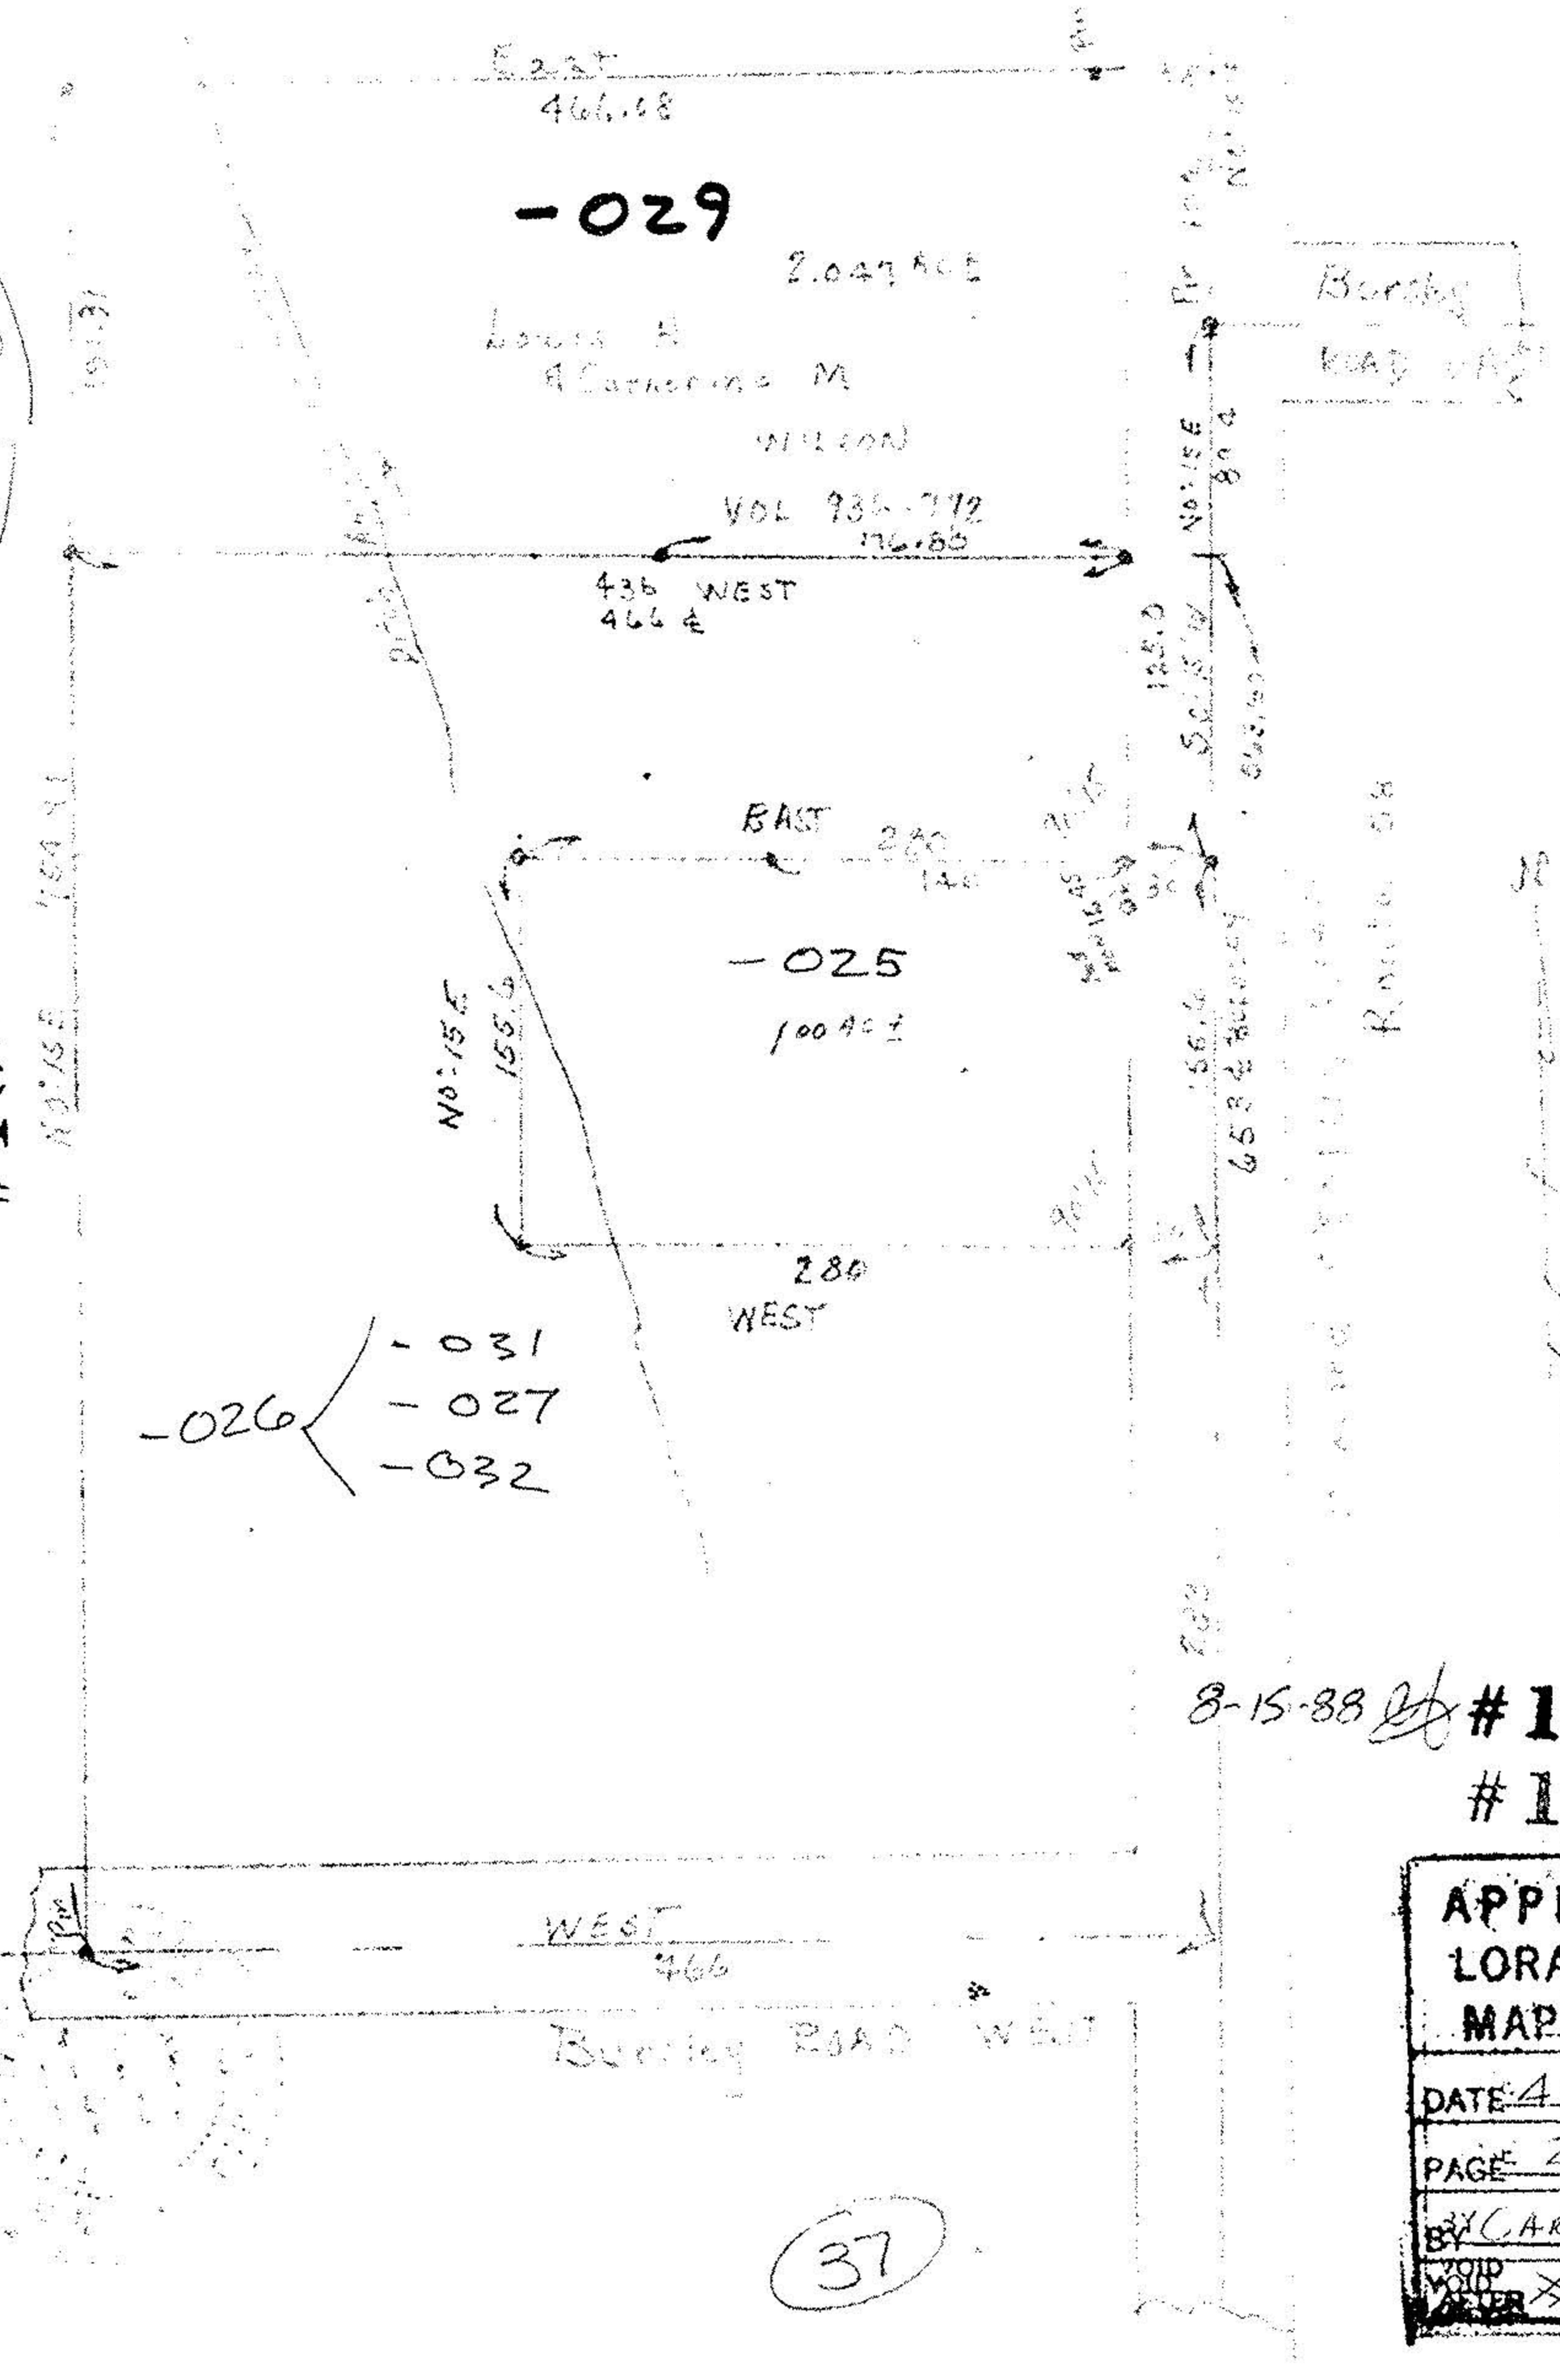

37

21-B

8-15-88 #18079
#17890

APPROVED
LORAIN CO.
MAP DEPT.
DATE 4-22-88
PAGE 21-B
BY CAROL-FRANCIS
VOID VOID #17890