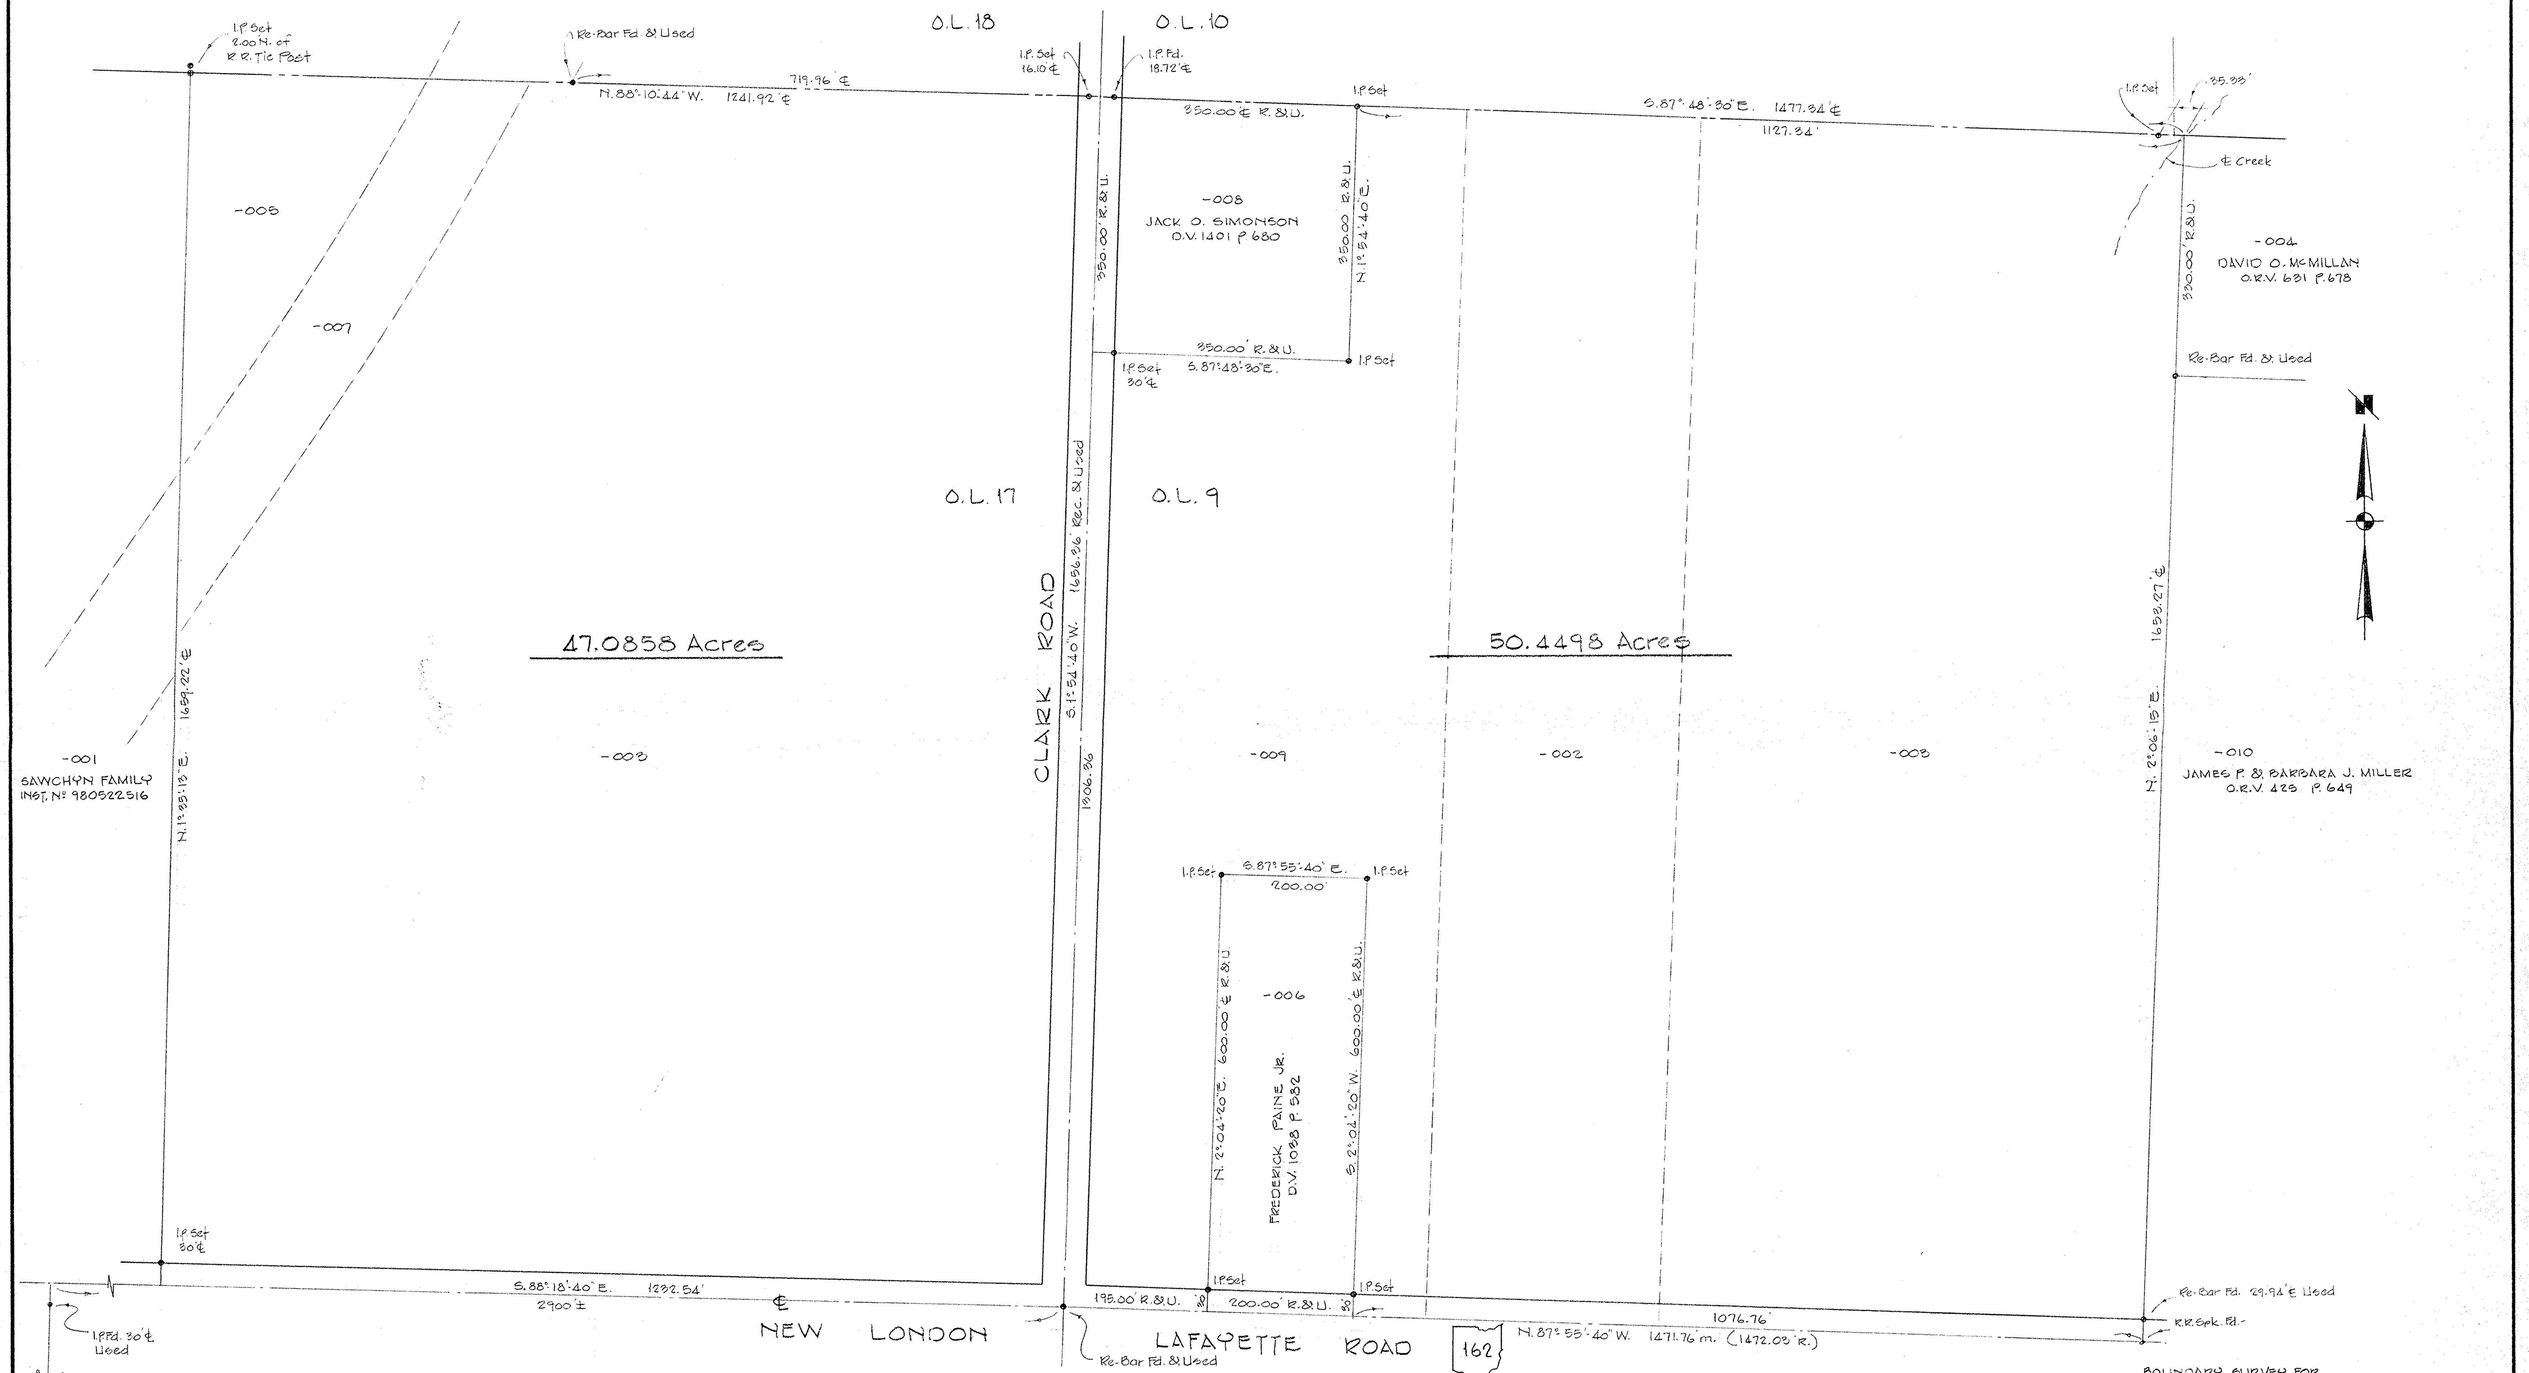

BOUNDARY SURVEY FOR

FRED L. & KATHRYN R. PAINE

PART OF O.L.s 9 & 17 TRACT 5 TOWNSHIP OF HUNTINGTON

COUNTY OF LORAIN STATE OF OHIO

SCALE 1" = 100' AUGUST, 1999

BY

LAUNDON • SIMON • CAHL & ASSOC.

PROFESSIONAL LAND SURVEYORS

F.B. 225/61-63

99-3152

369