




PLAT OF SURVEYS FOR
MRS. VIOLA HODGKIN

ORIGINAL LOT No. 29 - TRACT No. 5
HUNTINGTON TWP. - LORAIN COUNTY - OHIO
SCALE: 1"=100' APRIL & MAY - 1978
GARY E. PENFOLD Reg. Surveyor No. 4457

Ronald E. & Muriel
F. Twitting
D. Vol. 954 Pg. 724

Stephen & Mary Free
D. Vol. 365 Pg. 209

Notes: 0 indicates iron pin
found.
• indicates iron pin set.

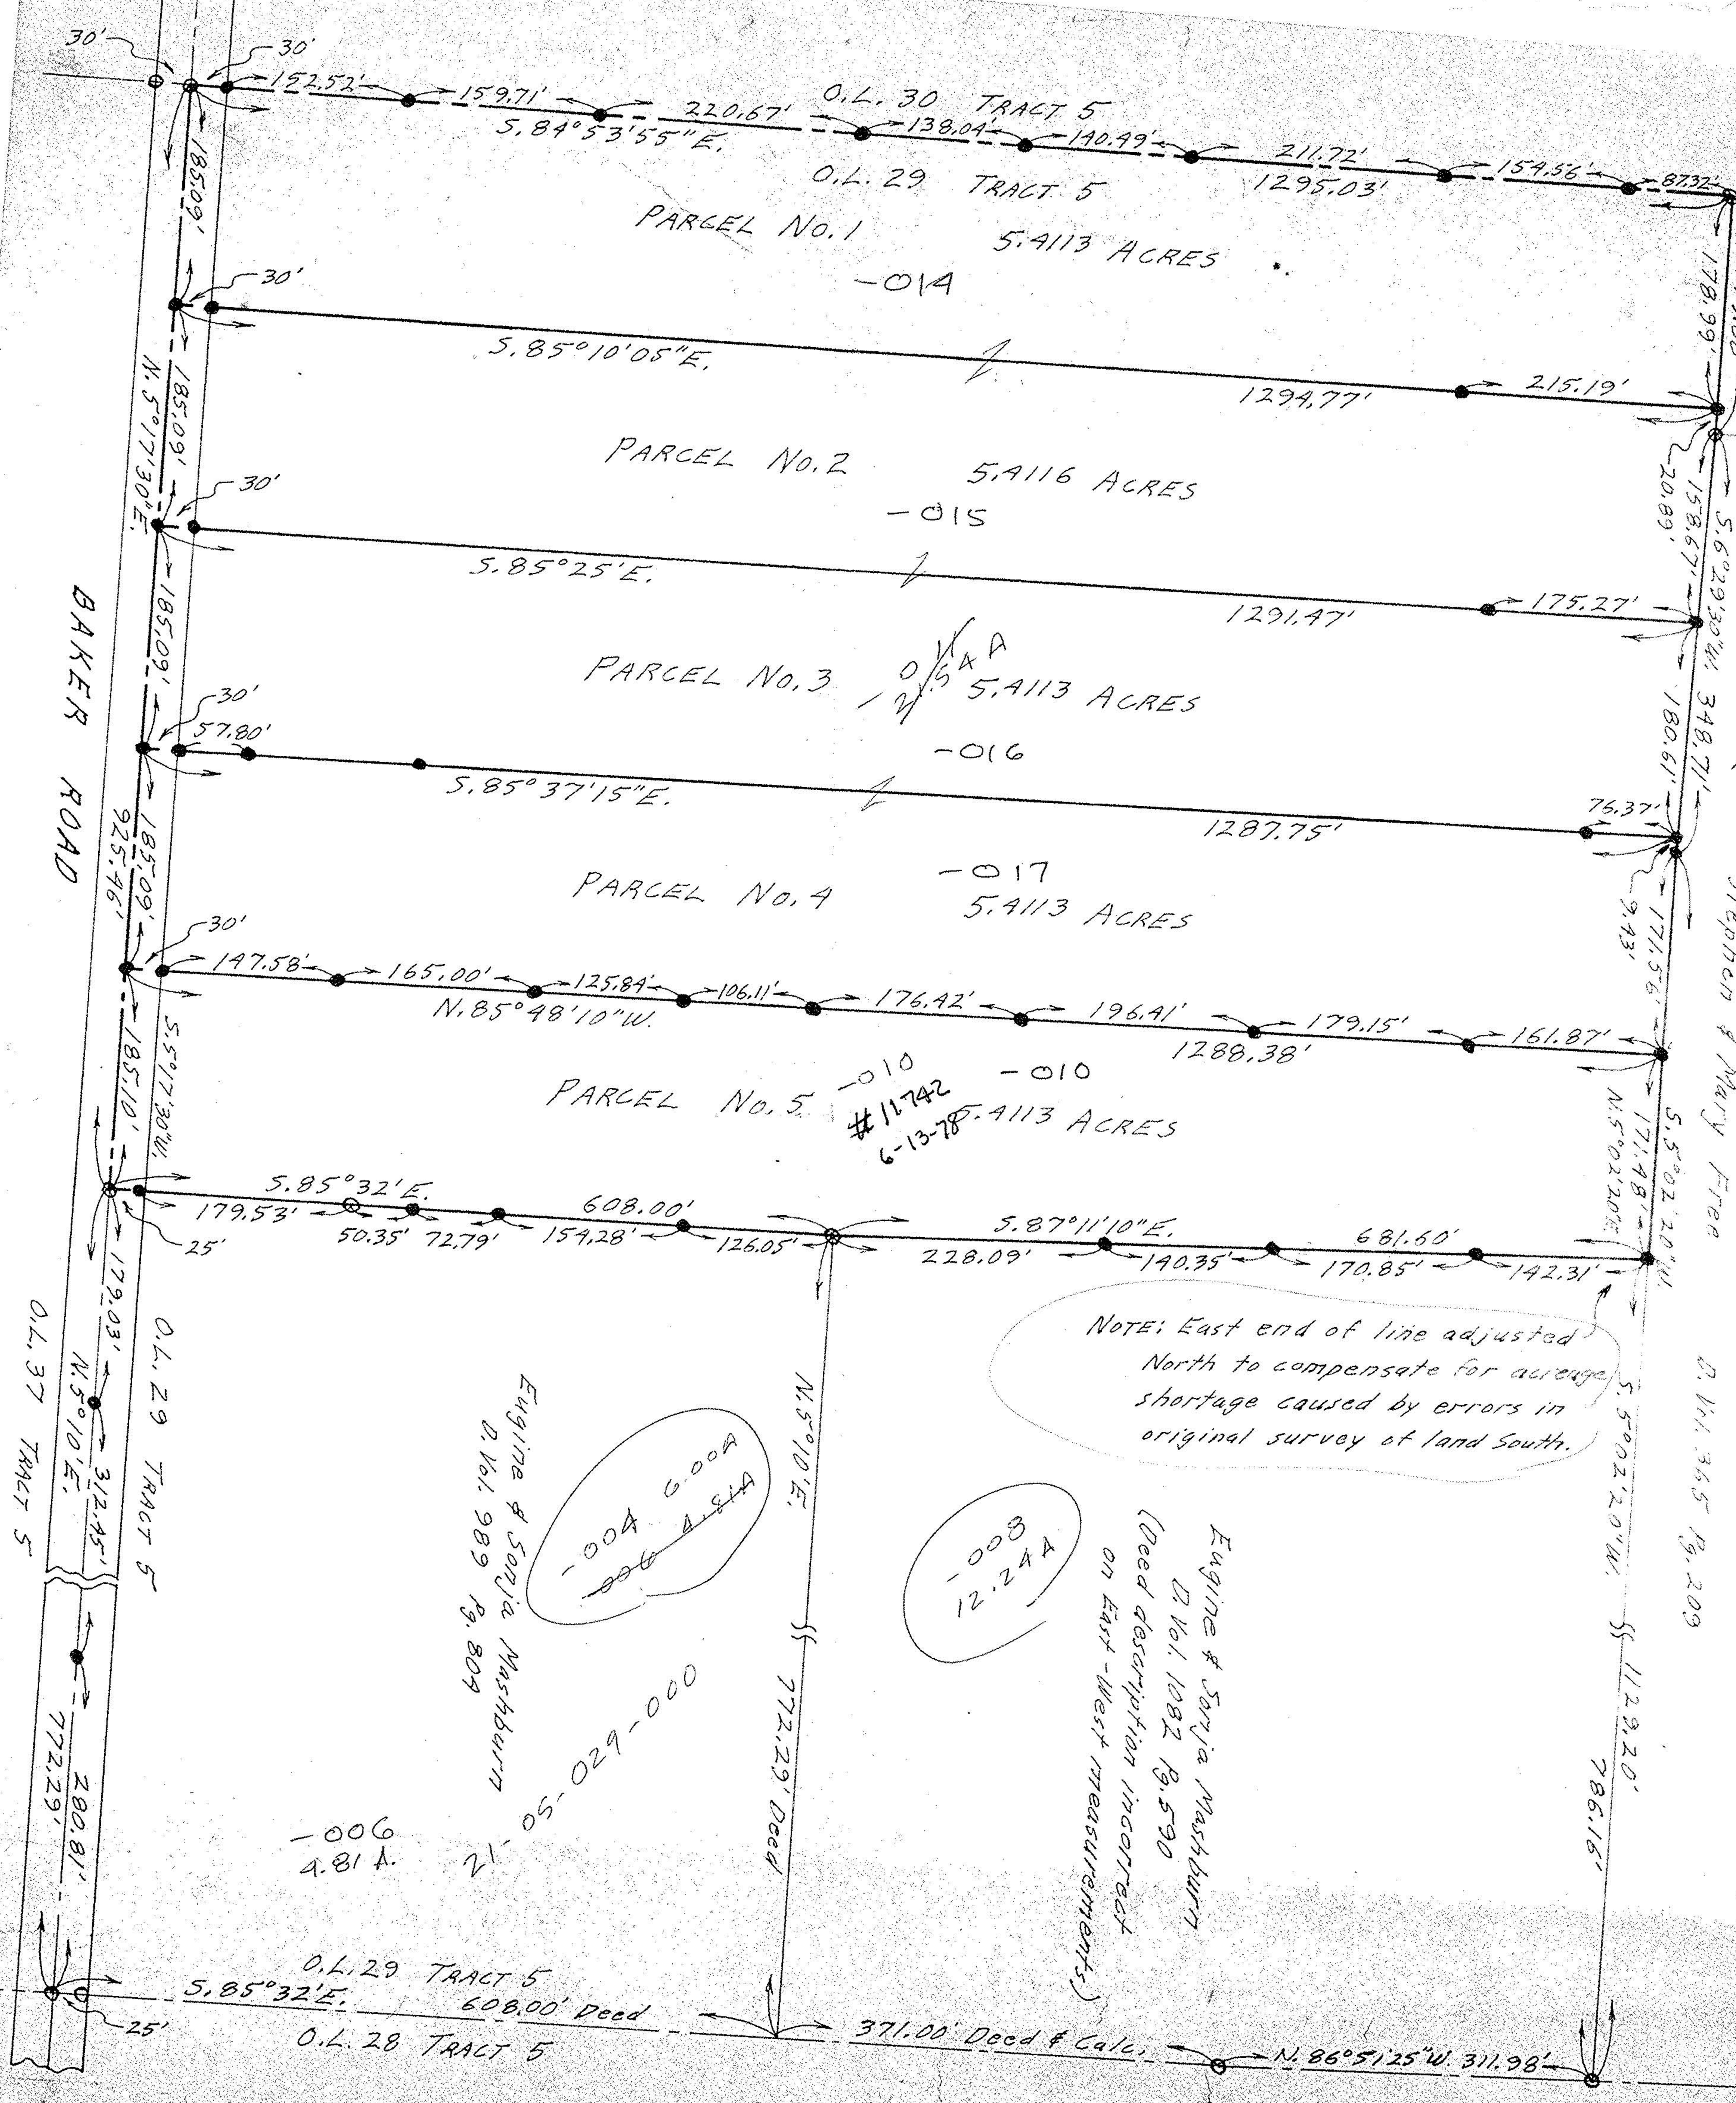

NOTE: East end of line adjusted
North to compensate for average
shortage caused by errors in
original survey of land South.

6.00A

800

Engine & Sorya Mashburn
D. Vol. 989 Pg. 809

Engine & Sorya Mashburn
D. Vol. 1082 Pg. 590
(Deed description incorrect
on East-West measurements)

4.81A
-006

000-029-000

N. 5°10' E.
772.29' Deed

O.L. 29 TRACT 5
5.85°32' E.
608.00' Deed

371.00' Deed & Calc.
N. 86°51'25\"/>