SURVEY
OF
HUNTINGTON TWP.
LOT 38 TRACT 5
AND PART OF
LOT 37 TRACT 5
COUNTY OF LORAIN STATE OF OHIO

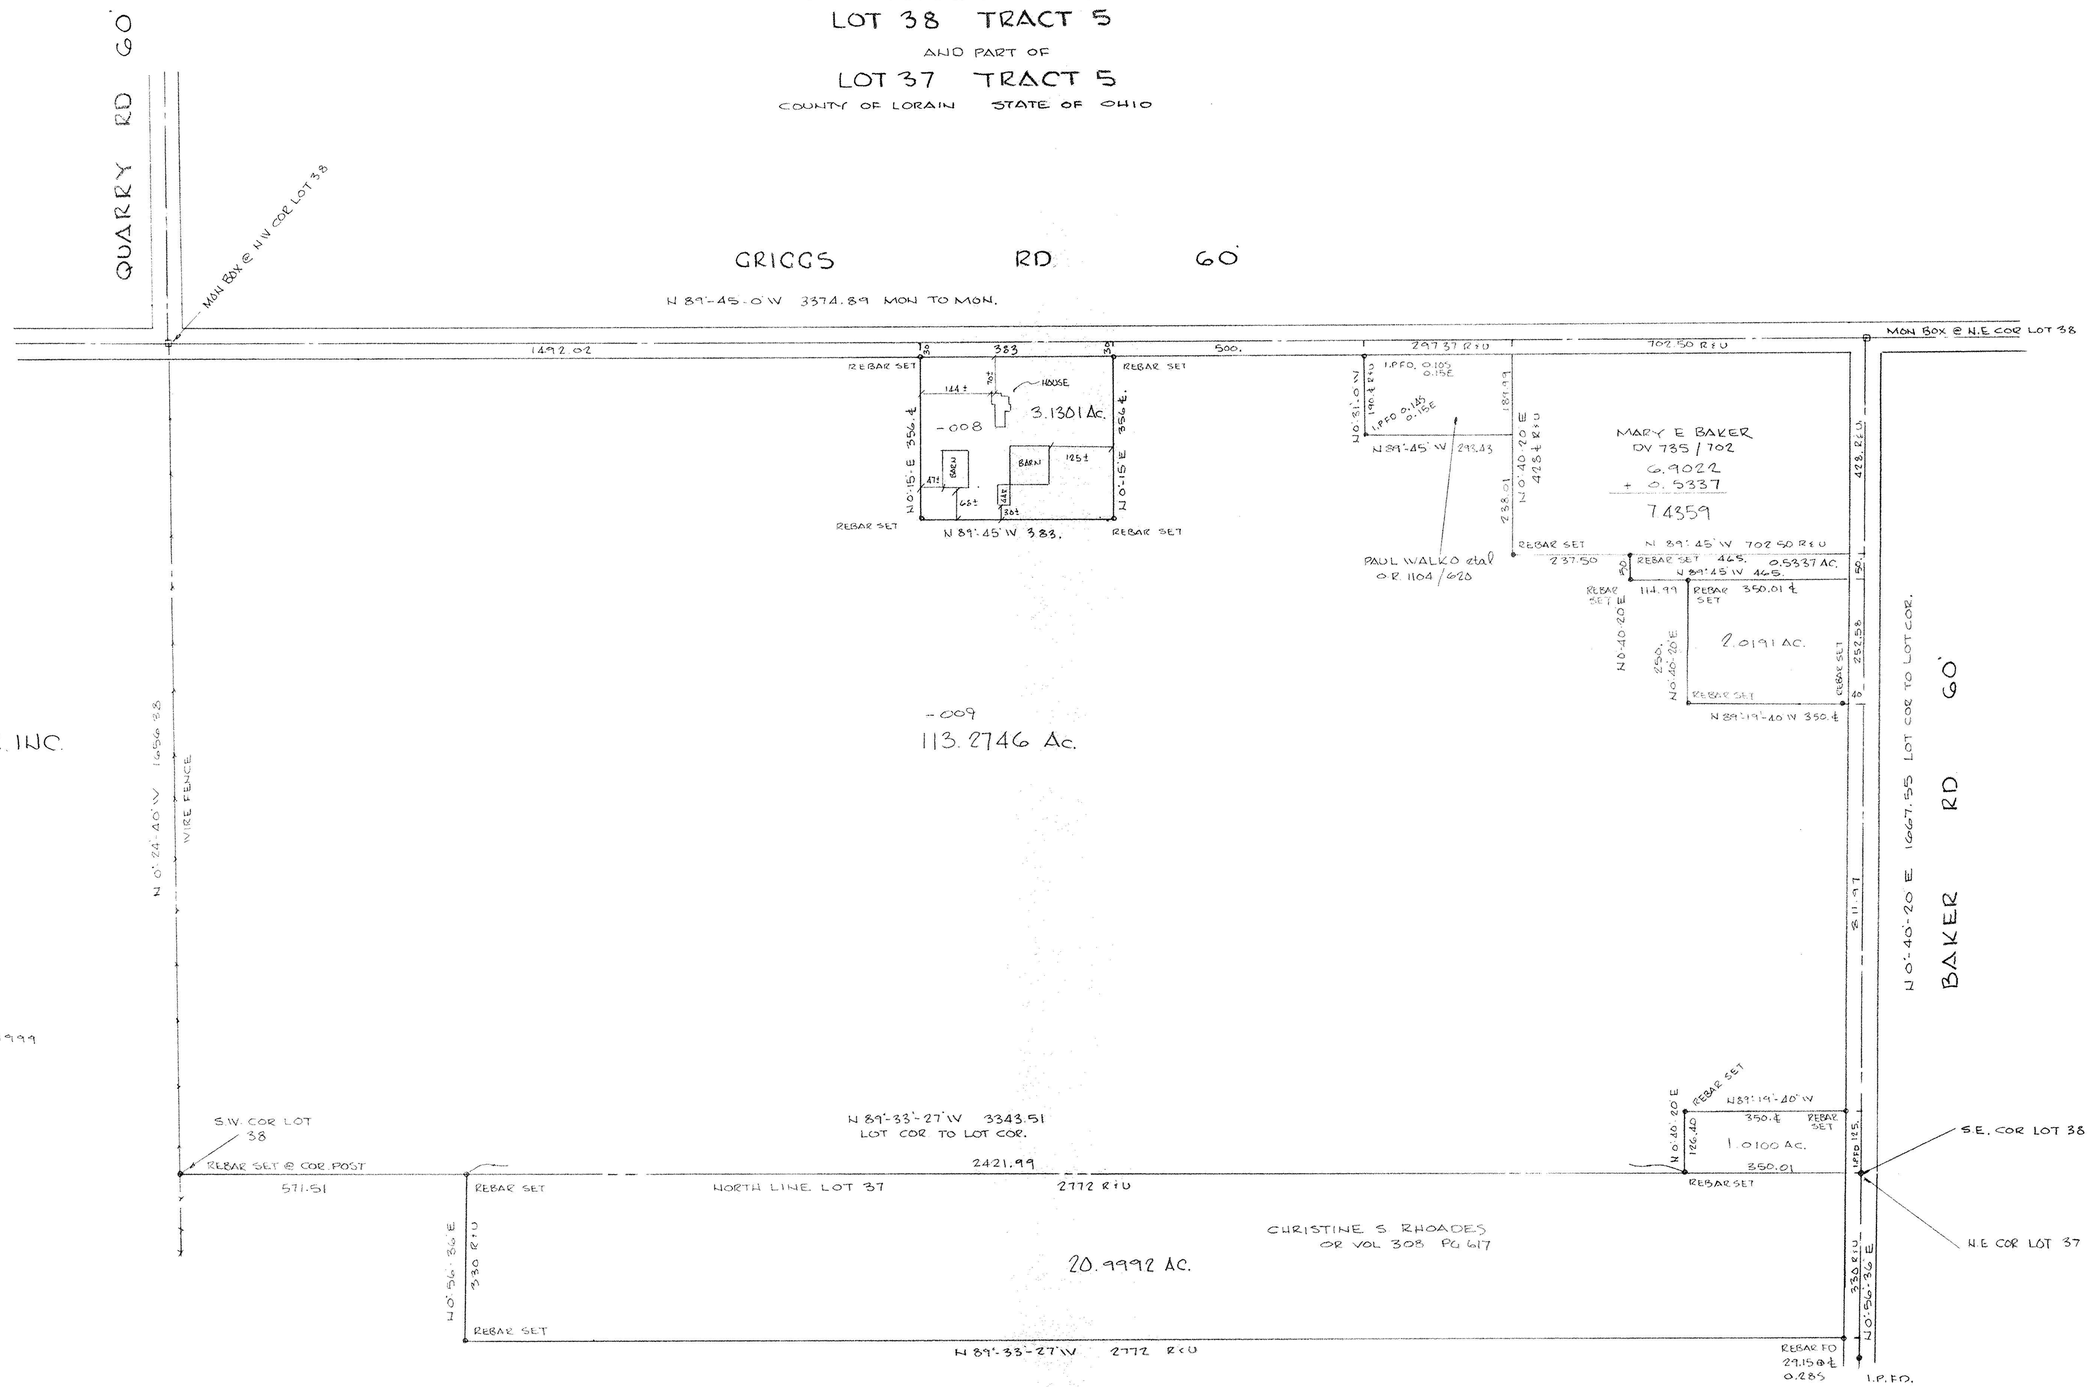

PREPARED FOR:

ZF LAND CO LTD.
48265 GRIGGS RD
WELLINGTON, OH.

PREPARED BY:

HAPONEK & ASSOC. INC.
SURVEYORS
N. RIDGEVILLE, OH.

STATE OF OHIO
DANE A. HAPONEK
5521
REGISTERED SURVEYOR

DATE: APRIL 1999
SCALE 1:150

#00 311

APPROVED LORAIN CO. MAP DEPT
DATE 12-30-99
PAGE 21-A
BY
#00311